

(+) DENOTES LOCATION OF WELL ON UNITED STATES TOPOGRAPHIC MAPS

WELL REFERENCES:
 N01-10E, 345.59' TO NAIL IN 8" APPLE
 N30-30W, 435.93' TO NAIL IN 36" SUGAR

FILE NUMBER: _____
 DRAWING NUMBER: CGCPHL28CHSR.PCS
 SCALE: 1" = 1000'
 MINIMUM DEGREE OF ACCURACY: _____ CENTIMETER
 PROVEN SOURCE OF ELEVATION: DGPS SURVEY
RTK CENTIMETER SYSTEM

I THE UNDERSIGNED, HEREBY STATE THAT THIS PLAT IS CORRECT TO THE BEST OF MY KNOWLEDGE AND BELIEF AND SHOWS ALL THE INFORMATION REQUIRED BY LAW AND THE REGULATIONS ISSUED AND PRESCRIBED BY THE DEPARTMENT OF ENERGY.

(SIGNED) _____
 STEPHEN D. LOSH, P.S. #674



STATE OF WEST VIRGINIA
 DIVISION OF ENVIRONMENTAL PROTECTION
 OFFICE OF OIL AND GAS
 #10 MCJUNKIN ROAD
 NITRO, WV 25143-2506

LAND SURVEYING SERVICES
 21 CEDAR LANE, BRIDGEPORT, WV 26330
 PHONE: 304-842-2018 OR 842-5762

DATE: AUGUST 03, 2011
 OPERATORS WELL NO.: PHL28CHS
 API WELL NO. 47-001-03201H
 STATE COUNTY PERMIT

WELL TYPE: OIL GAS LIQUID INJECTION WASTE DISPOSAL CBM
 (IF "GAS") PRODUCTION STORAGE DEEP SHALLOW

LOCATION: ELEVATION 1423' (GROUND) 1412' (AS BUILT) WATERSHED TAYLOR DRAIN
 DISTRICT PLEASANT COUNTY BARBOUR
 QUADRANGLE PHILIPPI LEASE NUMBER SEE ABOVE

SURFACE OWNER ROBERT L. MCBEE ACREAGE 71.41 (19-8.1)
 OIL & GAS ROYALTY OWNER J. MCBEE, ET. AL. LEASE ACREAGE 1,011.98

PROPOSED WORK: DRILL CONVERT DRILL DEEPER REDRILL FRACTURE OR STIMULATE PLUG OFF OLD FORMATION
 PERFORATE NEW FORMATION OTHER PHYSICAL CHANGE (SPECIFY) _____


TARGET FORMATION MARCELLUS ESTIMATED DEPTH TVD = 7,650' TMD = 14,200'

WELL OPERATOR CNX GAS COMPANY LLC DESIGNATED AGENT KENT WRIGHT
 ADDRESS P. O. BOX 1248 JANE LEW, WV 26378 ADDRESS P. O. BOX 1248 JANE LEW, WV 26378

COUNTY NAME
 PERMIT

02/17/2012

1-0326 H

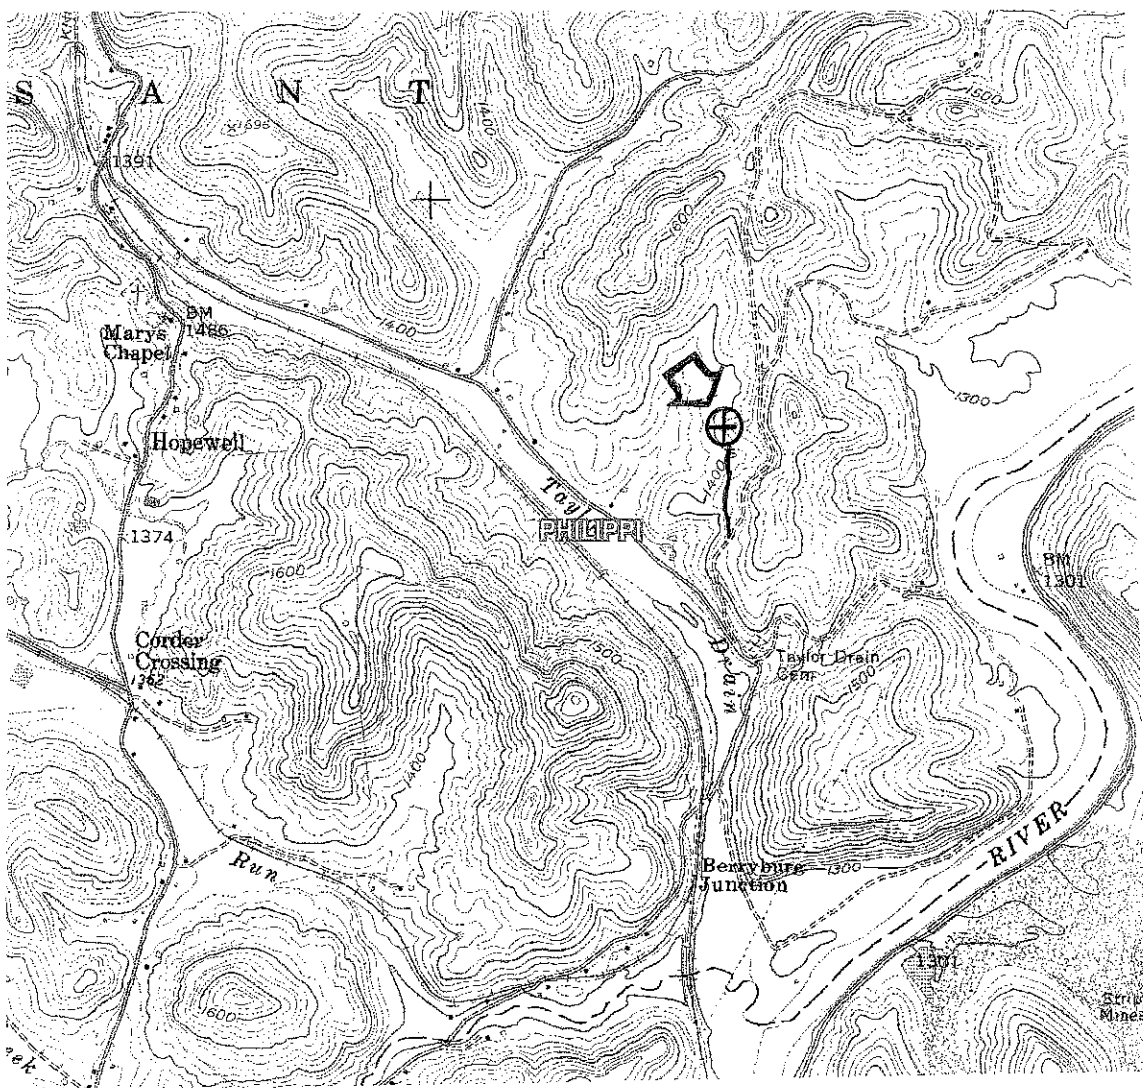

DRAWINGS TO ACCOMPANY FORM WW-9	
CNX GAS COMPANY LLC	
P. O. BOX 1248	
JANE LEW, WV 26378	
WATERSHED:	TAYLOR DRAIN
DISTRICT: PLEASANT	COUNTY: BARBOUR
QUADRANGLE: PHILIPPI	WELL NO.: PHL28CHS
DATE: 08/02/11	PAGE ____ of ____

LAND SURVEYING SERVICES
21 CEDAR LANE
BRIDGEPORT, WV 26330
PHONE: 304-842-2018 OR 5762

02/17/2012