Latitude

2.395 .40w

Topo Location

7.5' Loc.\_ 15' Loc. (calc.)

Company Whooling Stoop Corp

Farm Whooling Steel Corp # 39


15' Quad \_ (sec.)

7.5' Quad Stenbonvillo East

District Coass Gook

WELL LOCATION PLAT

County <u>009</u> Permit <u>39</u>

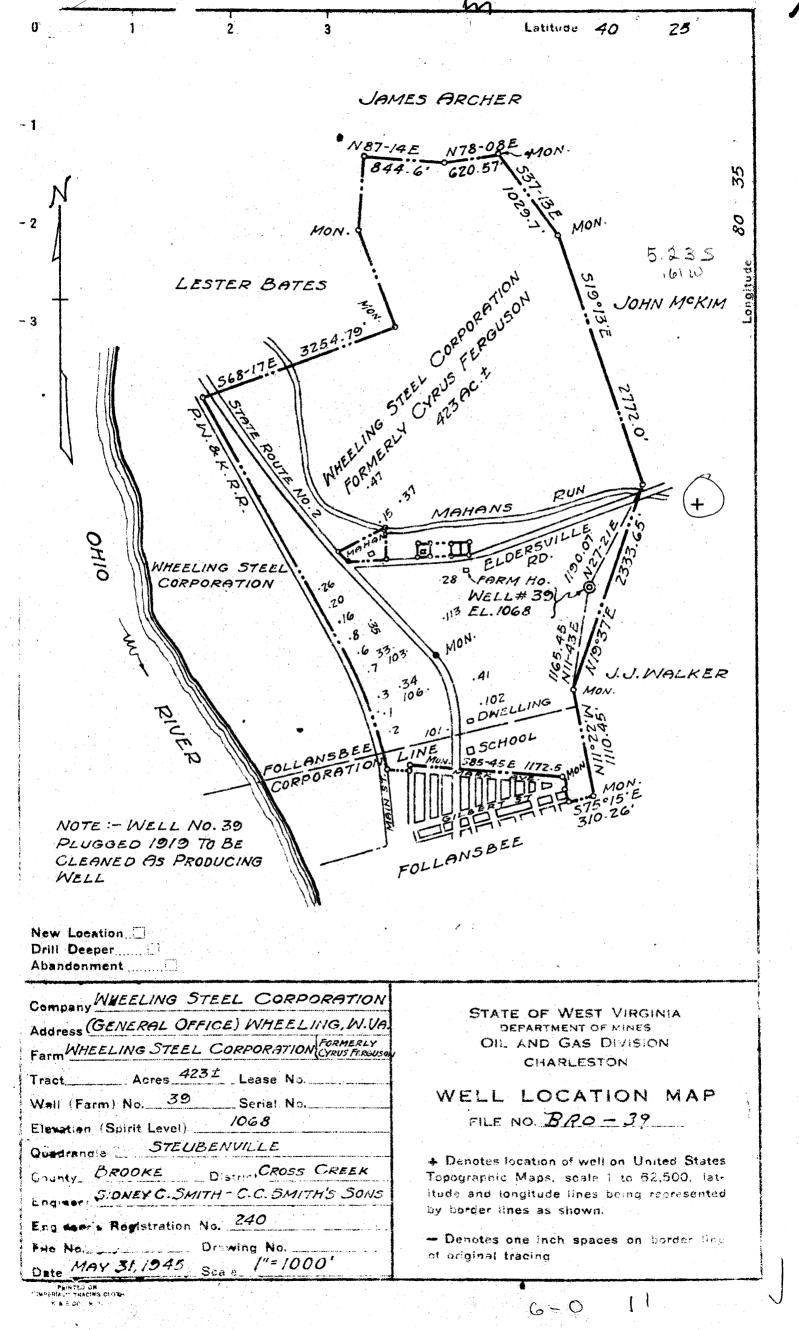

## WEST VIRGINIA DEPARTMENT OF MINES OIL & GAS DIVISION WELL RECORD

Permit No. Bro 39 Steubenville Quad.

Oil Well CASING & TUBING

Company Address Wheeling Steel Corp.

Wheeling, W. Va.

Old Record

Farm

Corporation Acres 423

Location

1 Mi. East of Ohio River

Well No. District

200 10 81 986 764

Surface

39 Elev. 1068 Cross Creek Brooke County 6 5/8 1287

Wheeling Steel Corp., Wheeling, W.Va.

Mineral Commenced -cleaning out Same June 11,1945

No record Packer No record Casing

Completed Not shot

July 11,1945

Volume

No record

Cemented

Rock Pressure

Ħ

Oil Water

This was an old well drilled in 1908 and plugged in 1919 with 764 of 81 casing left in hole. Total depth of well was 1672' with producing sand (Berea) located at 1649 to 1670. (Old records incomplete.) Cleaning out of this well, preparatory to recasing same and putting it in condition for use was started last month and well cleaned out to a depth of 750° to date. At the 750° depth, tools became fouled in the old 8% pipe making it an expensive, if not an impossible, job to take out either the tools or the old casing which has been cut in several places.

Decision has, therefore, been made to abandon this well and plug same.