

71


0 1 2 3 LATITUDE 40° 15'

1 LONGITUDE 80° 25'

2

3 JOHN HARTLEY

HENRY HEINZEROTH

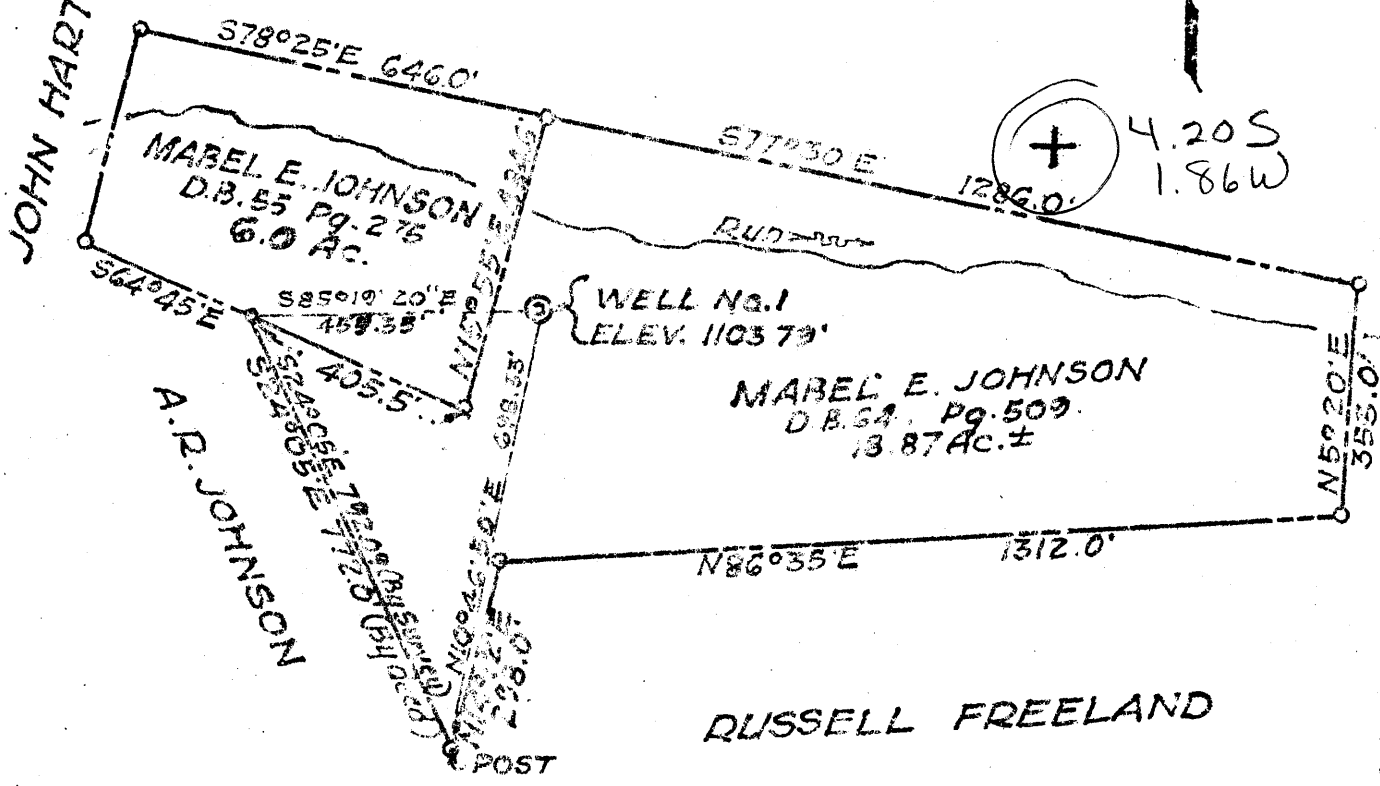

NEW LOCATION
 DRILL DEEPER
 ABANDONMENT

COMPANY J.D.N. MILLER & Co.
 ADDRESS 927 Tyndall St. Pgh. Pa.
 FARM Mabel Johnson
 TRACT 16.87 ACRES LEASE NO. _____
 WELL (FARM) NO. 1 SERIAL NO. _____
 ELEVATION (SPIRIT LEVEL) 1103.79 FT.
 QUADRANGLE Wheeling
 COUNTY Boone DISTRICT Buffalo
 ENGINEER Henry C. Smith
 ENGINEER'S REGISTRATION NO. 240
 FILE NO. _____ DRAWING NO. _____
 DATE Oct 3 1942 SCALE 1" = 300'

STATE OF WEST VIRGINIA
 DEPARTMENT OF MINES
 OIL AND GAS DIVISION
 CHARLESTON

WELL LOCATION MAP

FILE NO. **BRD-55**

+ DENOTES LOCATION OF WELL ON UNITED STATES TOPOGRAPHIC MAPS. SCALE 1 TO 62,500. LATITUDE AND LONGITUDE LINES BEING REPRESENTED BY BORDER LINES AS SHOWN.

- DENOTES ONE INCH SPACES ON BORDER LINE OF ORIGINAL TRACING.

WEST VIRGINIA DEPARTMENT OF MINES
OIL & GAS DIVISION
W E L L R E C O R D

Permit No. Bro-55
Wheeling Quad.

Oil & Gas Well

CASING & TUBING

Company	J. R. N. Miller & Co.			
Address	927 Tyndall St., Pittsburgh, Pa.	8-1/4	349	349
Farm	Mabel E. Johnson Acres 27	6-5/8	1203	1203
Well No. 1	Elev. 1103			
District	Buffalo Brooke County			
Surface	Mabel E. Johnson			
Mineral	Same			
Commenced	11/8/49			
Completed	12/17/49			
Date Shot	12/17 from 1904 to 1912			
	With 100 dynamite			Chal at 250 feet
Volume	9-684 c.f.			
Fresh water	30 feet			
Salt water	1136			

Lime clay	0	20		
Sand	20	35		
Shale	35	60	show of gas 545'	
Lime	60	80		
Shale	80	100		
Lime	100	150	Sandy Lime	1665 1670
Slate	150	155	Broken Lime	1670 1720
Lime	155	165	Shale	1720 1835
Shale	165	215	Sand	1835 1855
Lime	215	230	Shale	1855 1890
Shale	230	245	S. Lime	1890 1917 Berea
Lime	245	250		1890-
Ptt. B. Coal	250	253		1917
Slate	253	255	Lime & Shale	1917 1942 Show gas &
Lime	255	265		Oil
Shale	265	285		1906-1910
Lime	285	290		
Sand	290	300		
Shale	300	310		
Red Rock	310	315		
Lime	315	330		
Shale	330	385		
Sand	385	517		
Shale	517	540		
Sand	540	575		
Shale	575	590		
Pink Rock	590	595		
Lime	595	600		
Red Rock	600	610		
Shale	610	640		
Sand	640	650		
Slate	650	705		
Broken Lime	705	720		
Slate	720	750		
Sand	750	770		
Shale	770	800		
Slate	800	835		
Lime broken	835	870		
Gas Sand	870	900		
Slate	900	920		
Shale	920	940		
Lime	940	950		
Slate	950	960		
Shale	960	975		
Lime	975	980		
Slate	980	1010		
Shale	1010	1035		
Broken Lime	1035	1060		
Sand	1060	1115		
S late	1115	1120		
Sand	1120	1175		
Lime	1175	1185		
Broken Lime	1185	1235		
Sandy Lime	1235	1270		
Big Injun	1270	1570		
Shale	1570	1665		