


40°17'30"

Latitude

80°32'30"

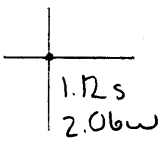

Longitude

Topo Location

7.5' Loc. _____ 15' Loc. _____
 _____ (calc.) _____

Company _____

Farm Wm Talbot #1


15' Quad _____
(sec.)

7.5' Quad Stewbenville East

District Buffalo

WELL LOCATION PLAT

County 009 **Permit** 30009

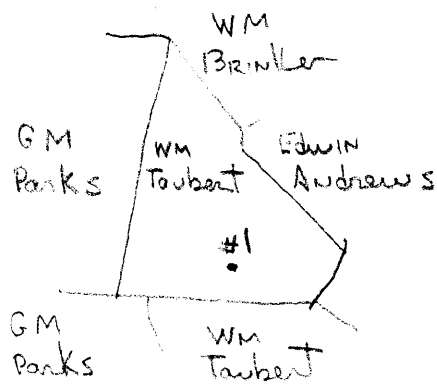

Brook 9-A