


LATITUDE 39° 27' 30"

80° 42' 30"

LONGITUDE

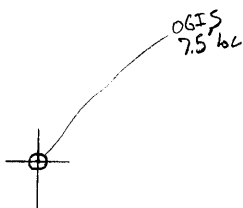

7.5 OGIS topo location

7.5' loc	<u>2.83 S</u>	15' loc	<u>5.91 S</u>
	<u>1.61 W</u>	(calc.)	<u>3.84 W</u>

Company W.A. Gribble

Farm Remington B. White Heirs

Quad Smithburg 7.5' centerpointwc


County Dodd.

District Grant

WELL LOCATION MAP

File No. 017-28

Plat of the proposed location of Well No. 3, of W.D.Gribble of West Union, West Virginia, on the Remington B. White Heirs Farm, consisting of 128 acres, located in West Union District, ^(GRANT) Doddridge County, Doddridge County.

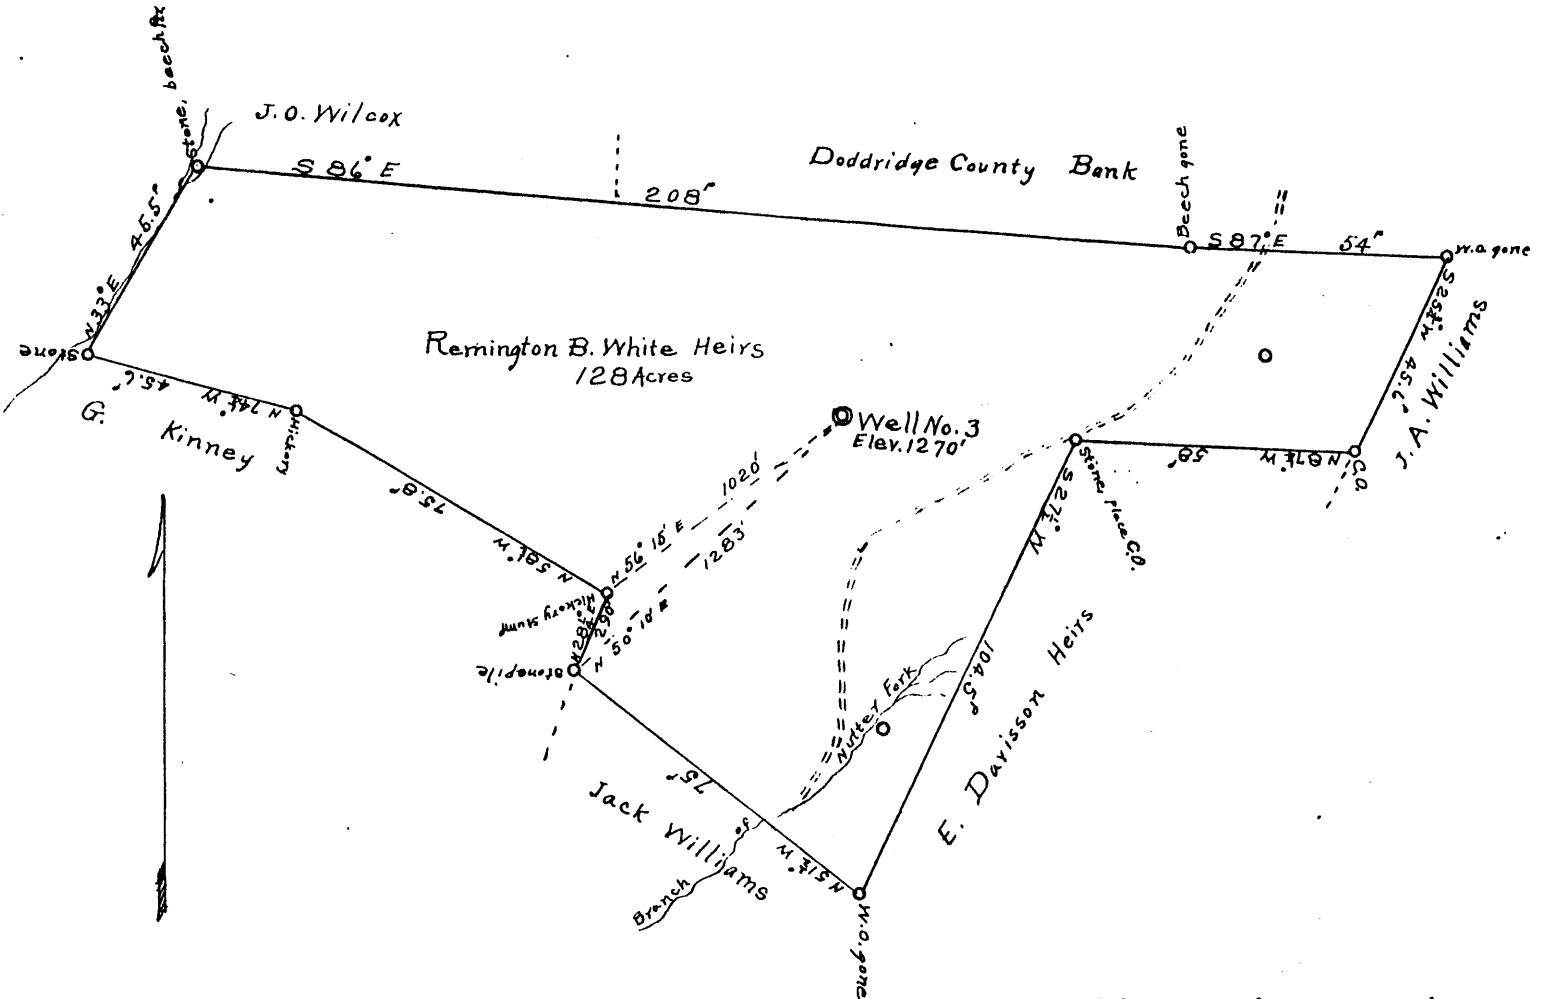

I, the undersigned, hereby certify that this map is correct and shows all the information to the best of my knowledge and belief, required by the oil and gas section of the Mining Laws of West Virginia.

DOD 28

W.D. Gribble

C. C. Freeman

Civil Engineer.

Acknowledged before me, a Notary Public of Harrison County, West Virginia, this the 27th day of August, 1930.

My commission expires 9-18-35

Chas. P. Utter

Notary Public.



STATE OF WEST VIRGINIA
DEPARTMENT OF MINES
Oil and Gas Division
WELL RECORD

Quadrangle
Permit No. 47-017-0028

Rotary _____ Oil _____
Cable X Gas _____
Recycling _____ Comb. _____
Water Flood _____ Storage _____
Disposal _____ (Kind) _____

Company <u>Empire Oil Company</u>	Casing and Tubing	Used in Drilling	Left in Well	Cement fill up Cu. ft. (Sks.)
Address <u>P. O. Box 307, West Union, W. Va.</u>				
Farm <u>White Hrs.</u> Acres <u>128</u>	Size			
Location (waters) _____	20-16			
Well No. <u>Three (3)</u> Elev. <u>1270</u>	Cond.			
District <u>Grant</u> County <u>Doddridge</u>	13-10"			
The surface of tract is owned in fee by <u>REmington</u>	9 5/8			
<u>B. White Heirs</u>	8 5/8			
Address <u>West Union, West Virginia</u>	7			
Mineral rights are owned by <u>Remington</u>	1/2			
<u>B. White</u> Address <u>West Union, West Virginia</u>	4 1/2			
Drilling Commenced <u>1930</u>	3			
Drilling Completed <u>1930</u>	2			
Initial open flow _____ cu. ft. _____ bbls.	Liners Used			
Final production _____ cu. ft. per day _____ bbls.				
Well open _____ hrs. before test _____ RP.				

Attach copy of cementing record.

Coal was encountered at _____ Feet _____ Inches
Fresh water _____ Feet _____ Salt Water _____ Feet
Producing Sand _____ Depth _____

Formation	Color	Hard or Soft	Top Feet	Bottom Feet	Oil, Gas or Water	* Remarks
Native Coal			328	328		
Pittsburgh Coal			None			
Little Dunkard			1270	1217?		
Big Dunkard			1283	1304		1207 2 Bbls. per hr.
Pink Rock			1360			
Gas Sand			1430	1480		
1st Salt Sand			1615	1734		
Break			1734	1740		
Sand			1740	1748		
2nd Salt Sand			1823	1928		
Maxon			1950	1985		
Little Lime			2089	2107		
Pencil Cafe			2124	2126		
Big Lime			2126	2182		
Big Injun			2128	2305		
Squaw			2331	2347		Show of Oil 2207, 1/2 bbl.
gantz			2460	2586		Per day. Gas 2.225 3/10
50 ft.			2678	2693		W. 2" 73Mc
Gordon Stray			2904	2916		2912 pay from 2904-2912
Gordon			2921	2925		6/10 Water 2" 103Mc
Total Depth				2930		

* Indicates Electric Log tops in the remarks section.

(over)