

LATITUDE

39 25

07 08

LONGITUDE

→ 7.5' loc
k/a 4/28/92

7.5 OGIS topo location

7.5' loc	<u>0.915</u>	15' loc	<u>0.000</u>
	<u>2.22w</u>	(calc.)	<u>2.03w</u>

Company _____

Farm _____

Quad Centerpoint Wc

County _____

District McClellan

WELL LOCATION MAP

File No. Dodd, 54

W.D. Gribble Company

COMPLETION DATA SHEET

West Union, W. Va. Address

No. 2

WELL NO. 2

FARM Martha J. Smith Et al. FORMATION RECORD

DOS-5, d/

Name	Color	Character	Oil, Gas or Water	Top	Bottom	Thickness	Total Depth	Remarks
Conductor						16		
Native Coal				288	289			
Sand & Water				422	440			2 Bailers in 5 hrs.
Hard Lime				513	760			
Pitts. Coal				760	761			
Red Rock				997	1040			
Hard Lime				1180	1200			
Little Dunkard				1205	1228			
Sandy Shells				1250	1500			
1st Salt Sand				1520	1562			
2nd Salt Sand			Water	1570	1733			4 Bailers per hr.
Little Lime				1970	2004			
Pencil Cave				2004	2010			
Blue Monday				2010	2035			
Big Lime				2035	2082			
Big Injun			Gas	2082	2248			2111 - 2121
			Oil, Water					2172 - 2192
Squaw Sand				2255	2260			
Gantz			Gas	2350	2550			Show at 2520
Fifty Ft. Sand				2610	2640			
Thirty Ft. Sand				2715	2725			
Gordon Stary			Gas	2810	2844			2829 to 2844
Gordon				2851	2860		2860	

Well was ~~not~~ shot at 2171 to 2191 feet; well was shot at 2812 to 2842 feet.


~~XXXX~~ Fresh water at 422 to 440 feet; ~~XXXX~~ salt water at 1570 to 1733 feet.

Well was ~~not~~ producing hole.

July 31, 1935 Date

Approved W.D. Gribble Owner

NOTE: All bottom formations must be noted as indicated above and all key-rocks and oil and gas sands must be recorded under their proper geological names in the district as well as any local names commonly used in the district for such strata.

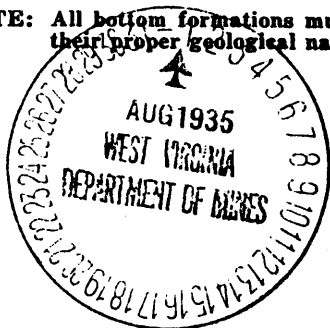

WEST VIRGINIA DEPARTMENT OF MINES

OIL AND GAS DIVISION

PRELIMINARY DATA SHEET NO. 1

File No. Dod-54

Well No. 2

W.D. Gribble Company of West Union, W. Va.

on the Martha J. Smith, et al Farm

containing 124 acres. Location on waters of Elk Lick

McClellan District, in Doddridge County, West Virginia

The surface of the above tract is owned in fee by Arlie Dotson

of Clarksburg, W. Va. address, and the mineral rights are owned by

Martha J. Smith of West Union, W. Va.

The oil and gas privileges are held under lease by the above named company, and this well is drilled under permit No. Dod-54 issued by the West Virginia Department of Mines, Oil and Gas Division

August 14, 1935

Elevation of surface at top of well, 1035 ft. Spirit Barometric.

The number of feet of the different sized casings used in the well.

16 feet size. Wood conductor.

566 feet 10" size, csg. feet sized csg.

1262 feet 8 1/2" size, csg. feet sized csg.

2072 feet 6 5/8" size, csg. feet sized csg.

_____ packer of _____ size, set at _____

_____ packer of _____ size, set at _____

_____, in casing perforated at _____ feet to _____ feet.

_____, in casing perforated at _____ feet to _____ feet.

Coal was encountered at 288 feet, thick ness 12 inches, and at 760

feet; thickness 12 inches; and at _____ feet; thickness _____ inches.

Liners were used as follows: (Give details) _____

July 31, 1935 Date.

Approved W.D. Gribble, Owner.

By _____

(TYPE)

