


0 1 2 3

1

2

3

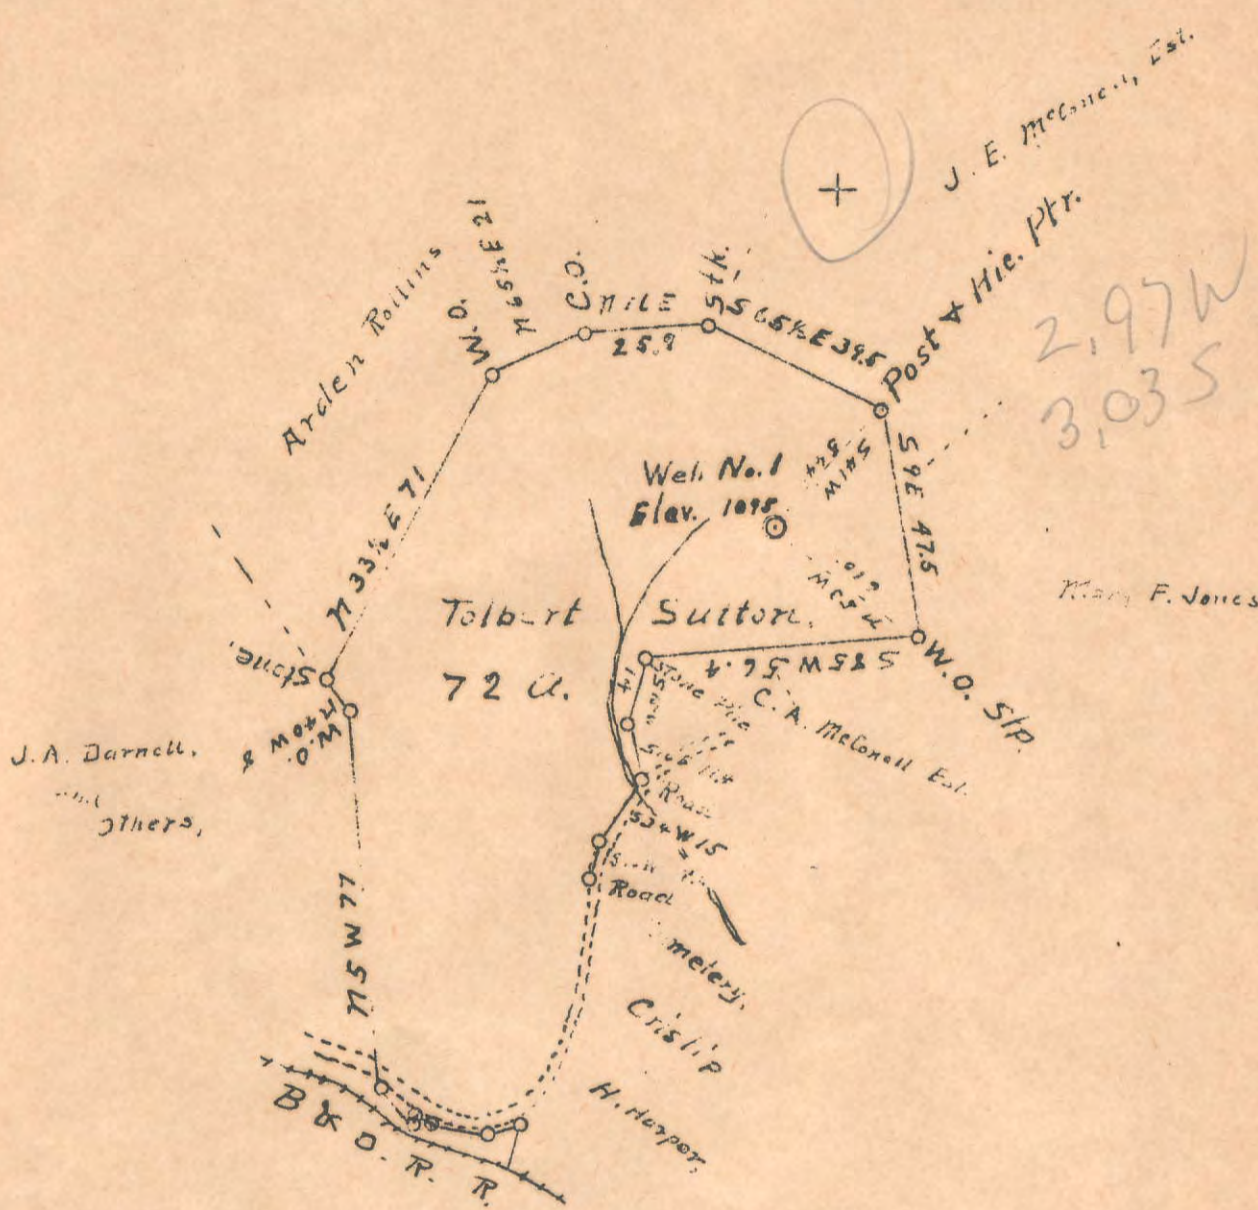

New Location  X  
 Drill Deeper   
 Abandonment

Company Ed Tate & W. D. Gribble  
 Address West Union, W. Va.  
 Farm Tolbert Sutton  
 Tract One Acres 72 Lease No. \_\_\_\_\_  
 Well (Farm) No. 1 Serial No. \_\_\_\_\_  
 Elevation (Spirit Level) 1095  
 Quadrangle Centerpoint SW  
 County Doddridge District West Union  
 Engineer J. M. Martin  
 Engineer's Registration No. 24  
 File No. \_\_\_\_\_ Drawing No. \_\_\_\_\_  
 Date July 28 1933 Scale 40 P = 1"

STATE OF WEST VIRGINIA  
 DEPARTMENT OF MINES  
 OIL AND GAS DIVISION  
 CHARLESTON

WELL LOCATION MAP  
 FILE NO. DOD-140

+ Denotes location of well on United States Topographic Maps, scale 1 to 62,500, latitude and longitude lines being represented by border lines as shown.  
 - Denotes one inch spaces on border line of original tracing.

WEST VIRGINIA DEPARTMENT OF MINES  
OIL & GAS DIVISION  
W E L L R E C O R D

Permit No. Dod 140  
Centerpoint Quad.  
Company  
Address  
Farm  
Location  
Well No  
District  
Surface  
Mineral  
Commenced  
Completed  
Date shot

Ed Tate & W. D. Gribble  
West Union, W.Va.  
T. Sutton Acres 74  
Buckeye  
1 Elev. 1095  
West Union, Doddridge County  
T. Sutton, Smithburg, W.Va.  
T. Sutton & Parrill Hrs.  
Oct 21, 1943  
Dec. 20, 1943  
Dec. 26 Depth 2472 to 2506  
with 200# Gelatin 100%  
36/10ths W in 1 1/2"  
350 lbs. 24 hrs.

Gas Well  
CASING & TUBING

	10	323			
	8 1/2	953			
	6 5/8	1718	1718		

Open flow  
Rock Pressure

Nat. Coal - Blossom	S	130	134	
Lime Wh	H	380	405	
Shells	H	405	520	
R. Rock R	S	520	560	
Shells	H	560	614	
R. Rock	S	614	634	
Shells Bk	H	634	825	
Lime Wh	H	825	865	
Shells Bk	H	865	935	
L. Dunkard Gr	S	935	960	
Slate Bk	S	960	963	
Gas Sand Wh	H	963	991	
Slate Bk	S	991	1020	
1st Salt Wh	S	1020	1045	
Slate Bk	S	1045	1049	
Sand Gr	S	1049	1110	
Slate Bk	S	1110	1128	
Sand Gr	S	1128	1158	
Shells Bk	H	1158	1200	
2nd Salt Gr	S	1200	1288	
Slate Bk	S	1288	1326	
Sand	S	1326	1343	
Shells Bk	H	1343	1400	
3rd Salt Gr	H	1400	1530	Gas 1448-1526
Shells Bk	H	1530	1638	
Maxon Sand Dk	H	1638	1668	Oil 1645 Show
Shells Gr	H	1668	1677	
L. Lime Dk	H	1677	1695	
Slate Bk	S	1695	1710	
Pencil Cave Bk	S	1710	1718	
B. Monday Dk	H	1718	1738	Gas 1724
Big Lime Gr	H	1738	1803	
Injun Sand Gr	H	1803	1911	Gas 1827-1846
Slate Bk	S	1911	1918	
Squaw Dk	H	1918	1928	
Shells Dk	H	1928	2035	
Sand Gr	H	2035	2065	
Shells Dk	H	2065	2080	
Gantz Sand Dk	H	2080	2105	
Shells Dk	H	2105	2215	
G. Stray Gr	H	2215	2475	
Slate Bk	S	2475	2495	Gas 2475-2483
Gordon Gr	H	2495	2499	
Slate Bk	S	2499	2505	Gas 2499-2503
Slate Bk	S	2505	2541	
TOTAL DEPTH			2541	

1738  
 1530  
 1400  
 1095  
 1718