

New Location   
 Drill Deeper   
 Abandonment

512 W 10 Map 26 N.

Company South Penn Natural Gas Co.  
 Address Parkersburg, W. Va.  
 Farm Lewis Maxwell  
 Tract \_\_\_\_\_ Acres 78 Lease No. 80796  
 Well (Farm) No. 2 Serial No. \_\_\_\_\_  
 Elevation (Spirit Level) 1014.30  
 Quadrangle West Union SE  
 County Doddridge District West Union  
 Engineer Emmon Haines  
 Engineer's Registration No. \_\_\_\_\_  
 File No. \_\_\_\_\_ Drawing No. \_\_\_\_\_  
 Date 7-6-44 Scale 1" = 400'

STATE OF WEST VIRGINIA  
 DEPARTMENT OF MINES  
 OIL AND GAS DIVISION  
 CHARLESTON

WELL LOCATION MAP  
 FILE NO. DOD-149

+ Denotes location of well on United States Topographic Maps, scale 1 to 62,500, latitude and longitude lines being represented by border lines as shown.

- Denotes one inch spaces on border line of original tracing.



375

STATE OF WEST VIRGINIA  
DEPARTMENT OF MINES  
OIL AND GAS DIVISION  
DRILLING DEEPER  
WELL RECORD

Permit No. DOD-149


Oil or Gas Well DRY  
(KIND)

Company South Penn Natural Gas Company  
 Address Union Trust Bldg. Parkersburg, W. Va.  
 Farm Lewis Maxwell Acres 78  
 Location (waters) Prichards Run  
 Well No. 2 - D.D. Elev. 1014.30  
 District West Union County Doddridge  
 The surface of tract is owned in fee by Howard Maxwell et al.  
R. D. No. 1, Address West Union, W. Va.  
 Mineral rights are owned by Lewis Maxwell Hrs. et al.  
West Union Bank, Address West Union, W. Va.  
 Spc. Rec. Aug 12, 1944 D.D. -----  
 Drilling commenced -----  
 Drilling completed D.D. Aug. 11, 1944.  
 Date Shot --- From --- To ---  
 With -----  
 Open Flow --- /10ths Water in --- Inch  
--- /10ths Merc. in --- Inch  
 Volume --- Cu. Ft.  
 Rock Pressure ----- lbs. --- hrs.  
 Oil ----- bbls., 1st 24 hrs.  
 Fresh water --- feet --- feet  
 Salt water --- feet --- feet

Casing and Tubing	Used in Drilling	Left in Well	Packers
Size			
16			Kind of Packer <u>---</u>
13			<u>---</u>
10	<u>469'</u>		Size of <u>---</u>
8 1/4	<u>1049'</u>		<u>---</u>
6 3/8	<u>1900'</u>		Depth set. <u>---</u>
5 3/16			<u>---</u>
3			Perf. top <u>---</u>
2			Perf. bottom <u>---</u>
Liners Used			Perf. top <u>---</u>
			Perf. bottom <u>---</u>

CASING CEMENTED --- SIZE --- No. Ft. --- Date ---  
 COAL WAS ENCOUNTERED AT --- FEET --- INCHES  
--- FEET --- INCHES --- FEET --- INCHES  
--- FEET --- INCHES --- FEET --- INCHES

Formation	Color	Hard or Soft	Top	Bottom	Oil, Gas or Water	Depth Found	Remarks
<b>DRILLING DEEPER:</b>							
Commenced drilling				2029			
Gantz Sand			2186	2248			
Thirty Foot Sand			2425	2450			
Gordon Stray Sand			2586	2598			
Gordon Sand			2613	2618			
Total Depth				2648			

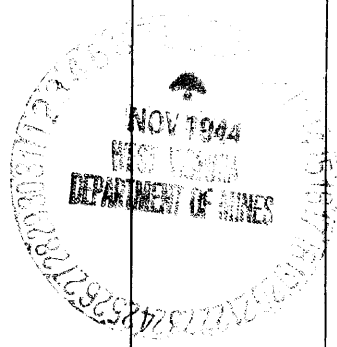

Formation	Color	Hard or Soft	Top	Bottom	Oil, Gas or Water	Depth Found	Remarks

Date **Nov. 8, 1944.**, 194

APPROVED **SOUTH PENN NATURAL GAS COMPANY**, Owner

By *Oliver E. Young* Land Agent  
(Title)