


39° 20' ?

Longitude 80 40

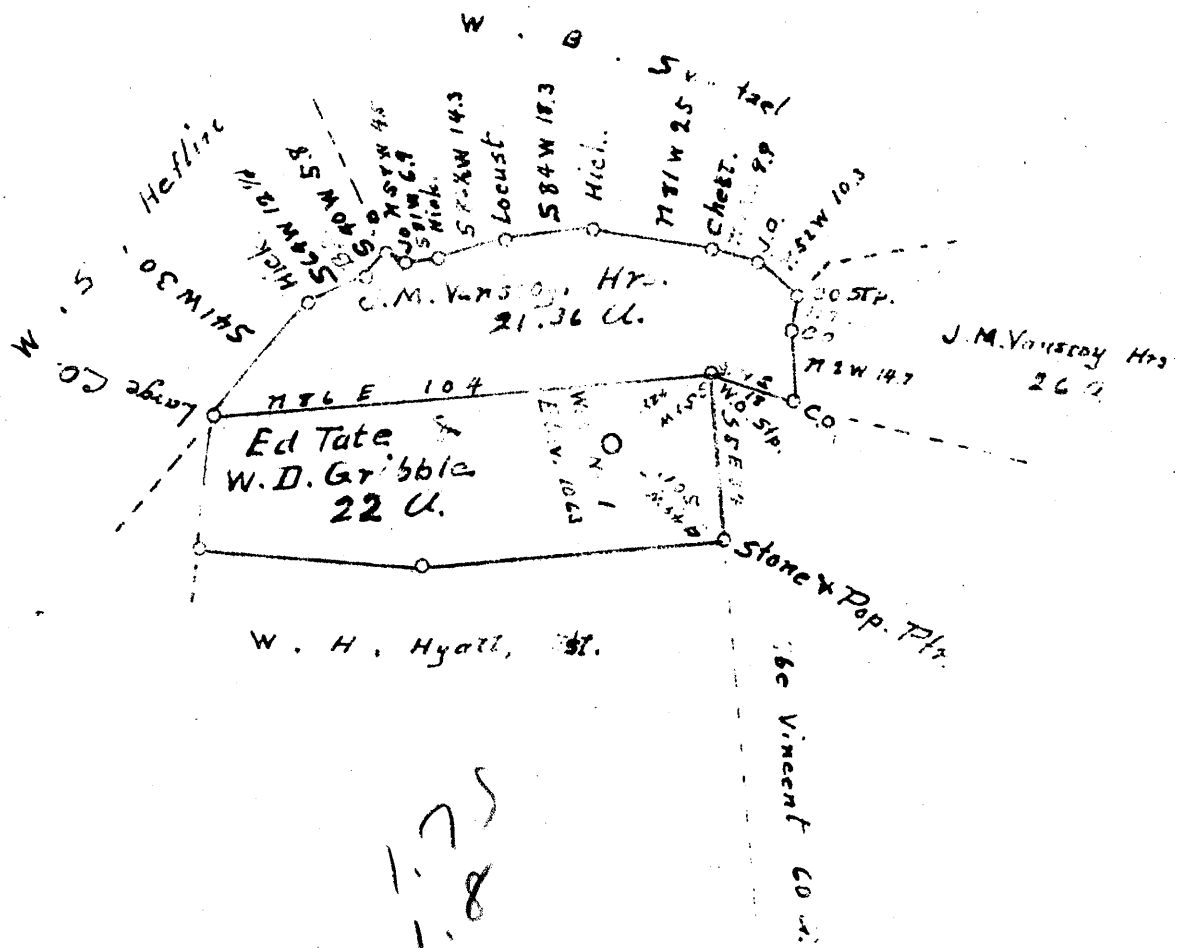

1-8

New Location X  
 Drill Deeper  
 Abandonment

Company Ed Tate & W.D. Gribble  
 Address West Union, W. Va.  
 Farm Tate, Gribble & Van Scoy  
 Tract 22 Acres 43.46 Lease No. \_\_\_\_\_  
 Well (Farm) No. 1 Serial No. \_\_\_\_\_  
 Elevation (Spirit Level) 1750  
 Quadrangle Centerpoint SW  
 County Loddrige District West Union  
 Engineer J. M. Marlin  
 Engineer's Registration No. 84  
 File No. \_\_\_\_\_ Drawing No. \_\_\_\_\_  
 Date Aug 23 1928 Scale 40 Poles = 1"

STATE OF WEST VIRGINIA  
 DEPARTMENT OF MINES  
 OIL AND GAS DIVISION  
 CHARLESTON

WELL LOCATION MAP  
 FILE NO. DOD-150

+ Denotes location of well on United States Topographic Maps, scale 1 to 62,500, latitude and longitude lines being represented by border lines as shown.

- Denotes one inch spaces on border line of original tracing

6639

WEST VIRGINIA DEPARTMENT OF MINES  
OIL & GAS DIVISION  
W E L L R E C O R D

Permit No. Dod 150  
Centerpoint Quad.  
Company  
Address  
Farm  
Location  
Well No  
District  
Surface  
Mineral

Gas Well  
CASING & TUBING

Ed Tate & W. D. Gribble  
West Union, W.Va. 10 378  
Vanscoy, Tate & Gribble A- 8 1/4 1051 378  
Englands Run 6 5/8 1591 1591  
1 Elev. 1063  
West Union Doddridge County  
Vanscoy Hrs. & C. T. Hyatt, Smithburg  
Vanscoy Hrs. & Ed. Tate & W. D. Gribble  
West Union,  
Sept. 7, 1944  
Oct. 27, 1944  
Oct. 28-29 Depth 2010-2020; 1710-1718  
32/10ths W in 1 1/4  
66,000 C F.  
300 lbs. 24 hrs.  
40 ' 4 blrs.  
1282' 4 blrs.

Soil				15	
Lime	Dk	H	15	50	
Slate-Shell	Dk	H	50	278	
Sand	Lt	S	278	378	
Slate	Dk	S	378	390	
Lime	Dk	H	390	415	
Slate-Shell	Dk	H	415	500	
Lime	Dk	H	500	521	
Slate-Shell	Dk	H	521	568	
Sand	Wh	S	568	590	
Lime	Dk	H	590	628	
Red Rock		S	628	678	
Slate-Shell	Dk	H	678	752	
Red Rock		S	752	783	
Slate-Shell	Lt	S	783	850	
Lime	Lt	H	850	873	
Pink Rock		S	873	900	
Slate-Shell	Wh	S	900	920	
L. Dunkard	Wh	H	920	940	
Slate-Shell	Dk	H	940	1048	
B. Dunkard	Dk	H	1048	1065	
Slate-Shell	Dk	S	1065	1094	
Gas Sand	Dk	H	1094	1138	
Slate-Shell	Dk	H	1138	1164	
1st Salt Sand	Wh	S	1164	1255	
Slate-Shell	Dk	S	1255	1273	
2nd Salt Sand	Wh	H	1273	1451	
Slate	Dk	S	1451	1454	
Sand	Wh	H	1454	1477	
Slate-Shell	Dk	S	1477	1515	
3rd Salt Sand	Dk	H	1515	1577	
Slate	Dk	S	1577	1580	
Sand	Wh	H	1580	1650	
Slate-Shell	Dk	H	1650	1710	
Maxon Sand	Wh	H	1710	1756	Gas 1710-15
Slate-Shell	Dk	H	1756	1811	
L. Lime	Dk	H	1811	1833	
Slate	Dk	S	1833	1838	
Blue Monday	Dk	H	1838	1882	
Big Lime	Wh	H	1882	1956	
Big Injun	Dk	H	1956	2035	Gas 2012-17
Slate-Shell	Dk	H	2035	2096	TOTAL DEPTH