


2.755
2.124

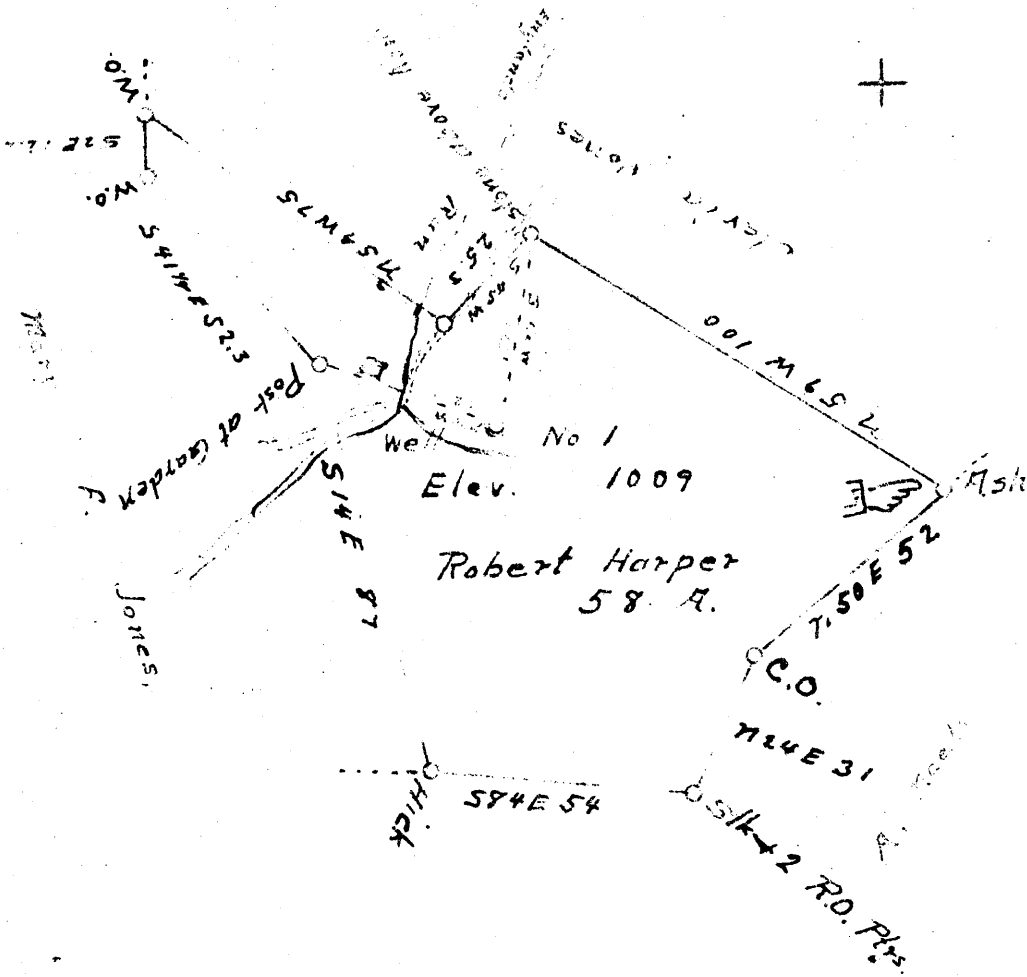

New Location
 Drill Deeper
 Abandonment

Company Ed Tate & W.D. Gribble
 Address West Union, W. Va.
 Farm Robert Harper,
 Tract one Acres 58 Lease No.
 Well (Farm) No. 1 Serial No.
 Elevation (Spirit Level) 1009
 Quadrangle Centerpoint, SW
 County Doddridge District West Union,
 Engineer J. M. ...
 Engineer's Registration No.
 File No. Drawing No.
 Date Dec. 11, 1945 Scale 40 Feet = 1 inch

STATE OF WEST VIRGINIA
 DEPARTMENT OF MINES
 OIL AND GAS DIVISION
 CHARLESTON

WELL LOCATION MAP
 FILE NO. DOD-153

+ Denotes location of well on United States Topographic Maps, scale 1 to 62,500, latitude and longitude lines being represented by border lines as shown

- Denotes one inch spaces or words of original tracing

WEST VIRGINIA DEPARTMENT OF MINES
OIL & GAS DIVISION
W E L L R E C O R D

Permit No. Dod 153
Centerpoint Quad.
Company
Address
Farm
Location
Well No.
District
Surface
Mineral
Commenced
Completed
Date shot

Ed Tate & W.D. Gribble
West Union, W.Va.
Robert Harper Acres 58
Englands Run
1 Elev. 1009
West Union Doddridge County
Robert Harper, Smithburg, W.Va.
Same
Feb. 24, 1945
April 18, 1945
April 20, 1770 to 1778
1800 to 1823 50# 90% Gel.

Gas Well
CASING & TUBING

10	308	None
8 1/2	875	"
6 5/8	1420	1420

Open flow 40/10ths M in 1 1/4"
Volume 274
Rock Pressure Not taken
Salt Water 1130; 1300

Coal	Dk	S	73	75
Red Rock		S	75	93
Lime	Wh	H	93	125
Red Rock		S	125	130
Shale	Gr	S	130	207
Sand	Lt	H	207	269
Shale	Gr	S	269	345
Lime	Wh	H	345	363
Slate Shells	Dk	H	363	400
Lime	Lt	H	400	414
Slate Shell	Dk	H	414	470
Red Rock		S	470	510
Slate Shell	Dk	H	510	545
Red Rock		S	545	562
Lime	Dk	H	562	600
Red Rock		S	600	725
Slate Shell	Dk	H	725	1030
1st Salt Sand	Lt	H	1030	1070
Lime Shells	Dk	H	1070	1115
2nd Salt Sand	Lt	H	1115	1150
Lime		Dk H	1150	1190
3rd Salt Sand	Wh	H	1190	1318
Slate Shell	Dk	H	1318	1355
Lime		Dk H	1355	1397
Slate		Dk S	1397	1400
Sand	Lt	H	1400	1420
Slate		Dk S	1420	1425
Sand	Dk	H	1425	1500
Slate Shell	Dk	H	1500	1595
Sand	Lt	H	1595	1605
Slate	Dk	S	1605	1650
Lime	Wh	H	1650	1673
Slate	Dk	S	1673	1683
Sand	Dk	H	1683	1714
Lime	Wh	H	1714	1767
Sand	Lt	H	1767	1848
Slate	Dk	S	1848	1850
Sand	Lt	H	1850	1856
Slate	Dk	S	1856	1864

Gas 1767-1800