


Latitude 39 ° 20 ' 1

Longitude 80 ° 45 ' 1

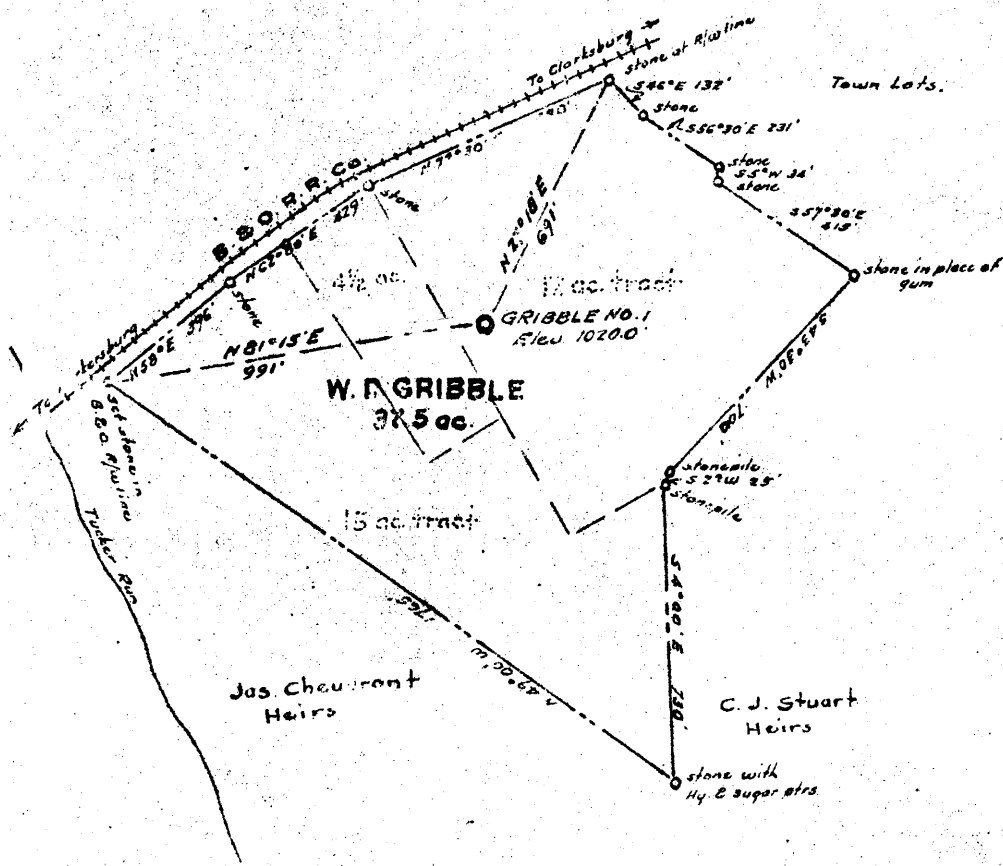

New Location
 Drill Deeper
 Abandonment

No commercial coal operations in this area.

Company W. D. GRIBBLE
 Address West Union, W. Va.
 Farm W. D. Gribble
 Tract Acres 37.5 Lease No. _____
 Well (Farm) No. One Serial No. _____
 Elevation (Spirit Level) 1020'
 Quadrangle West Union SE
 County Doddridge District West Union
 Engineer [Signature]
 Engineer's Registration No. 1227
 File No. _____ Drawing No. _____
 Date May 1948 Scale 1" = 500'

STATE OF WEST VIRGINIA
 DEPARTMENT OF MINES
 OIL AND GAS DIVISION
 CHARLESTON

WELL LOCATION MAP
 FILE NO. DOD-184

+ Denotes location of well on United States Topographic Maps, scale 1 to 62,500, latitude and longitude lines being represented by border lines as shown.

- Denotes one inch spaces on border line of original tracing.

99

WEST VIRGINIA DEPARTMENT OF MINES
OIL & GAS DIVISION
W E L L R E C O R D

Permit No. Dod 184
West Union Quad.

Gas Well
CASING & TUBING

Company	W.D. Gribble			
Address	West Union, W.Va.	10	318	0
Farm	W.D. Gribble Acres 37	8 1/2	781	0
Location	Doe Run	6 5/8	1593	1593
Well No.	1			
District	Elev. 1020'			
Surface	West Union Doddridge			
Mineral	W.D. Gribble, West Union, W.Va.			
Commenced	W.D. Gribble, West Union, W.Va.			
Completed	April 28, 1948			
Date shot	July 6, 1948			
Open flow	7-2-48 Depth 1943 to 1953			
Volume	with 120# gelatin			
	50/10ths W in 1 1/2"			
	250,000 G.F.			

Surface Soil	0	8
Clay & Shell	8	45
Lime	45	70
Red Rock	70	85
Lime	85	125
Red Rock	125	145
Sand	145	170
Slate & Shells	170	220
Lime	220	224
Coal Blossom	246	247
Lime	247	260
Slate & Shell	260	278
Sand	278	305
Red Rock	305	360
Slate & Shell	360	600
Red Rock	600	650
Slate & Shell	650	772
Sand	772	798
Slate	798	830
Red Rock	830	856
Slate & Shell	856	918
Red Rock	918	940
Broken Lime	940	1028
Sand, Big Dunkard	1028	1080
Slate & Shell	1080	1174
Sand - Gas Sand	1174	1240
Slate & Shell	1240	1260
Sand 1st Salt	1260	1292
Slate Black	1292	1341
Sand 2nd Salt	1341	1390
Slate	1390	1430
Sand 3rd Salt	1430	1465
Black Slate	1465	1490
Sand	1490	1500
Slate	1500	1580
Sand Maxon	1580	1622
Slate	1622	1765
Lime Little Lime	1765	1788
Blue Monday	1788	1806
Big Injun	1806	1953
Slate & Shells	1953	2050
Berea Sand	2050	2090
Slate	2090	2100
Gantz Sand H	2100	2290
Slate & Shell	2290	2306
Fifty Foot	2306	2336
Slate Shell	2336	2391
30' Sand	2391	2411
Slate & Shell	2411	2520
Gordon Stray Sand	2520	2536
Slate	2536	2545
Gordon Sand	2545	2556
Slate & Shell	2556	2595
Total Depth		2595

Gas 1945-1952 50/10 W 1 1/2"

Oil 2545-2551 slight shown

1956
1953
1952
1950

1788
1500
1341
1240
1028
772