


Latitude 39° 15'

Longitude 80° 50'

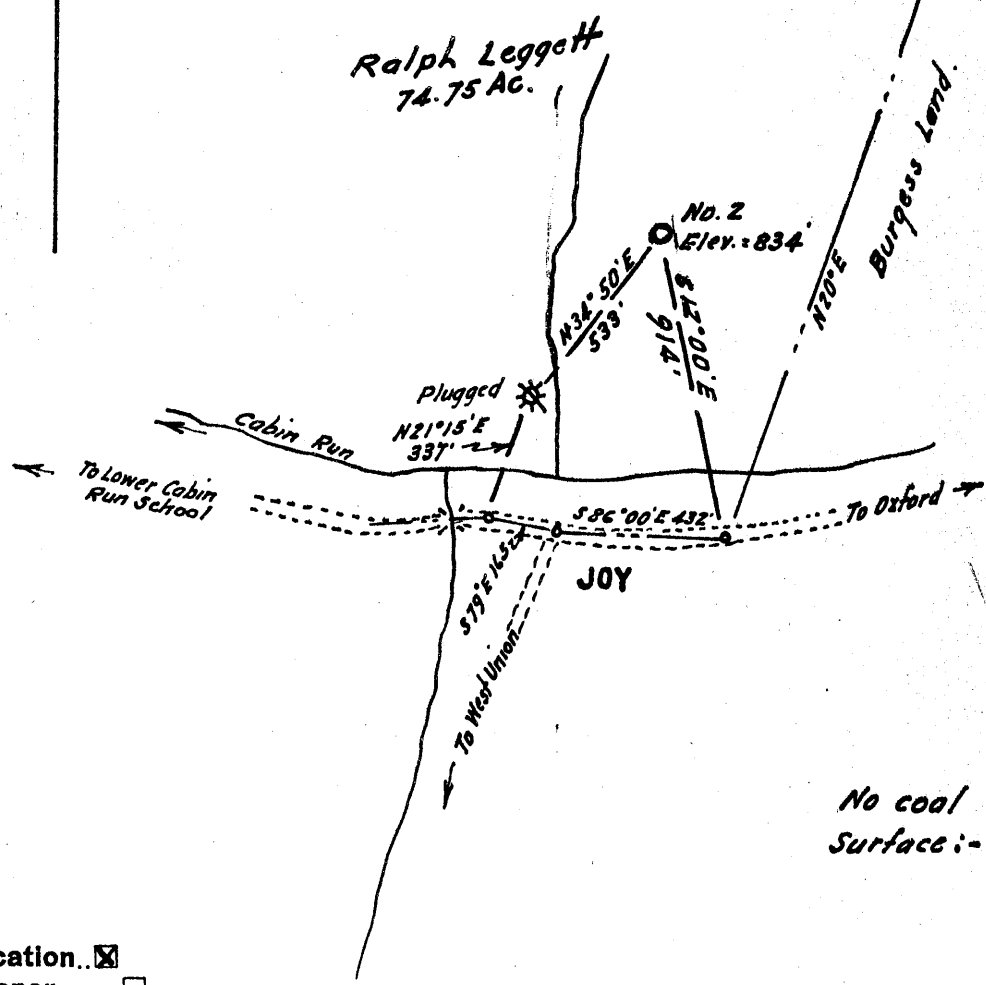

No coal
Surface:- Ralph Leggett,
Route 1,
West Union,
W. Va.

New Location..
 Drill Deeper.....
 Abandonment.....

Company LUTHER G. PIGGOTT

Address West Union, West Va.

Farm Ralph Leggett

Tract _____ Acres 74.75 Lease No. _____

Well (Farm) No. Two Serial No. _____

Elevation (Spirit Level) 834

Quadrangle Holbrook NC

County Doddridge District Central

Engineer Walter J.

Engineer's Registration No. 1227

File No. _____ Drawing No. _____

Date August, 1955 Scale 1" = 500'

STATE OF WEST VIRGINIA
 DEPARTMENT OF MINES
 OIL AND GAS DIVISION
 CHARLESTON

WELL LOCATION MAP
 FILE NO. DOD-215

+ Denotes location of well on United States Topographic Maps, scale 1 to 62,500, latitude and longitude lines being represented by border lines as shown.

- Denotes one inch spaces on border line of original tracing.



STATE OF WEST VIRGINIA
DEPARTMENT OF MINES
OIL AND GAS DIVISION

Halbrook

WELL RECORD

Permit No. Dod-215

Oil or Gas Well Dry
(KIND)

Company Luther G. Pigott
Address West Union, W. Va.
Farm Ralph Leggett Acres 170
Location (waters) Cabin Run
Well No. 1 Elev. 834'
District Central County Doddridge
The surface of tract is owned in fee by Ralph Leggett
Address West Union, WVa
Mineral rights are owned by Ralph Leggett & Others
Address _____
Drilling commenced Sept. 5, 1955
Drilling completed October 12, 1955
Date Shot _____ From _____ To _____
With _____
Open Flow _____ /10ths Water in _____ Inch
_____ /10ths Merc. in _____ Inch
Volume _____ Cu. Ft.
Rock Pressure _____ lbs. _____ hrs.
Oil _____ bbls., 1st 24 hrs.
Fresh water _____ feet _____ feet
Salt water _____ feet _____ feet

Casing and Tubing	Used in Drilling	Left in Well	Packers
Size			
16			Kind of Packer
18	7		
10	142		Size of
8 1/4	966		
6 3/8			Depth set
5 3/16			
3			Perf. top
2			Perf. bottom
Liners Used			Perf. top
			Perf. bottom

CASING CEMENTED _____ SIZE _____ No. Ft. _____ Date _____
No coal
COAL WAS ENCOUNTERED AT _____ FEET _____ INCHES
_____ FEET _____ INCHES FEET _____ INCHES
_____ FEET _____ INCHES FEET _____ INCHES

Formation	Color	Hard or Soft	Top	Bottom	Oil, Gas or Water	Depth Found	Remarks
Slate, sand & lime			0	555			
Coal blossom			555				
Little Dunkard			808	840			
Gas sand			1110	1125			
1st Salt			1335	1352			
2nd Salt			1400	1452			
3rd Salt			1500	1652			
Maxon			1727	1750			
Little Lime			1777	1808			
Pencil cave			1808	1812			
Big Lime			1812	1937			
Big Injun			1937	1955			
Squaw Sand			1966	1968			
Slate			1968	1971			
Total Depth			1971				

