


Latitude 39° 15'

Longitude 80° 45'

1.055
2.89W

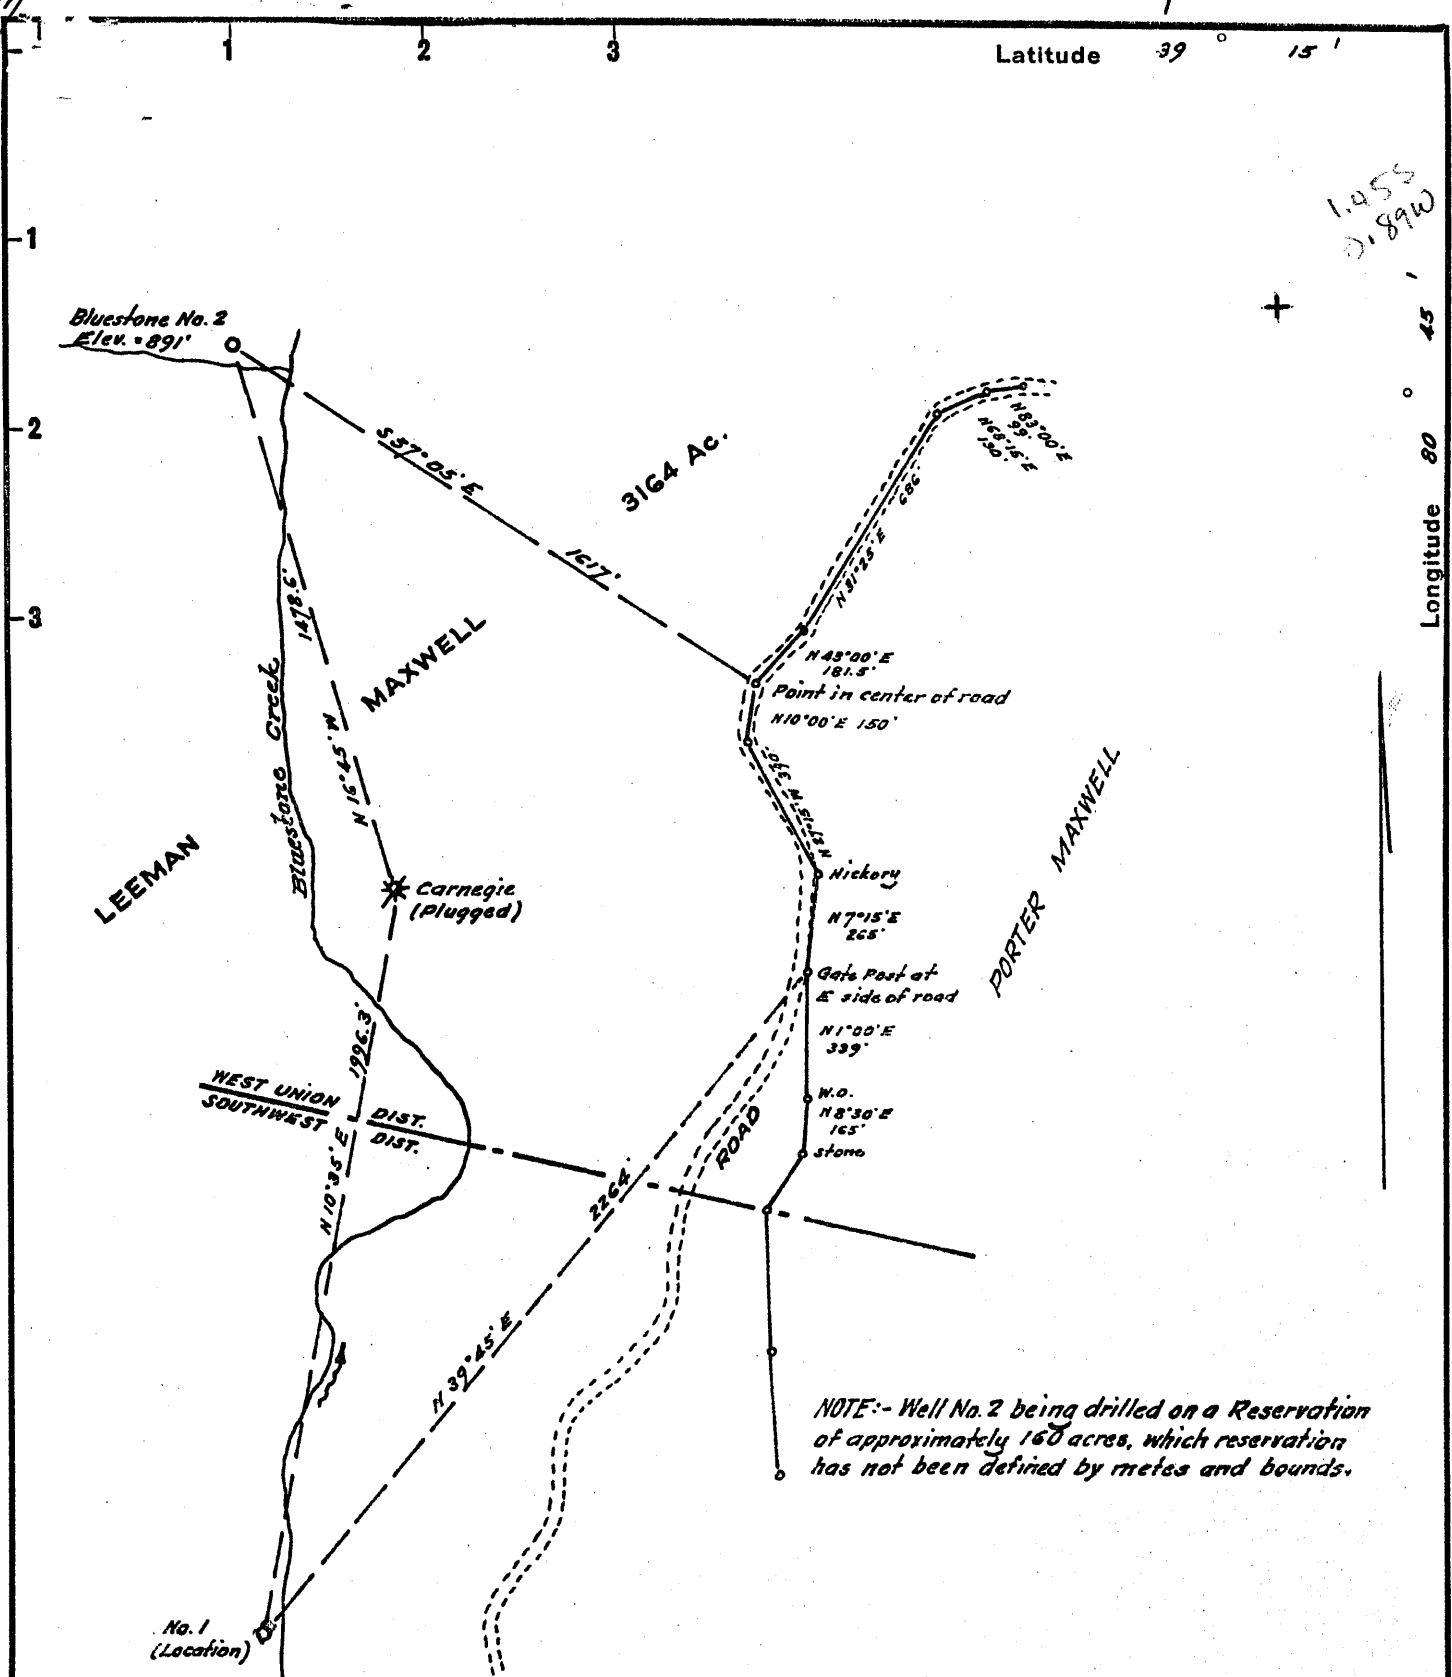

- New Location..
- Drill Deeper.....
- Abandonment.....

Fee ownership is vested in Leeman Maxwell Heirs.
Notitu Mrs. Robert Holland, West Union, W. Va.

NUMBER TWO

Company **BLUESTONE OIL & GAS CO.**

Address **Robert H. Holland, Agt., West Union, W. Va.**

Farm **Leeman Maxwell**

Tract _____ Acres **3164** Lease No. _____

Well (Farm) No. **Two** Serial No. _____

Elevation (Spirit Level) **891**

Quadrangle **Holbrook NE**

County **Doddridge** District **West Union**

Engineer *[Signature]*

Engineer's Registration No. **1227**

File No. _____ Drawing No. _____

Date **January, 1957** Scale **1" = 500'**

STATE OF WEST VIRGINIA
DEPARTMENT OF MINES
OIL AND GAS DIVISION
CHARLESTON

WELL LOCATION MAP
FILE NO. DOD-223
REVISED WELL OPERATOR

+ Denotes location of well on United States Topographic Maps, scale 1 to 62,500, latitude and longitude lines being represented by border lines as shown.

- Denotes one inch spaces on border line of original tracing.

6-6 123 ✓



STATE OF WEST VIRGINIA
DEPARTMENT OF MINES
OIL AND GAS DIVISION Z

Quadrangle Holbrook

Permit No. DOD223

WELL RECORD

Oil or Gas Well Gas


Company Bluestone # 2
Address West Union, W. Va.
Farm Leeman Maxwell Acres 3.164
Location (waters) Bluestone Creek
Well No. one (2) Elev. 891
District West Union County Doddridge
The surface of tract is owned in fee by Justin M. Henderson Address West Union, W. Va.
Mineral rights are owned by Mary H. Holland, et al Address West Union, W. Va.
Drilling commenced December 30, 1957
Drilling completed January 30, 1958
Date Shot _____ From _____ To _____
With _____
Open Flow /10ths Water in _____ Inch
/10ths Merc. in _____ Inch
Volume 75,000 Cu. Ft.
Rock Pressure 75 lbs. 24 hrs.
Oil none bbls., 1st 24 hrs.
WELL ACIDIZED no
WELL FRACTURED yes

Casing and Tubing	Used in Drilling	Left in Well	Packers
Size			Kind of Packer
16			
13			
10	125 feet	none	Size of
8 1/4	1047 ft.	1047 ft.	Depth set
6 5/8	1552 ft.	1552 ft.	
5 3/16			
3			Perf. top
2			Perf. bottom
Liners Used			Perf. top
			Perf. bottom

CASING CEMENTED no SIZE _____ No. Ft. _____ Date _____
COAL WAS ENCOUNTERED AT 500 FEET _____ INCHES
_____ FEET _____ INCHES FEET _____ INCHES
_____ FEET _____ INCHES FEET _____ INCHES
one foot of coal

RESULT AFTER TREATMENT 200000 cubic feet
ROCK PRESSURE AFTER TREATMENT 80 pounds
Fresh Water yes Feet 120 Salt Water no Feet _____

Formation	Color	Hard or Soft	Top	Bottom	Oil, Gas or Water	Depth	Remarks
surface			0	8'			
quicksand			8'	16'			
slate			16'	18'			
lime			18'	70'			
slate			70'	80'			
lime & sand			80'	140'			
red rock			140'	150'			
lime			150'	171'			
slate			171	179			
lime		hard	179	195			
coal			195	196			
lime		hard	196	218			
slate			218	250			
lime			250	275			
red rock			275	328			
slate & shells			328	375			
red rock			375	380			
lime			380	395			
red rock			395	426			
lime			426	432			
slate & shells			432	445			
red rock			445	455			
lime		hard	455	470			
red rock			470	485			
lime			485	500			
coal			500	501			
slate & shells			501	535			

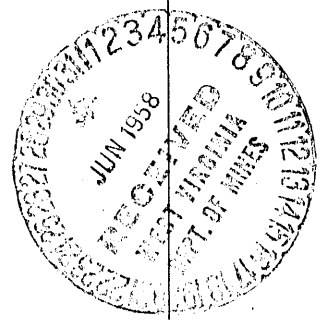

slanted hole-
hard as flint
hole full water
60'
125' 10"

blossom

good drilling

" "

" "

" "

fair drilling

Pitts. coal

Formation	Color	Hard or Soft	Top Σ	Bottom	Oil, Gas or Water	Depth Found	Remarks
lime			535	608			
slate	black		608	650			gritty, hard
red rock			650	670			good drilling
lime		hard	670	700			
slate & shells			700	720			
lime			720	800			gritty, hard
slate & shells			800	955			
black slate			955	995			
lime			995	1025			gritty
sand			1025	1035			no water
black slate	black		1035	1042			soft like coal
sand			1042	1065			1047' 8 $\frac{1}{4}$ "
slate			1065	1130			
sand			1130	1145			
lime			1145	1180			
black slate			1180	1230			
lime			1230	1257			
slate			1257	1284			
sand			1284	1315			gas 1287-1310
slate	black		1315	1325			
black lime			1325	1388			gritty, hard
sand			1388	1410			
slate			1410	1435			
red rock			1435	1450			
slate			1450	1470			
lime			1470	1508			
sand			1508	1512			
slate			1512	1517			
lime			1517	1525			
sbte			1525	1526)		two streaks of
lime			1526	1529)		pencil cave
pencil cave			1529	1530)		
big lime			1530	1595			1552' 7" OD
							good place to
							set a packer
sand & lime			1595	1665			gas 1600-1619
slate	black		1665	1683			gas 1650-1664
							total depth

Date June 28, 19 51

APPROVED Robert W. 2, Owner

By Robert W. Holland Agent
(Title)