



P

Latitude 39° 20'

Longitude 80° 40'

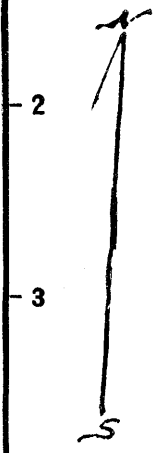

1
2
3

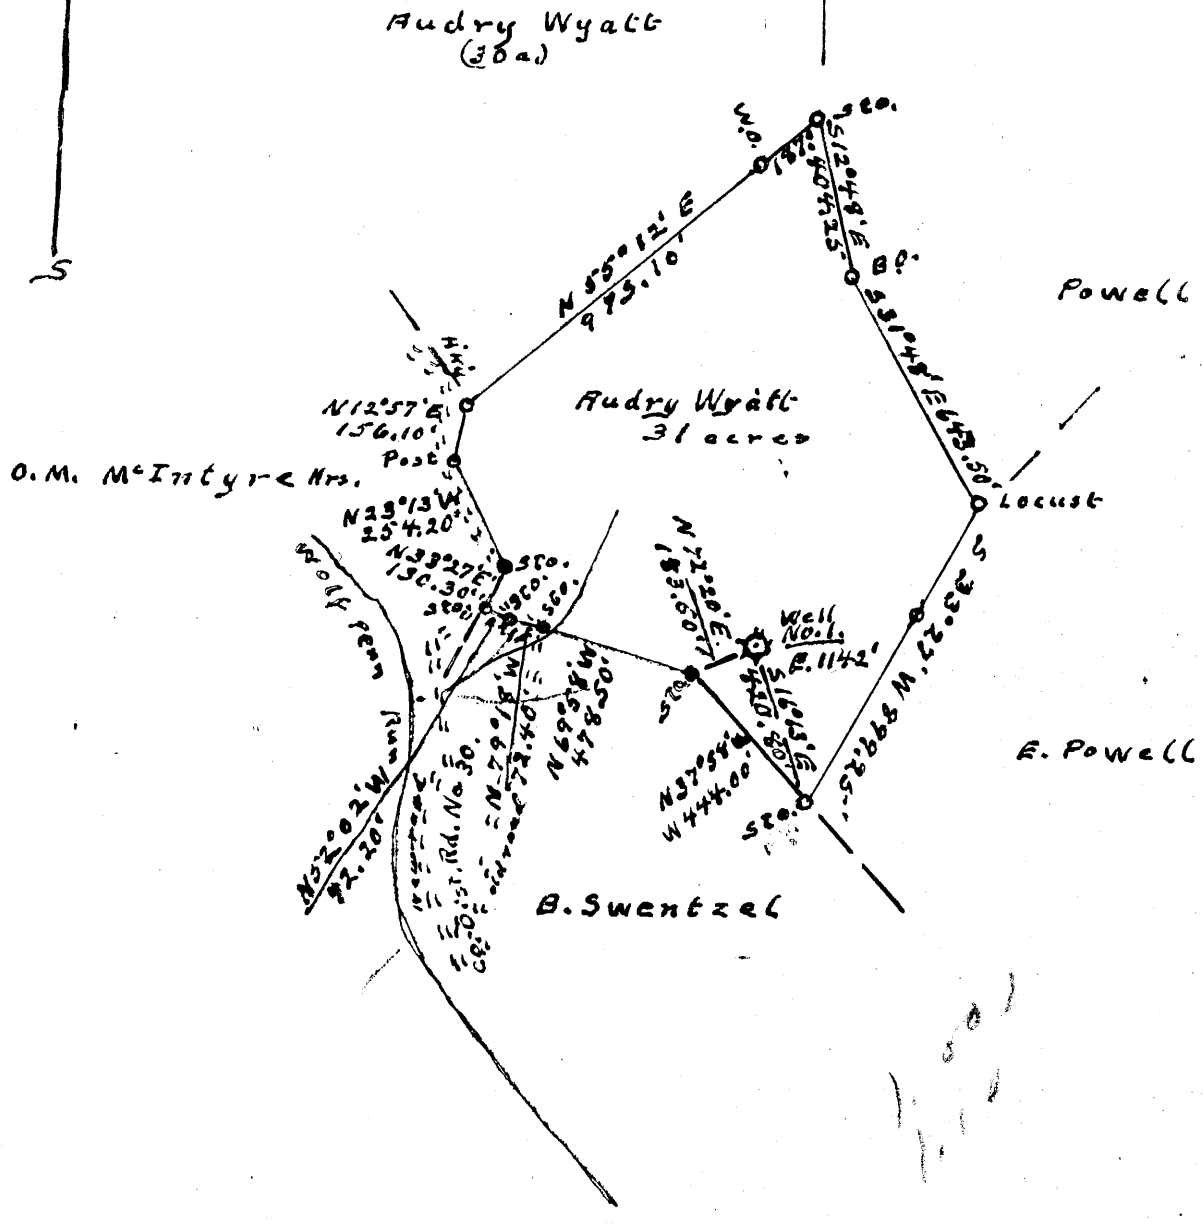

New Location...
Drill Deeper.....
Abandonment.....

Pittsburgh Coal vein owned by Dominion Coal Co.
Top coal owned by Audry Wyatt Vienna, W. Va.

Company MORGAN'S RUN GAS COMPANY
Clarence E. Powell Agent.
Address WEST UNION, Rd. 1, W. VA.
Farm AUDRY WYATT
Tract 1 Acres 31 Lease No. _____
Well (Farm) No. 1 Serial No. _____
Elevation (Spirit Level) 1142'
Quadrangle CENTER POINT - SW.
County Doddridge District Grant
Engineer J.M. Cochran
Engineer's Registration No. County Surveyor
File No. _____ Drawing No. _____
Date 12-21-'56 Scale 1" = 485'

STATE OF WEST VIRGINIA
DEPARTMENT OF MINES
OIL AND GAS DIVISION
CHARLESTON

WELL LOCATION MAP
FILE NO. DOD-224

+ Denotes location of well on United States Topographic Maps, scale 1 to 62,500, latitude and longitude lines being represented by border lines as shown.
- Denotes one inch spaces on border line of original tracing.



STATE OF WEST VIRGINIA
DEPARTMENT OF MINES
OIL AND GAS DIVISION

Centerpoint

Permit No. *Dod-334*

WELL RECORD

Oil or Gas Well *Gas*
(KIND)

Company Morgans Run Gas Company
Address West Union, West Virginia
Farm Audra Wyatt Acres 85
Location (waters) Morgans Run
Well No. 1 Elev. 1220
District Grant County Doddridge
The surface of tract is owned in fee by Audra Wyatt
Address Morgansville, W. Va.
Mineral rights are owned by Same
Address _____

Drilling commenced June 12, 1957
Drilling completed July 8, 1957
Date Shot None From _____ To _____
With _____


Open Flow 20 /10ths Water in _____ Inch
/10ths Merc. in 1-1/4 Inch
Volume 196,400 Cu. Ft.
Rock Pressure 520 lbs. 24 hrs.
Oil None bbls., 1st 24 hrs.
Fresh water 325 feet
Salt water None feet

Casing and Tubing	Used in Drilling	Left in Well	Packers
Size			
16	---	---	Kind of Packer <u>hook wall</u>
13	---	---	Size of <u>6-5/8</u>
10	<u>485</u>	<u>None</u>	Depth set <u>1778</u>
8 1/4	<u>1178</u>	<u>None</u>	
6 1/2	<u>1778</u>	<u>1778</u>	
5 3/16			
3			Perf. top _____
2			Perf. bottom _____
Liners Used	<u>None</u>		Perf. top _____
			Perf. bottom _____

CASING CEMENTED No SIZE _____ No. Ft. _____ Date _____

COAL WAS ENCOUNTERED AT None FEET _____ INCHES
FEET _____ INCHES FEET _____ INCHES
FEET _____ INCHES FEET _____ INCHES

Formation	Color	Hard or Soft	Top	Bottom	Oil, Gas or Water	Depth Found	Remarks
Red Rock			0	6			
Sand			6	20			
Red Rock			20	40			
Lime			40	52			
Red Rock			52	70			
Slate & Shells			70	165			
Sand			165	190			
Slate & Shells			190	240			
Red Rock			240	275			
Slate			275	315			
Sand			315	365			
Slate & Shells			365	460			
Red Rock			460	478			
Lime			478	490			
Slate			490	508			
Sand			508	558			
Slate			558	575			
Red Rock			575	590			
Slate & S.			590	705			
Sand			705	733			
Slate			733	750			
Red Rock			750	785			
Slate			785	800			
Sand			800	823			
Slate			823	830			
Lime			830	875			
Red Rock			875	919			
Slate			919	1005			
Sand			1005	1020			
Slate & S.			1020	1055			
Pink Rock			1055	1073			
Slate			1073	1092			
Lime			1092	1105			
Slate & S.			1105	1140			
Black Slate			1140	1175			

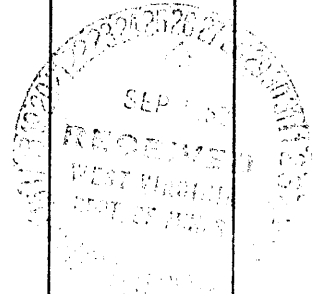

Formation	Color	Hard or Soft	Top	Bottom	Oil, Gas or Water	Depth Found	Remarks
Slate & S.			1175	1295			
Sand			1295	1336			
Slate & S.			1336	1370			
Sand			1370	1403			
Slate			1403	1408			
Sand			1408	1452			
Slate			1452	1490			
Sand			1490	1505			
Slate & S.			1505	1520			
Sand			1520	1718			
Slate			1718	1740			
Sand			1740	1784			
Slate			1784	1789			
Sand			1789	1831	Gas	1820-1830	
Slate			1831	1839			
Sand			1839	1880	Gas	1854-1875	
Slate			1880	1910			
Little Lime & Blue Monday Slate			1910	1965			
Slate			1965	1985			
Lime			1985	1994			
Slate			1994	1995			
Lime			1995	2060			
Injun Sand			2060	2175			
Slate			2175	2185			
Total Depth				2237			