

NOTE:
Fannie Broadwater and Clarice Worley
own the Mineral Rights.

New Location..
 Drill Deeper.....
 Abandonment.....

Company	<u>R. J. HUNTER</u>
Address	<u>90 ROB'T. HOLLAND - WEST UNION, W. VA.</u>
Farm	<u>GLEN ALLEN</u>
Tract	<u>53 AC. 16 PLS.</u> Lease No. _____
Well (Farm) No.	<u>1</u> Serial No. _____
Elevation (Spirit Level)	<u>1035'</u>
Quadrangle	<u>CENTERPOINT SW</u>
County	<u>DODDRIDGE</u> District <u>GRANT</u>
Engineer	<u>JOHN W. HAMILTON</u>
Engineer's Registration No.	<u>2274</u>
File No.	_____ Drawing No. _____
Date	<u>MAY 29, 1958</u> Scale <u>1" = 20 POLES</u>

STATE OF WEST VIRGINIA
 DEPARTMENT OF MINES
 OIL AND GAS DIVISION
 CHARLESTON

WELL LOCATION MAP
 FILE NO. DOD-255

+ Denotes location of well on United States
 Topographic Maps, scale 1 to 62,500, lat-
 itude and longitude lines being represented
 by border lines as shown.

- Denotes one inch spaces on border line
 of original tracing.

66 79



STATE OF WEST VIRGINIA
DEPARTMENT OF MINES
OIL AND GAS DIVISION

Quadrangle Centerpoint

Permit No. DOD-255

WELL RECORD

Oil or Gas Well Gas

(KIND)

Company R. J. Hunter
Address 106 Neely Ave. West Union, W. Va.
Farm Glenn Allen Acres 53
Location (waters) Buckeye Run
Well No. No. 1 Elev. 1035
District Grant County Doddridge
The surface of tract is owned in fee by Glenn Allen,
Morgansville Address W. Va.
Mineral rights are owned by Clarice Worley and
Fannie Broadwater Address Salem, W. Va.
Drilling commenced June 5, 1958
Drilling completed June 23, 1958
Date Shot Not shot From _____ To _____
With _____
Open Flow 29 /10ths Water in _____ Inch
Two /10ths Merc. in _____ Inch
Volume 836,000 Cu. Ft.
Rock Pressure 245 lbs. 16 hrs.
Oil _____ bbls., 1st 24 hrs.
WELL ACIDIZED _____
WELL FRACTURED _____

Casing and Tubing	Used in Drilling	Left in Well	Packers
Size			Anchor
16			Kind of Packer
13			
10	21'	21'	Size of <u>3" x 6" x 3'</u>
8 1/4	810'	810'	
6 5/8	1152'	1152'	Depth set <u>1183'</u>
5 3/16	1256'	1256'	
3	1256'	1256'	Perf. top _____
2			Perf. bottom _____
Liners Used			Perf. top _____
			Perf. bottom _____


CASING CEMENTED _____ SIZE _____ No. Ft. _____ Date _____
COAL WAS ENCOUNTERED AT _____ FEET _____ INCHES
_____ FEET _____ INCHES _____ FEET _____ INCHES
_____ FEET _____ INCHES _____ FEET _____ INCHES

RESULT AFTER TREATMENT _____

ROCK PRESSURE AFTER TREATMENT _____

Fresh Water 1123 Feet Salt Water _____ Feet

Formation	Color	Hard or Soft	Top	Bottom	Oil, Gas or Water	Depth	Remarks
Clay	Red	Soft	0	25			
Slate			25	100			
Red Rock			100	120			
Slate&Shells			120	225	Water	128'	
Sand			225	235			
Slate&Shells			235	268			
Red Rock			268	273			
Slate			273	305			
Hard Lime			305	355			
Slate			355	390			
Sand			390	420			
Slate			420	445			
Lime			445	455			
Red Rock			455	466			
Sand			466	478			
Red Rock			478	508			
Slate&Shells			508	517			
Sand			517	540			
Red Rock			540	560			
Lime			560	590			
Red Rock			590	600			
Slate			600	665			
Dark Slate			665	669			
Lime			669	688			
Red Rock			688	714			
Slate&Shells			714	780			
Sand			780	815			
Lime Broken			815	840			
Slate			840	890			

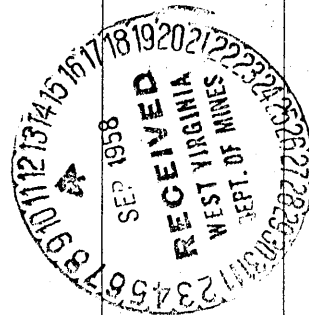

Formation	Color	Hard or Soft	Top /	Bottom	Oil, Gas or Water	Depth Found	Remarks
Sand			890	925			
Lime Broken			925	990			
Sand			990	1080			
Slate&Shells			1080	1096			
Sand			1096	1115			
Slate			1115	1120			
Sand			1 120	1144	Water	1123	Hole Full
Slate			1144	1148			
Sand			1148	1210			
Lime Broken Black			1 210	1218			
Sand			1218	1256	Gas	1251-1256	No water
			Total Depth 1256 Ft.				

Date Sept. 9, 1958

APPROVED [Signature], Owner

By [Signature]
(Title)