


P

Latitude 39° 15'

Longitude 80° 50'

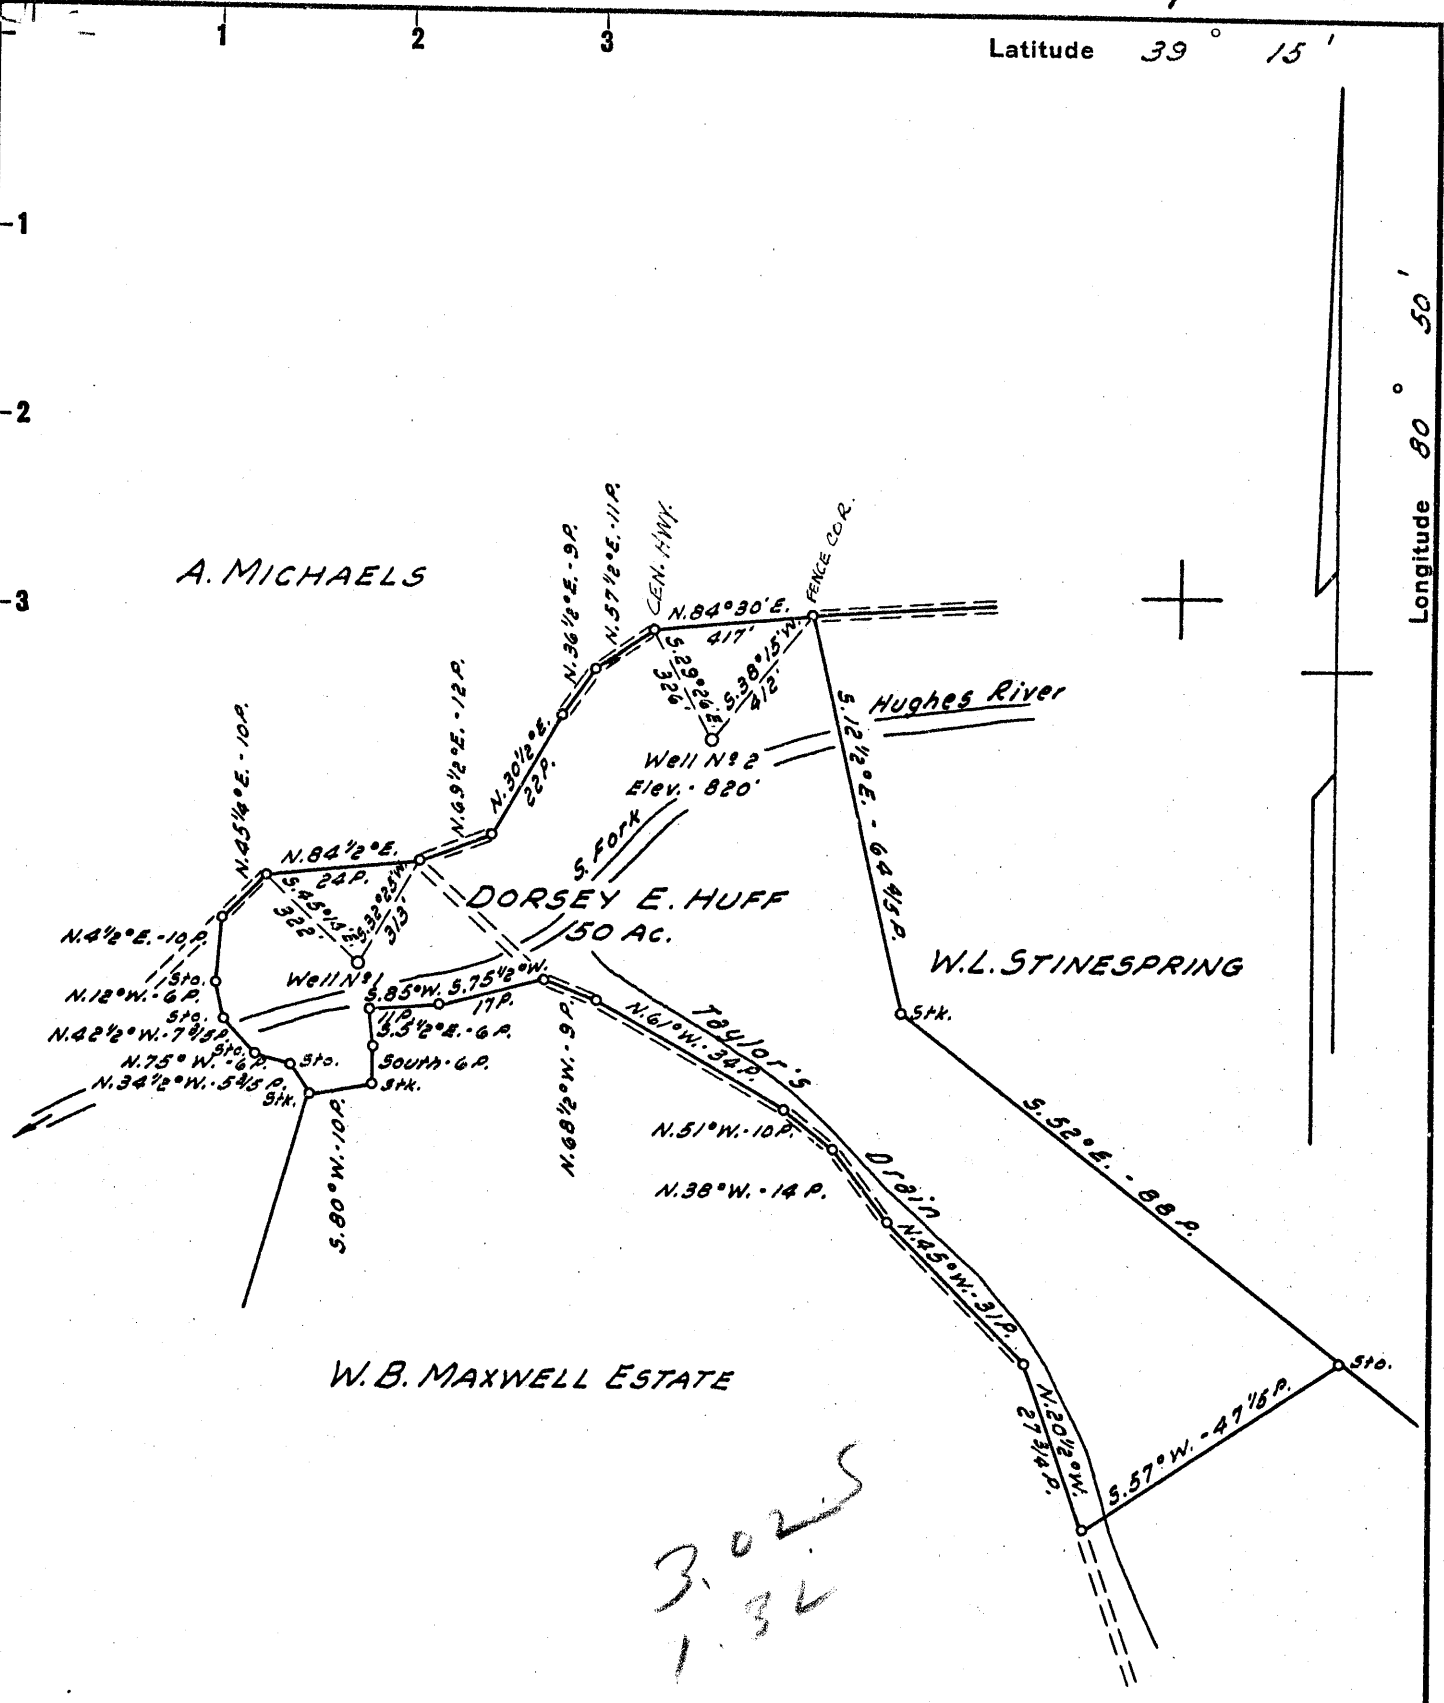

- New Location..
- Drill Deeper.....
- Abandonment.....

Company L.B. COFFMAN

Address RT. - 2 SALEM, W. VA.

Farm DORSEY E. HUFF

Tract _____ Acres 50 Lease No. _____

Well (Farm) No. 2 Serial No. _____

Elevation (Spirit Level) 820

Quadrangle HOLBROOK NC

County DODDRIDGE District SOUTHWEST

Engineer JOHN W. HAMILTON

Engineer's Registration No. 2274

File No. _____ Drawing No. _____

Date MAY 30, 1958 Scale 1" = 30 FEET

STATE OF WEST VIRGINIA
DEPARTMENT OF MINES
OIL AND GAS DIVISION
CHARLESTON

WELL LOCATION MAP

FILE NO. DOD-256

+ Denotes location of well on United States Topographic Maps, scale 1 to 62,500, latitude and longitude lines being represented by border lines as shown.

- Denotes one inch spaces on border line of original tracing.

30

✓



STATE OF WEST VIRGINIA
DEPARTMENT OF MINES
OIL AND GAS DIVISION /

Quadrangle Holbrook

Permit No. DOD-256

WELL RECORD

Oil or Gas Well Any
(KAD)

Company L. B. Coffman
Address Route 2, Salem, West Virginia
Farm Dorsey E. Huff Acres 50
Location (waters) S. Fork of Hughes River
Well No. Two Elev. 820
District Southwest County Doddridge
The surface of tract is owned in fee by Dorsey E. Huff
Address Oxford, W. Va.
Mineral rights are owned by Dorsey E. Huff
Address Oxford, W. Va.
Drilling commenced June 6, 1958
Drilling completed June 30, 1958
Date Shot _____ From _____ To _____
With _____
Open Flow _____ /10ths Water in _____ Inch
_____ /10ths Merc. in _____ Inch
Volume _____ Cu. Ft.
Rock Pressure _____ lbs. _____ hrs.
Oil _____ bbls., 1st 24 hrs.
WELL ACIDIZED _____
WELL FRACTURED _____

Casing and Tubing	Used in Drilling	Left in Well	Packers
Size			Kind of Packer _____
16			Size of _____
13			Depth set _____
10			Perf. top _____
8 1/4	<u>257 ft.</u>		Perf. bottom _____
6 1/4	<u>1024 ft.</u>		Perf. top _____
5 3/16	<u>1742 ft.</u>		Perf. bottom _____
3			
2			
Liners Used			


CASING CEMENTED _____ SIZE _____ No. Ft. _____ Date _____
COAL WAS ENCOUNTERED AT _____ FEET _____ INCHES
_____ FEET _____ INCHES FEET _____ INCHES
_____ FEET _____ INCHES FEET _____ INCHES

RESULT AFTER TREATMENT

ROCK PRESSURE AFTER TREATMENT

Fresh Water 385 Feet Salt Water None Feet

Formation	Color	Hard or Soft	Top	Bottom	Oil, Gas or Water	Depth	Remarks
Soil			0	13			
Slate			13	30			
Red Rock			30	55			
Slate			55	87			
Red Rock			87	100			
Lime			100	110			
Slate			110	197			
Red Rock			197	265			
Slate Shells			265	352			
Red Rock			352	380			
Red Lime			380	400			
Slate Shells			400	495			
Red Rock			495	640			
Slate Shells			640	735			
Red Rock			735	770			
Slate & Shells			770	897			
Sand			897	935			
Black Slate			935	945			
Sand			945	955			
Slate & Shells			955	970			
Lime			970	986			
Slate & Shells			986	1030			
Sand			1030	1055			
Slate & Shells			1055	1070			
Sand			1070	1150			
Lime			1150	1170			
Black Slate			1170	1175			
Sand			1175	1240			
Slate & Shells			1240	1270			

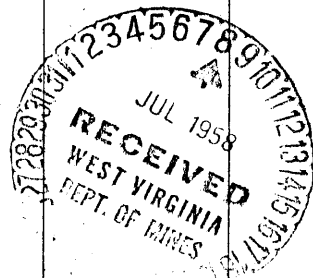

Formation	Color	Hard or Soft	Top /	Bottom	Oil, Gas or Water	Depth Found	Remarks
Sand			1270	1285			
Slate & Shells			1285	1300			
Gritty Lime			1300	1335			
Sand			1335	1410			
Black Slate			1410	1435			
Sand			1435	1567			
Slate			1567	1570			
Gritty Lime			1570	1578			
Slate & Shells			1578	1644			
Black Slate			1644	1660			
Lime			1660	1668			
Sand			1668	1699			
Slate			1699	1707			
Lime			1707	1727			
Slate			1727	1732			
Lime			1732	1787			
Sand			1787	1790			
Lime			1790	1794			
Sand			1794	1840			
Slate			1840	1856			
Total Depth				1856			

Date _____, 19____

APPROVED _____, Owner

By _____
(Title)