


Too crowded to Plot

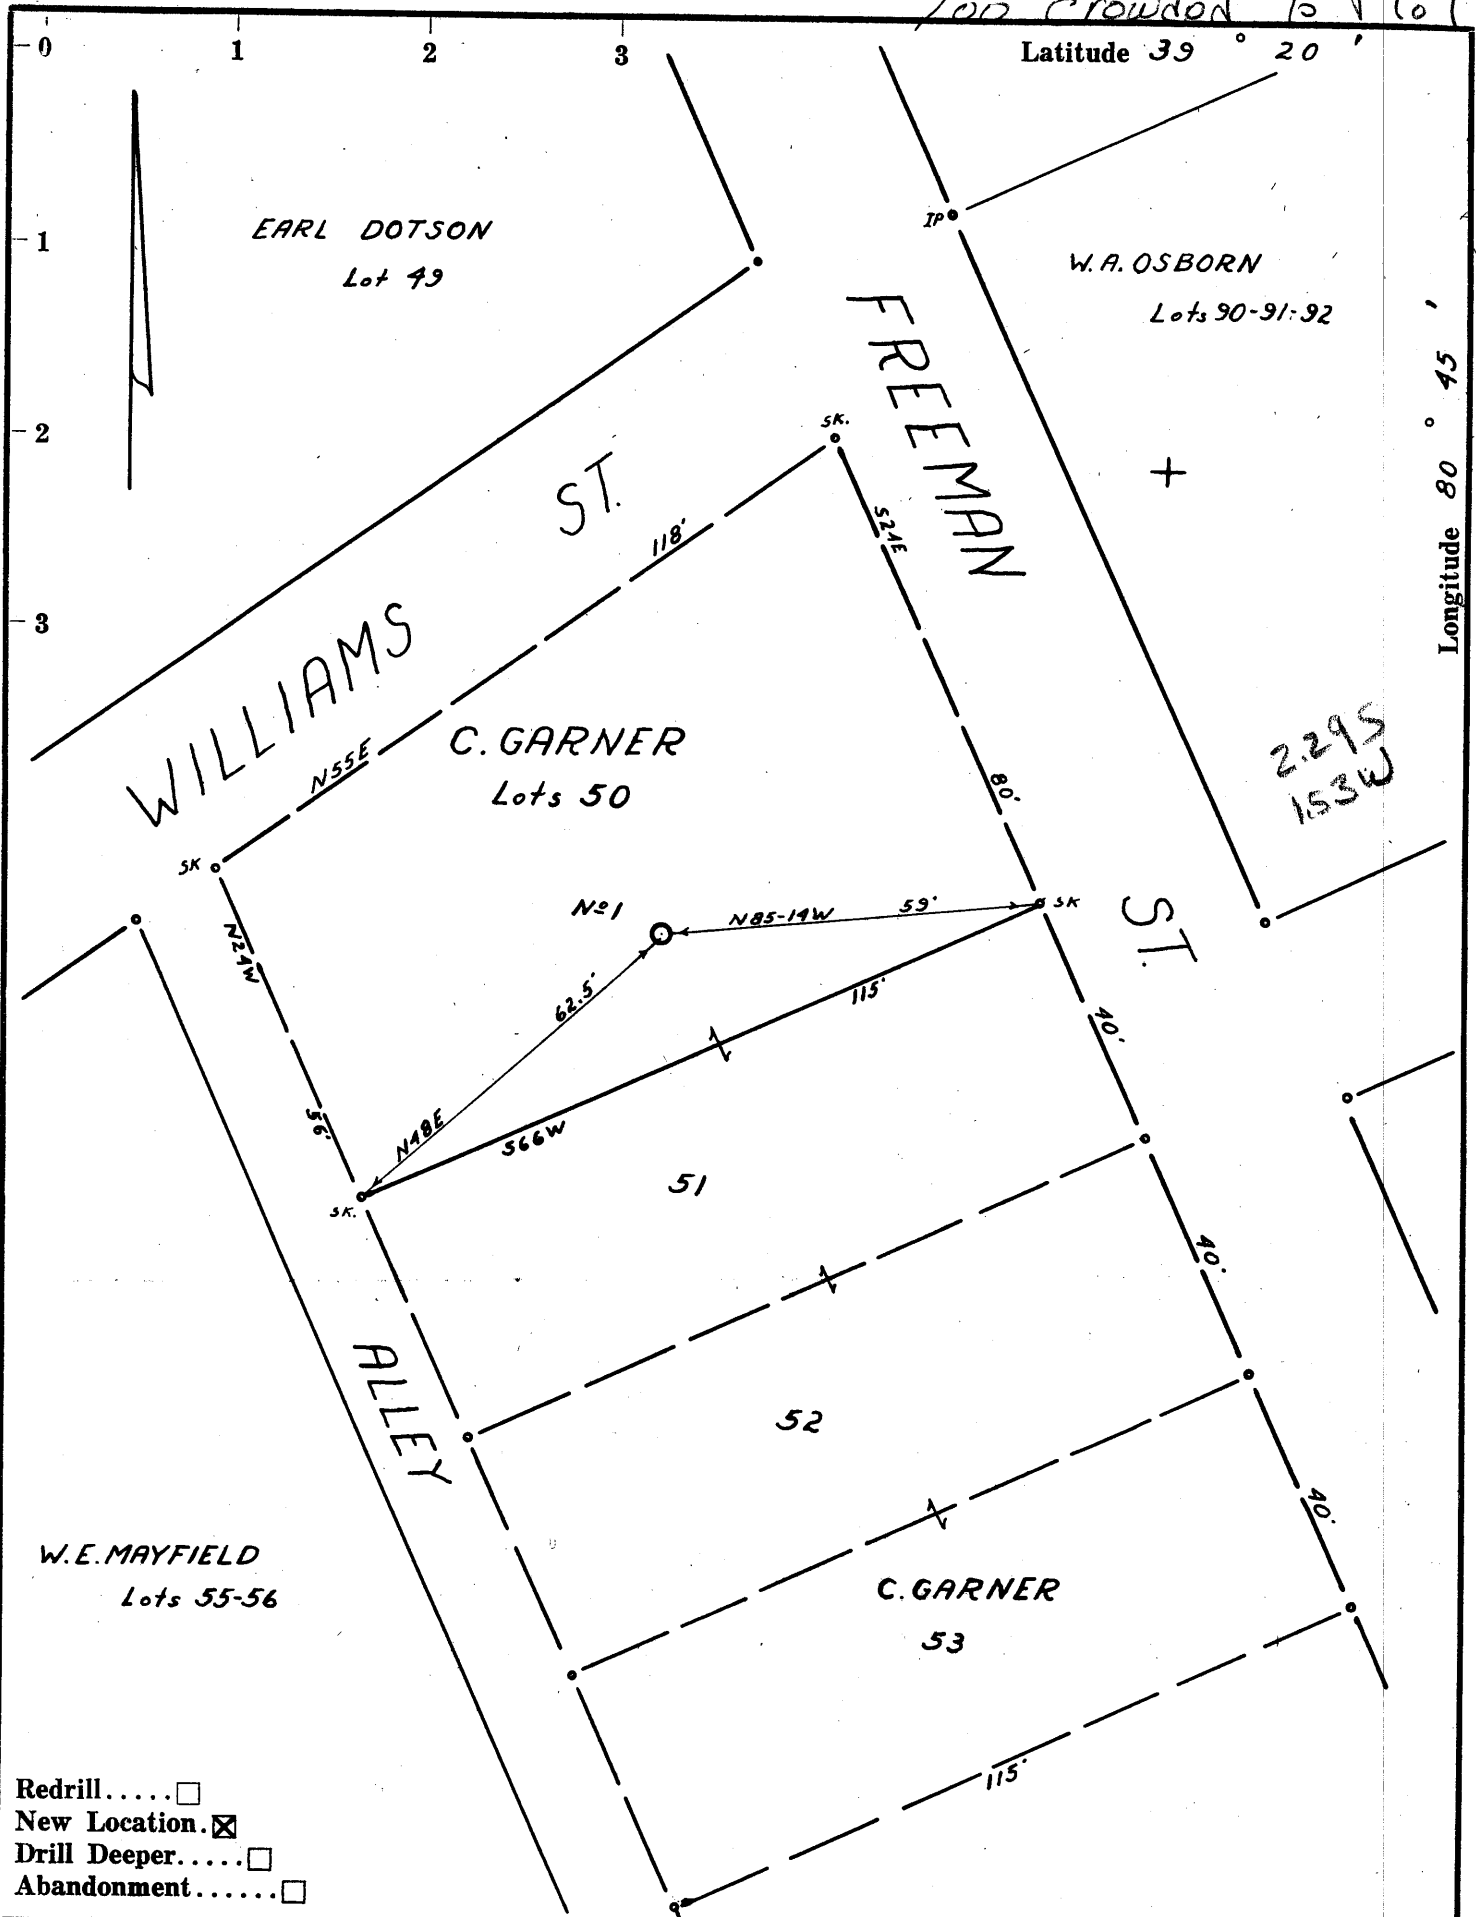

- Redrill.....
- New Location.
- Drill Deeper.....
- Abandonment.....

Company STONE STREET LANDS CO.
 Address BOX 350 SPENCER, W.VA.
 Farm C. GARNER
 Tract LOT 50 Acres _____ Lease No. _____
 Well (Farm) No. 1 Serial No. _____
 Elevation (Spirit Level) 828' V.A.
 Quadrangle WEST UNION SE 42
 County DODDRIDGE District WEST UNION
 Engineer J. D. JEFFRIES
 Engineer's Registration No. 1084
 File No. 198/146 Drawing No. _____
 Date 4-23-60 Scale 1" = 30'

STATE OF WEST VIRGINIA
 DEPARTMENT OF MINES
 OIL AND GAS DIVISION
 CHARLESTON

WELL LOCATION MAP
 FILE NO. DOD-361

+ Denotes location of well on United States Topographic Maps, scale 1 to 62,500, latitude and longitude lines being represented by border lines as shown.

— Denotes one inch spaces on border line of original tracing.

RDM's