




WW-7
8-30-06

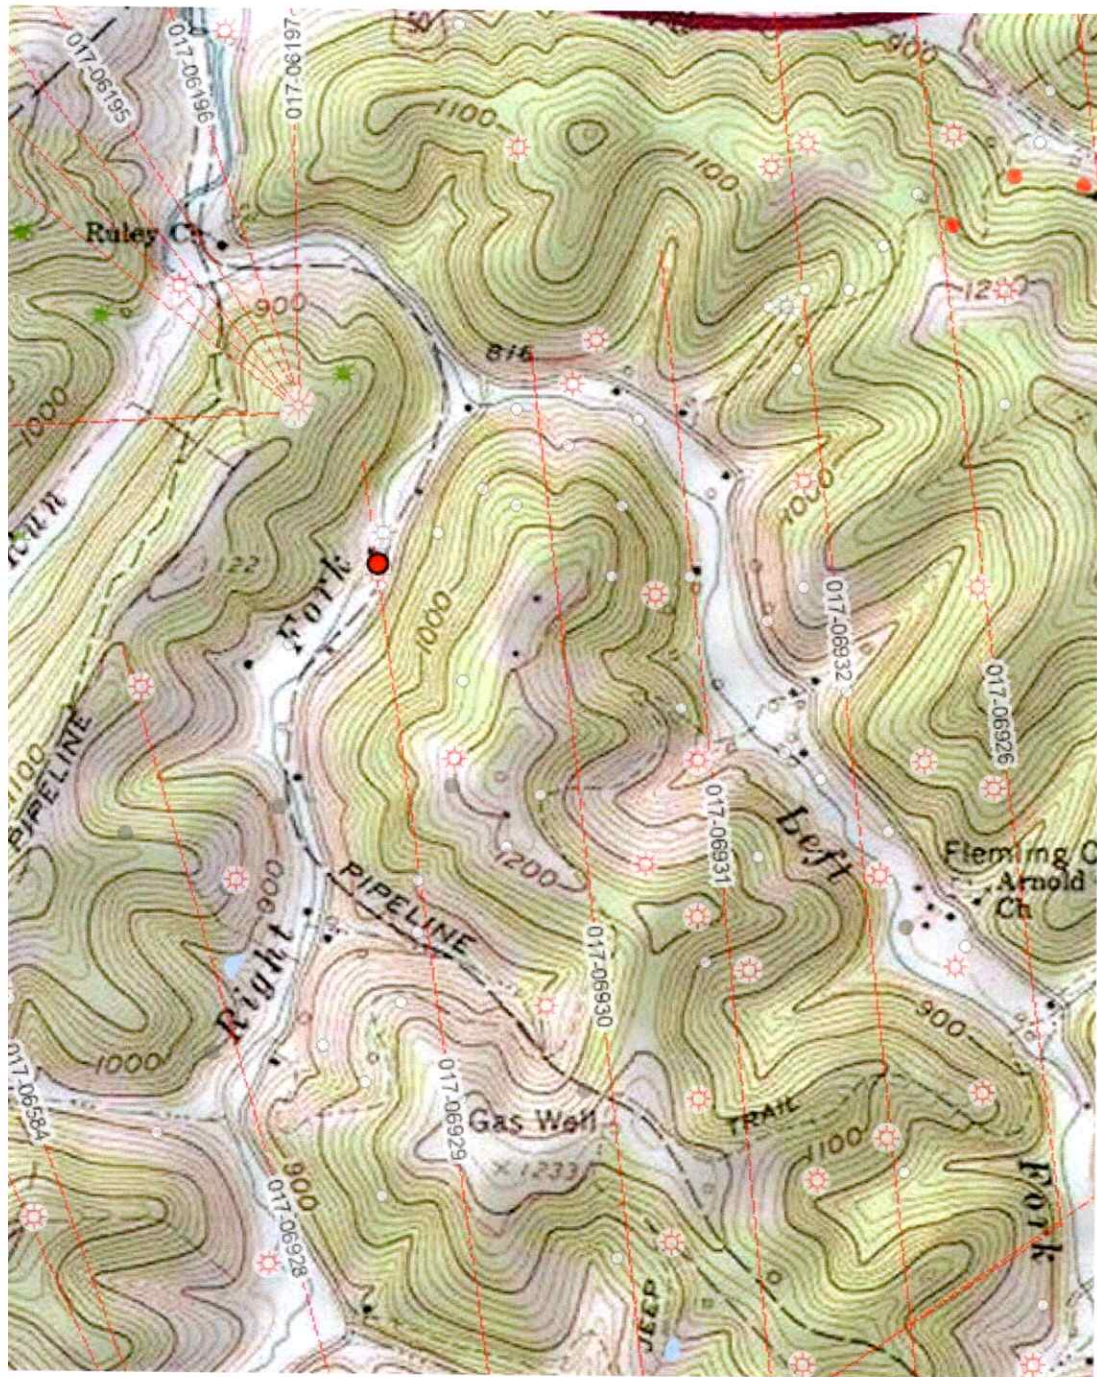

West Virginia Department of Environmental Protection
Office of Oil and Gas
WELL LOCATION FORM: GPS

API: 4701700480 WELL NO.: Moses 1-S-4557
FARM NAME: Freeman, Joseph
RESPONSIBLE PARTY NAME: DEP Paid Plugging Contract
COUNTY: Doddridge DISTRICT: West Union
QUADRANGLE: West Union
SURFACE OWNER: Mary L. Nesler
ROYALTY OWNER: Key Oil
UTM GPS NORTHING: 5 16 557
UTM GPS EASTING: 43 46 468 GPS ELEVATION: 827'

The Responsible Party named above has chosen to submit GPS coordinates in lieu of preparing a new well location plat for a plugging permit or assigned API number on the above well. The Office of Oil and Gas will not accept GPS coordinates that do not meet the following requirements:

1. Datum: NAD 1983, Zone: 17 North, Coordinate Units: meters, Altitude: height above mean sea level (MSL) – meters.
2. Accuracy to Datum – 3.05 meters
3. Data Collection Method:

Survey grade GPS ____ : Post Processed Differential ____

Real-Time Differential ____

Mapping Grade GPS X : Post Processed Differential ____

Real-Time Differential ____

4. **Letter size copy of the topography map showing the well location.**

I the undersigned, hereby certify this data is correct to the best of my knowledge and belief and shows all the information required by law and the regulations issued and prescribed by the Office of Oil and Gas.

Bryan Harris

Inspector Specialist

July 16, 2024

Signature

Title

Date

05/23/2025