


Latitude 39° 25'

Longitude 80° 40'

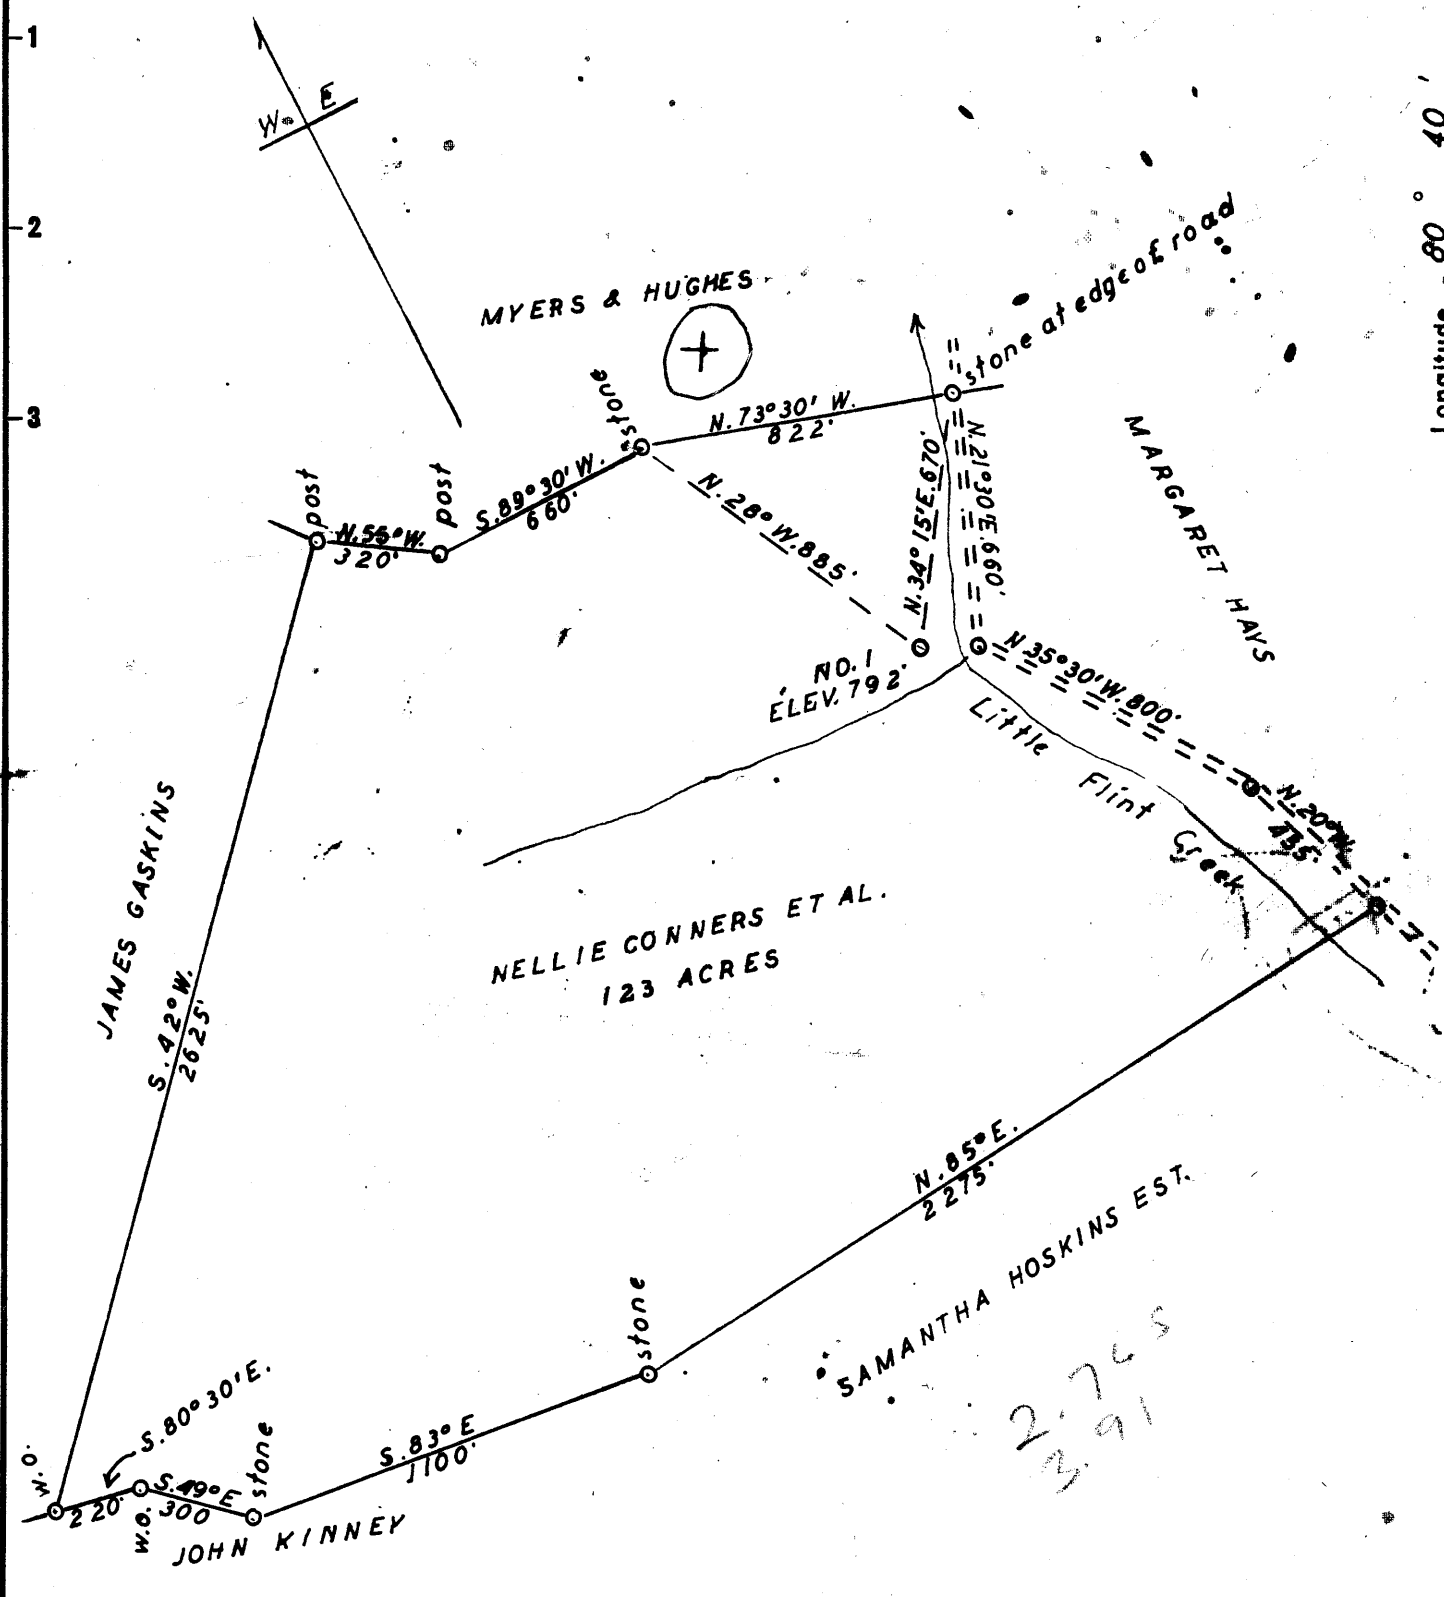

New Location
 Drill Deeper
 Abandonment

Company	FOLWELL ASSOCIATES & MYERS
Address	RT. 1. ST. MARYS. W. VA.
Farm	NELLIE CONNERS ET AL.
Tract	Acres 123 Lease No. 2
Well (Farm) No.	1 Serial No. 2
Elevation (Spirit Level)	792'
Quadrangle	CENTERPOINT WC
County	DODDRIDGE District GRANT
Engineer	Parker E. Peters
Surveyed by	Harold G. [unclear]
Engineer's Registration No.	485
File No.	Drawing No.
Date	JAN. 9. 1961 Scale 1" = 500'

STATE OF WEST VIRGINIA
 DEPARTMENT OF MINES
 OIL AND GAS DIVISION
 CHARLESTON

WELL LOCATION MAP
 FILE NO. DOD-524

+ Denotes location of well on United States Topographic Maps, scale 1 to 62,500, latitude and longitude lines being represented by border lines as shown.

- Denotes one inch spaces on border line of original tracing.

6-0 99



STATE OF WEST VIRGINIA
DEPARTMENT OF MINES
OIL AND GAS DIVISION 3

Quadrangle Centerpoint

Permit No. DOD - 524

WELL RECORD

Oil or Gas Well Dry

(KIND)

Company Folwell Associates
Address 12499 N.E. 8th Ave., Miami Beach, Florida
Farm Nellie Conners et al. Acres 123
Location (waters) Little Flint Creek
Well No. 1 Elev. 792
District Grant County Doddridge
The surface of tract is owned in fee by Nellie Conners et al. Address West Union, W. Va.
Mineral rights are owned by _____ Address _____
Drilling commenced 1/23/61
Drilling completed 2/11/61
Date Shot _____ From _____ To _____
With _____
Open Flow _____ /10ths Water in _____ Inch
_____ /10ths Merc. in _____ Inch
Volume _____ Cu. Ft.
Rock Pressure _____ lbs. _____ hrs.
Oil _____ bbls., 1st 24 hrs.
WELL ACIDIZED _____
WELL FRACTURED _____

Casing and Tubing	Used in Drilling	Left in Well	Packers
Size			
16	12'		Kind of Packer _____
13			
10	23'		Size of _____
8 1/4	351'		
6 3/8	1051'		Depth set _____
5 3/16			
3			Perf. top _____
2			Perf. bottom _____
Liners Used			Perf. top _____
			Perf. bottom _____

CASING CEMENTED _____ SIZE _____ No. Ft. _____ Date _____
COAL WAS ENCOUNTERED AT None FEET _____ INCHES _____
FEET _____ INCHES FEET _____ INCHES
FEET _____ INCHES FEET _____ INCHES

RESULT AFTER TREATMENT _____
ROCK PRESSURE AFTER TREATMENT _____
Fresh Water 35' Feet _____ Salt Water 1580' Feet _____

Formation	Color	Hard or Soft	Top	Bottom	Oil, Gas or Water	Depth	Remarks
Surface Soil & Gravel			0'	20'			
Red Rock			20	25			
Slate			25	33			
Lime			33	40			
Slate & Red Rock			40	175			
Sand			175	215			
Slate & Red Rock			215	330			
Lime			330	340			
Slate & Red Rock			340	365			
Slate - Shells			365	385			
Lime			385	400			
Slate - Shells			400	525			
Slate & Red Rock			525	680			
Sand			680	687			
Gray Slate			687	707			
Red Rock			707	748			
Slate - Shells			748	785			
Slate			785	817			
Pink Rock			817	835			
Slate - Shells			835	903			
Sand			903	912			
Slate			912	990			
Sand			990	1045			
Slate - Shells			1045	1141			
Slate			1141	1268			
Sand			1268	1312			
Slate			1312	1318			
Sand			1318	1329			

Formation	Color	Hard or Soft	Top 3	Bottom	Oil, Gas or Water	Depth Found	Remarks
Slate			1329'	1370'			
Sand			1370	1395			
Slate			1395	1473			
Sand			1473	1490			
Brake			1490	1491			
Sand			1491	1522			
Slate & Shells			1522	1580			
Sand			1580	1625			
Slate			1625	1660			
Red Rock			1660	1680			
Lime			1680	1770			
Slate			1770	1790			
Sand			1790	1815			
Shale			1815	1819			
Sandy Lime			1819	1834			
Shale			1834	1840			
Sand			1840	1890			
Shale			1890	1897			
Sand			1897	1907			
Shale			1907	1932			
Sand			1932	1951			
Shale			1951	2113			
Total Depth				2113'			

1680
792
888

Date _____, 19____

APPROVED _____, Owner

By _____ (Title)