

NOTE:
 New Location Orva Davis et ux Rt-1 Salem, W. Va. owns in Fee.
 Drill Deeper
 Abandonment

Company HUGH K. SPENCER, AGT.
 Address WEST UNION, W. VA.
 Farm ORVA F. DAVIS
 Tract _____ Acres 83 Lease No. _____
 Well (Farm) No. 1 Serial No. _____
 Elevation (Spirit Level) 989'
 Quadrangle CENTERPOINT - SC
 County DODDRIDGE District GRANT
 Engineer JOHN W. HAMILTON
 Engineer's Registration No. 2274
 File No. _____ Drawing No. _____
 Date FEB. 25, 1961 Scale 1" = 30 POLES

STATE OF WEST VIRGINIA
 DEPARTMENT OF MINES
 OIL AND GAS DIVISION
 CHARLESTON

WELL LOCATION MAP
 FILE NO. DOD-534
plugged 1/20/61

+ Denotes location of well on United States Topographic Maps, scale 1 to 62,500, latitude and longitude lines being represented by border lines as shown.

- Denotes one inch spaces on border line of original tracing.



STATE OF WEST VIRGINIA
DEPARTMENT OF MINES
OIL AND GAS DIVISION 5

Quadrangle Centerpoint

Permit No. DOD-534

WELL RECORD

Oil or Gas Well Oil
(initials)

Company Hugh K. Spencer, Agent
Address West Union, West Virginia
Farm Orva F. Davis Acres 83
Location (waters) _____
Well No. One Elev. 989'
District Grant County Doddridge
The surface of tract is owned in fee by _____
Address _____
Mineral rights are owned by _____
Address _____
Drilling commenced 6/29/61
Drilling completed 8/21/61
Date Shot _____ From _____ To _____
With _____
Open Flow _____ /10ths Water in _____ Inch
_____ /10ths Merc. in _____ Inch
Volume _____ Cu. Ft.
Rock Pressure _____ lbs. _____ hrs.
Oil _____ bbls., 1st 24 hrs.
WELL ACIDIZED _____
WELL FRACTURED _____

Casing and Tubing	Used in Drilling	Left in Well	and abandoned Packers
Size			Kind of Packer
16			
13			
10 3/4 287' 7" Cosg			Size of
8 1/4 986'			
7" 1816' 9"			Depth set
5 3/16			
3			Perf. top
2			Perf. bottom
Liners Used			Perf. top
			Perf. bottom


CASING CEMENTED	SIZE	No. Ft.	Date
COAL WAS ENCOUNTERED AT		FEET	INCHES
	FEET	INCHES	FEET
	FEET	INCHES	FEET

RESULT AFTER TREATMENT

ROCK PRESSURE AFTER TREATMENT

Fresh Water _____ Feet Salt Water _____ Feet

Formation	Color	Hard or Soft	Top	Bottom	Oil, Gas or Water	Depth	Remarks
Top soil			0	15	Water at	80 Feet	
Slate			15	50	One barrel per hour		
Blue Lime			50	75			
Red Rock			75	85	Water at	1145	
Slate			85	100			
Red Rock			100	149	Water at	1858	
Slate			149	206			
Red Rock			206	212			
Slate			212	286			
Lime			286	340			
Slate			340	490			
Red Rock			490	496			
Slate			486	555			
Lime			555	576			
Sand			576	645			
Red Rock			645	650			
Slate			650	677			
Sand			677	710			
Slate			710	720			
Lime			720	745			
Slate			745	750			
Red Rock			750	790			
Slate			790	855			
Red Rock			855	910			
Slate			910	977			
D. Sand			977	1018			
Slate			1018	1030			
Lime			1030	1202			

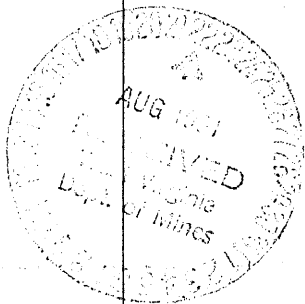

Formation	Color	Hard or Soft	Top ⁵	Bottom	Oil, Gas or Water	Depth Found	Remarks
Sand			1202	1260			
Slate			1260	1312			
Sand			1312	1350			
Slate			1350	1365			
Sand			1365	1385			
Slate			1385	1408			
Sand			1408	1453			
Slate			1453	1460			
Sand			1460	1505			
Slate			1505	1523			
Sand			1523	1630			
Slate			1630	1640			
Sand			1640	1650			
Slate			1650	1690			
Sand			1690	1740			
Slate			1740	1750			
Red Rock			1750	1772			
Slate			1772	1787			
Little Lime			1787	1811			
Pencil Cave			1811	1823			
Big Lime			1823	1903			
Engine Sand			1903	1926			
Lime			1926	1945			
Black Break			1945	1956			
Sand			1956	2002			
Slate			2002	2017			

Date August 22, 1961

APPROVED _____, Owner

By _____
(Title)