


Latitude 39° 25'

Longitude 80° 35'

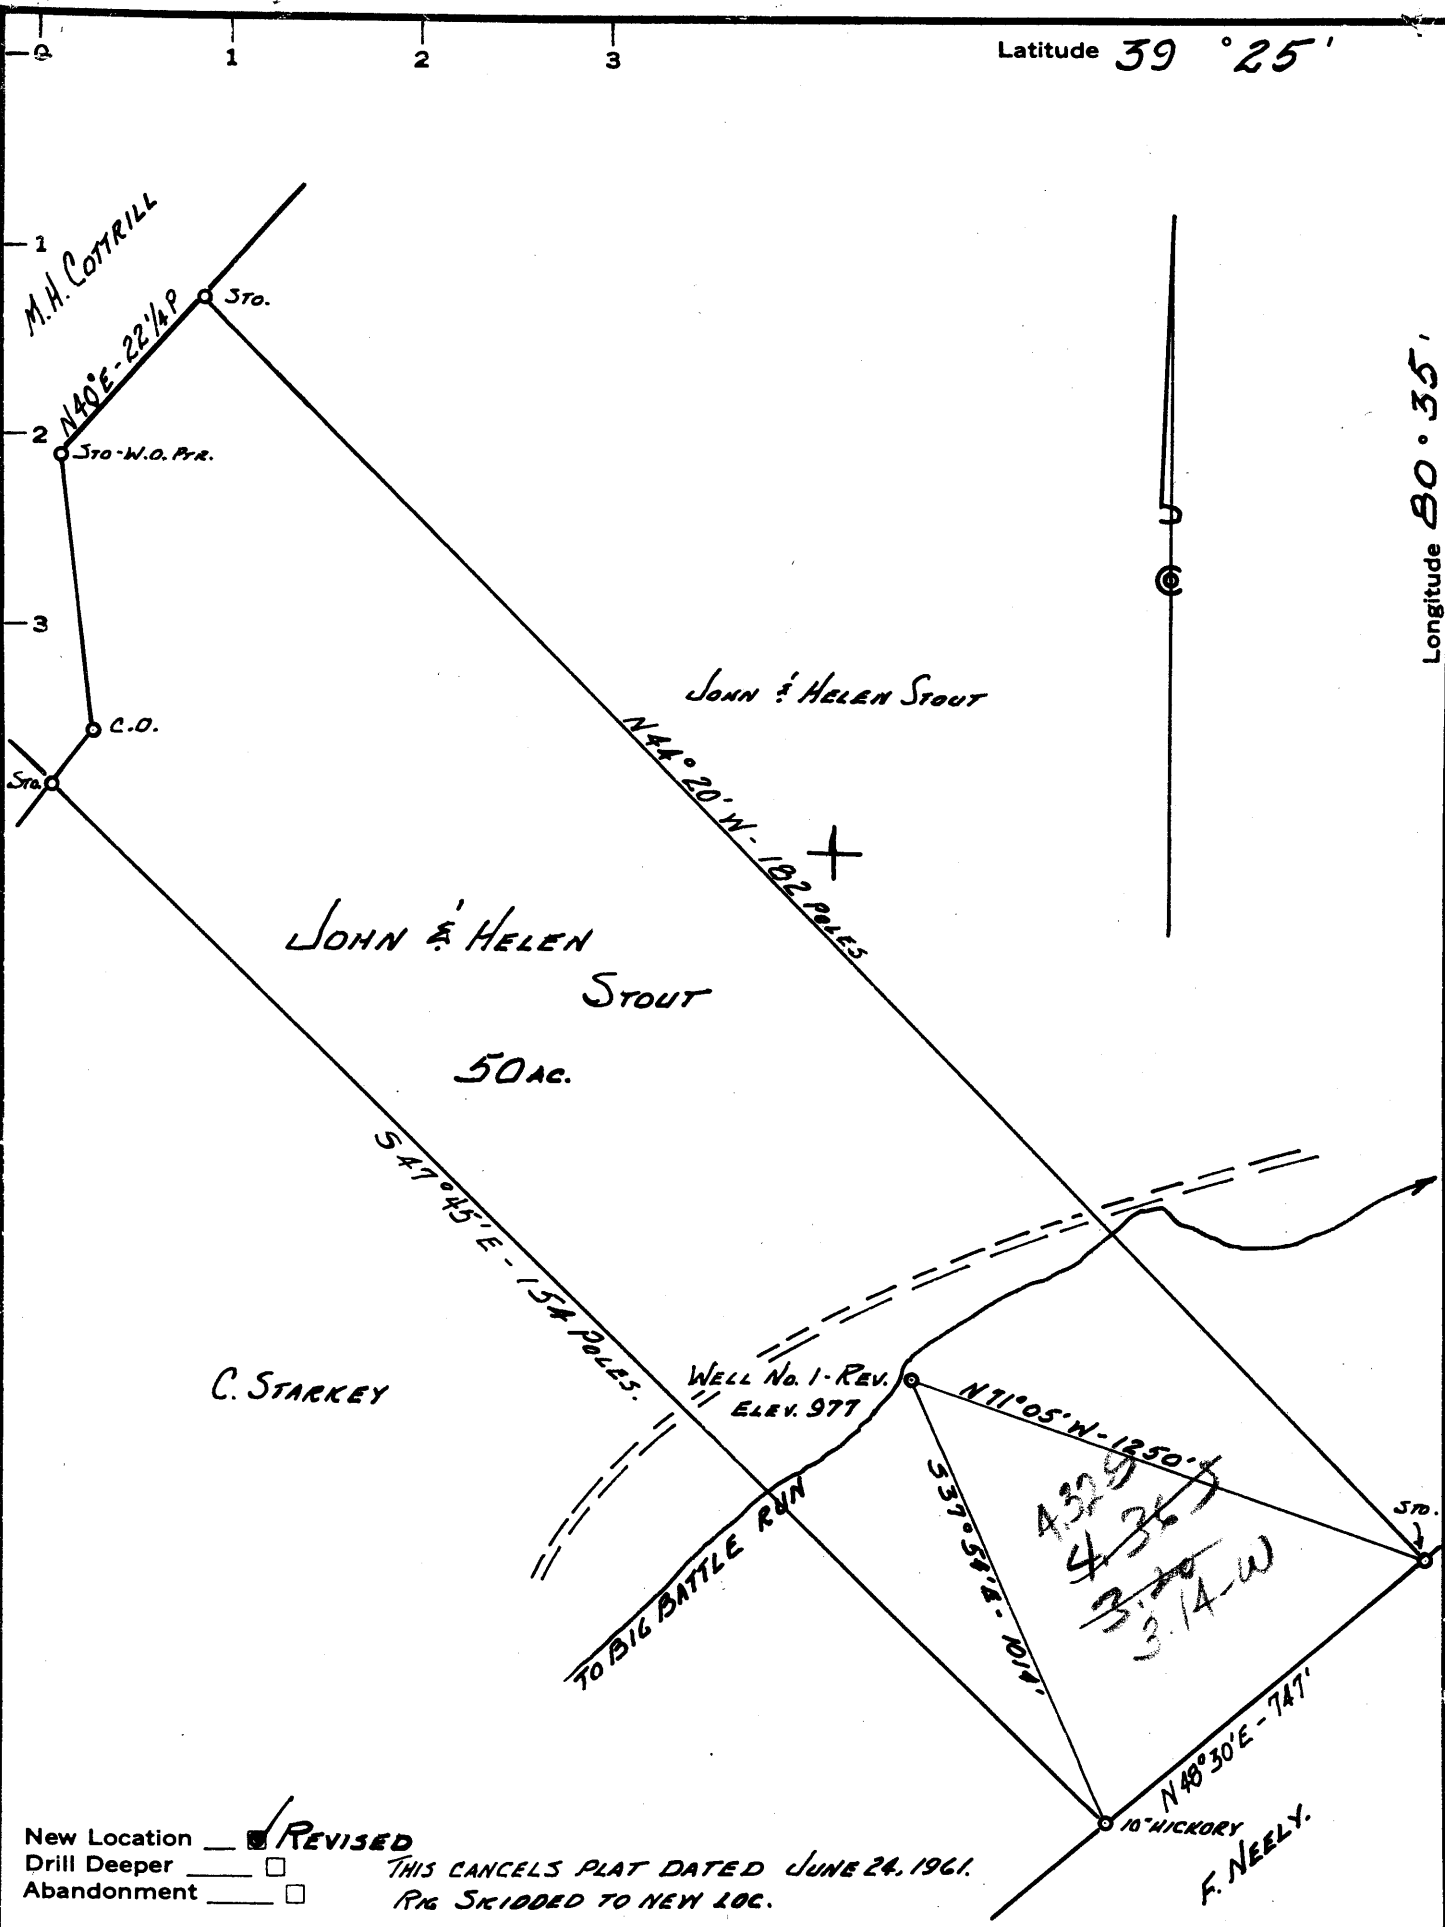

New Location **REVISED**
 Drill Deeper
 Abandonment

THIS CANCELS PLAT DATED JUNE 24, 1961.
 PG SKIPPED TO NEW LOC.

Company B & L DRILLING CO
 Address Box 543 CLARKSBURG, W. VA.
 Farm JOHN & HELEN STOUT
 Tract 1 Acres 50 Lease No. _____
 Well (Farm) No. 1-REV. Serial No. _____
 Elevation (Spirit Level) 977'
 Quadrangle CENTERPOINT - U
 County DODDRIDGE District McLELLAN
 Engineer By: JOHN HAMILTON
 Engineer's Registration No. 2274
 File No. _____ Drawing No. _____
 Date APRIL 11, 1962 Scale 1" = 20 POLES

STATE OF WEST VIRGINIA
 DEPARTMENT OF MINES
 OIL AND GAS DIVISION
 CHARLESTON

WELL LOCATION MAP
 FILE NO. DOD-584-REVISED

+ Denotes location of well on United States Topographic Maps, scale 1 to 62,500, latitude and longitude lines being represented by border lines as shown.

- Denotes one inch spaces on border line of original tracing.

6-6-97



STATE OF WEST VIRGINIA
DEPARTMENT OF MINES
OIL AND GAS DIVISION 4

Centerpoint

Quadrangle DOD-584

Permit No. DOD-584

WELL RECORD

Oil or Gas Well GAS
(KIND)

Company B & L DRILLING
 Address P.O. Box 543 CLARKSBURG W.V.
 Farm STOUT FARM Acres 50
 Location (waters) YAY VEE CAMP DE BIG BATTLE OF MCCLERY
 Well No. 1 Elev. 977'
 District MCCLLEN County DODDRIDGE
 The surface of tract is owned in fee by JOHN STOUT
ALLEARD ST Address CLARKSBURG WVA
 Mineral rights are owned by JOHN STOUT & OTHERS
 Address _____
 Drilling commenced 4-16-62
 Drilling completed 5-26-62
 Date Shot _____ From _____ To _____
 With _____
 Open Flow /10ths Water in _____ Inch
 /10ths Merc. in _____ Inch
 Volume 350 M Cu. Ft.
 Rock Pressure 410 lbs. ONE hrs.
 Oil _____ bbls., 1st 24 hrs.
 WELL ACIDIZED _____
 WELL FRACTURED July 1, 1962 BY DOWELL


Casing and Tubing	Used in Drilling	Left in Well	Packers
16			Kind of Packer _____
13			
10	<u>290</u>		Size of _____
8 1/2	<u>1018</u>		
6 1/2			Depth set _____
5 3/16	<u>2077</u>	<u>2077</u>	
3			Perf. top _____
2			Perf. bottom _____
Liners Used			Perf. top _____
			Perf. bottom _____

CASING CEMENTED _____ SIZE _____ No. Ft. _____ Date _____
 COAL WAS ENCOUNTERED AT _____ FEET _____ INCHES
 _____ FEET _____ INCHES FEET _____ INCHES
 _____ FEET _____ INCHES FEET _____ INCHES

RESULT AFTER TREATMENT 640 M CU. FT.
 ROCK PRESSURE AFTER TREATMENT _____
 Fresh Water _____ Feet Salt Water _____ Feet

Formation	Color	Hard or Soft	Top	Bottom	Oil, Gas or Water	Depth	Remarks
SAND			0	17			
SLATE			17	40	WATER	60'	38 BAILERS PER M.
LIME	DARK		40	72			
LIME	"		72	100			
SLATE			100	112	WATER		
CL. & Red layers			112	128			
SLATE			128	155			
RED ROCK			155	180			
SLATE			180	218			
RED ROCK			218	230			
SLATE SHELLS			230	253			
LIME			253	279			
SLATE			279	296			
LIME			296	335			
RED ROCK			335	343			
SAND			343	379			
LIME			379	416			
SLATE			416	442			
LIME			442	455			
SLATE			455	477			
LIME			477	489			
SLATE			489	517			
LIME			517	521			

(over)

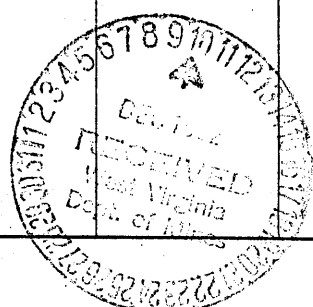

Formation	Color	Hard or Soft	Top #	Bottom	Oil, Gas or Water	Depth Found	Remarks
SAND			521	521			
SLATE+SHELLS			529	574			
SAND			574	616			
SLATE			616	635			
SAND			635	645			
LIME			645	662			
RED ROCK			662	673			
LIME			673	684			
SLATE+SHELLS			684	705			
LIME			705	712			
SLATE+SHELLS			712	720			
RED ROCK			720	737			
LIME			737	765			
RED ROCK			765	805			
SLATE			805	814			
LIME			814	842			
SLATE	DARK		842	875			
RED ROCK			875	885			
SLATE	DARK		885	900			
LIME			900	908			
SAND	SLIGHTLY DARK		908	923			APPROXIMATE LET STAND 12 HRS.
				937			
SLATE	LIGHT		923	1016			
SLATE+SHELL	DARK		937	1021			
SAND			1016	1050			
SLATE			1021	1072			
LIME			1050	1084			
SLATE			1072	1213			
PINK ROCK			1084	1218			
SLATE+SHELL			1084	1262			
LIME			1213	1275			
SAND			1218	1285			
SLATE			1262	1300			
SAND			1275	1322			
SLATE			1285	1370			
SAND			1300	1388			
SLATE+SHELLS			1322	1400			
LIME			1370	1450			
SAND			1388	1520			
SHELLS+LIME			1400	1535			
SAND			1450	1570			
SLATE			1520	1618			
SAND			1535	1618			
BROKEN FRAGMENT			1570	1618			
				1636			
SAND			1618	1735			
SLATE			1636	1768			
SAND			1645	1797			
SLATE			1723	1815			
SAND			1735	1835			
SLATE			1768	1840			
RED ROCK			1797	1905			
SLATE			1815	1944			
LIME			1835	1994			
PENCIL CAVE			1840	2075			
LIME BIC			1840	2078			
SAND IN JUN			1905				
SLATE+SHELLS			1944				
SAND SQUARE			1994				
SAND							
SAND			2075				
SLATE			2075	2078			

Date....., 19.....

APPROVED....., Owner

By.....

(Title)