

Company WORLDWIDE PETROLEUM CORP. - JAMES I. SHEARER - AGT.

Address 260 NEWPORT RD, BLAIRSVILLE, PA.

Farm W. B. TOWNER

Tract 1 Acres 35 Lease No. \_\_\_\_\_

Well (Farm) No. 1 Serial No. \_\_\_\_\_

Elevation (Spirit Level) 1081'

Quadrangle WEST UNION SE

County DODDRIDGE District CENTRAL

Engineer Parker E. Peters

Engineer's Registration No. 485

File No. \_\_\_\_\_ Drawing No. \_\_\_\_\_

Date JULY 11, 1961 Scale 1"=20 P

STATE OF WEST VIRGINIA  
 DEPARTMENT OF MINES  
 OIL AND GAS DIVISION  
 CHARLESTON

**WELL LOCATION MAP**  
 FILE NO. Dod-589

+ Denotes location of well on United States Topographic Maps, scale 1 to 62,500, latitude and longitude lines being represented by border lines as shown.

- Denotes one inch spaces on border line of original tracing.



STATE OF WEST VIRGINIA  
DEPARTMENT OF MINES  
OIL AND GAS DIVISION

Quadrangle West Union

WELL RECORD

Permit No. Dod-589


Oil or Gas Well Gar + oil  
(KIND)

Company <u>Worldwide Petroleum Corporation</u>	Casing and Tubing	Used in Drilling	Left in Well	Packers
Address <u>306 Mutual Savings Building</u>	Size			
<u>815 Throckmorton St., Fort Worth, Texas</u>	16 <u>Conductor</u>		<u>11'</u>	Kind of Packer <u>None</u>
Farm <u>W. B. Towner</u> Acres <u>35</u>	13			
Location (waters) <u>Wilhelms Creek</u>	10	<u>236</u>		Size of
Well No. <u>1</u> Elev. <u>1081</u>	8 1/4	<u>1156</u>		Depth set
District <u>Central</u> County <u>Doddridge</u>	6 3/8			
The surface of tract is owned in fee by <u>W. B. Towner</u> Address <u>Rt. #1, Corning, Ohio</u>	5 3/16	<u>2215</u>	<u>2215</u>	Perf. top <u>2111</u>
Mineral rights are owned by <u>W. B. Towner</u> Address <u>Rt. #1, Corning, Ohio</u>	3			Perf. bottom <u>2132</u>
Drilling commenced <u>11-15-61</u>	2	<u>2215</u>	<u>2215</u>	Perf. top <u>2168</u>
Drilling completed <u>12-30-61</u>				Perf. bottom <u>2172</u>
Date Shot _____ From _____ To _____	Liners Used			
With _____				
Open Flow _____ /10ths Water in _____ Inch				
_____ /10ths Merc. in <u>AF Results</u> Inch				
Volume <u>150,000</u> Cu. Ft.				
Rock Pressure <u>575#</u> lbs. <u>11</u> hrs.				
Oil <u>20 bbls.</u> bbls., 1st 24 hrs.				
WELL ACIDIZED _____				

CASING CEMENTED 5 1/2# SIZE 2215 No. Ft. \_\_\_\_\_ Date \_\_\_\_\_  
1 sks. AquaGel-35 sks. Hi Early Cement DOWELL  
 COAL WAS ENCOUNTERED AT None FEET \_\_\_\_\_ INCHES  
 \_\_\_\_\_ FEET \_\_\_\_\_ INCHES FEET \_\_\_\_\_ INCHES  
 \_\_\_\_\_ FEET \_\_\_\_\_ INCHES FEET \_\_\_\_\_ INCHES

WELL FRACTURED River Frac. Dowell  
SAND - 2 1/4" - 25,000 # Water - 1065 bbls.  
 RESULT AFTER TREATMENT SAND - 1 1/2" - 15,000 #  
 ROCK PRESSURE AFTER TREATMENT \_\_\_\_\_  
 Fresh Water 630 Feet 806-812 Salt Water No record Feet \_\_\_\_\_

Formation	Color	Hard or Soft	Top	Bottom	Oil, Gas or Water	Depth	Remarks
Top Soil			0	5			
Clay			5	15			
Sand			15	30			
Slate			30	40			
Red Rock			40	128			
Lime			128	160			
Red Rock			160	174			
Sand			174	185			
Red Rock			185	235			
Slate			235	245			
Sand			245	250			
Red Rock			250	255			
Slate			255	305			
Red Rock			305	318			
Slate			318	345			
Red Rock			345	355			
Slate			355	365			
Red Rock			365	445			
Lime			445	450			
Red Rock			450	455			
Slate			455	480			
Sand			480	500			
Slate			500	515			
Red Rock			515	545			
Lime	Red		545	555			
Red Rock			555	615			
Sand			615	670	Water	630	
Lime			670	695			
Sand			695	705			
Slate			705	755			

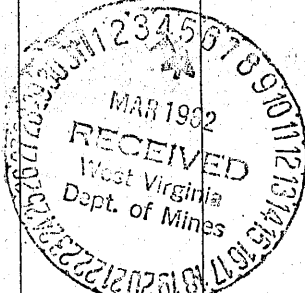

Formation	Color	Hard or Soft	Top $\delta$	Bottom	Oil, Gas or Water	Depth Found	Remarks
Lime			755	765			
Slate			765	770			
Lime			770	783			
Slate			783	806			
Sand			806	812	Water	806-812	
Slate			812	832			
Lime			832	837			
Red Rock			837	840			
Lime			840	885			
Red Rock			885	895			
Slate			895	925			
Red Rock			925	985			
Lime			985	1008			
Red Rock			1008	1042			
Sand			1042	1072			
Slate			1072	1100			
Red Rock			1100	1150			
Lime			1150	1170			
Sand			1170	1185			
Slate			1185	1198			
Pink Rock			1198	1202			
Slate			1202	1215			
Lime			1215	1235			
Slate & Shells			1235	1370			
Sand			1370	1405			
Slate & Shells			1405	1425			
Sand - 1st			1425	1485			
Slate			1485	1518			
Sand - 2nd			1518	1597			
Slate			1597	1618			
Sand - 3rd			1618	1670			
Slate & Shells			1670	1783			
Sand			1783	1815			
Lime			1815	1845			
Sand			1845	1860			
Slate			1860	1870			
Sand			1870	1880			
Slate			1880	1890			
Sand			1890	1897			
Slate			1897	1950			
Pink Rock			1950	1990			
Slate			1990	2000			
Lime			2000	2015			
Slate			2015	2038			
Lime			2038	2111			
Sand			2111	2180	Show of Oil	2111-2117	
Slate			2180	2215			
TD				2215			

Date \_\_\_\_\_, 19\_\_\_\_

APPROVED James S. Shearer Agent, Owner

By \_\_\_\_\_

(Title)