


Latitude 39 20' Longitude 80 50'

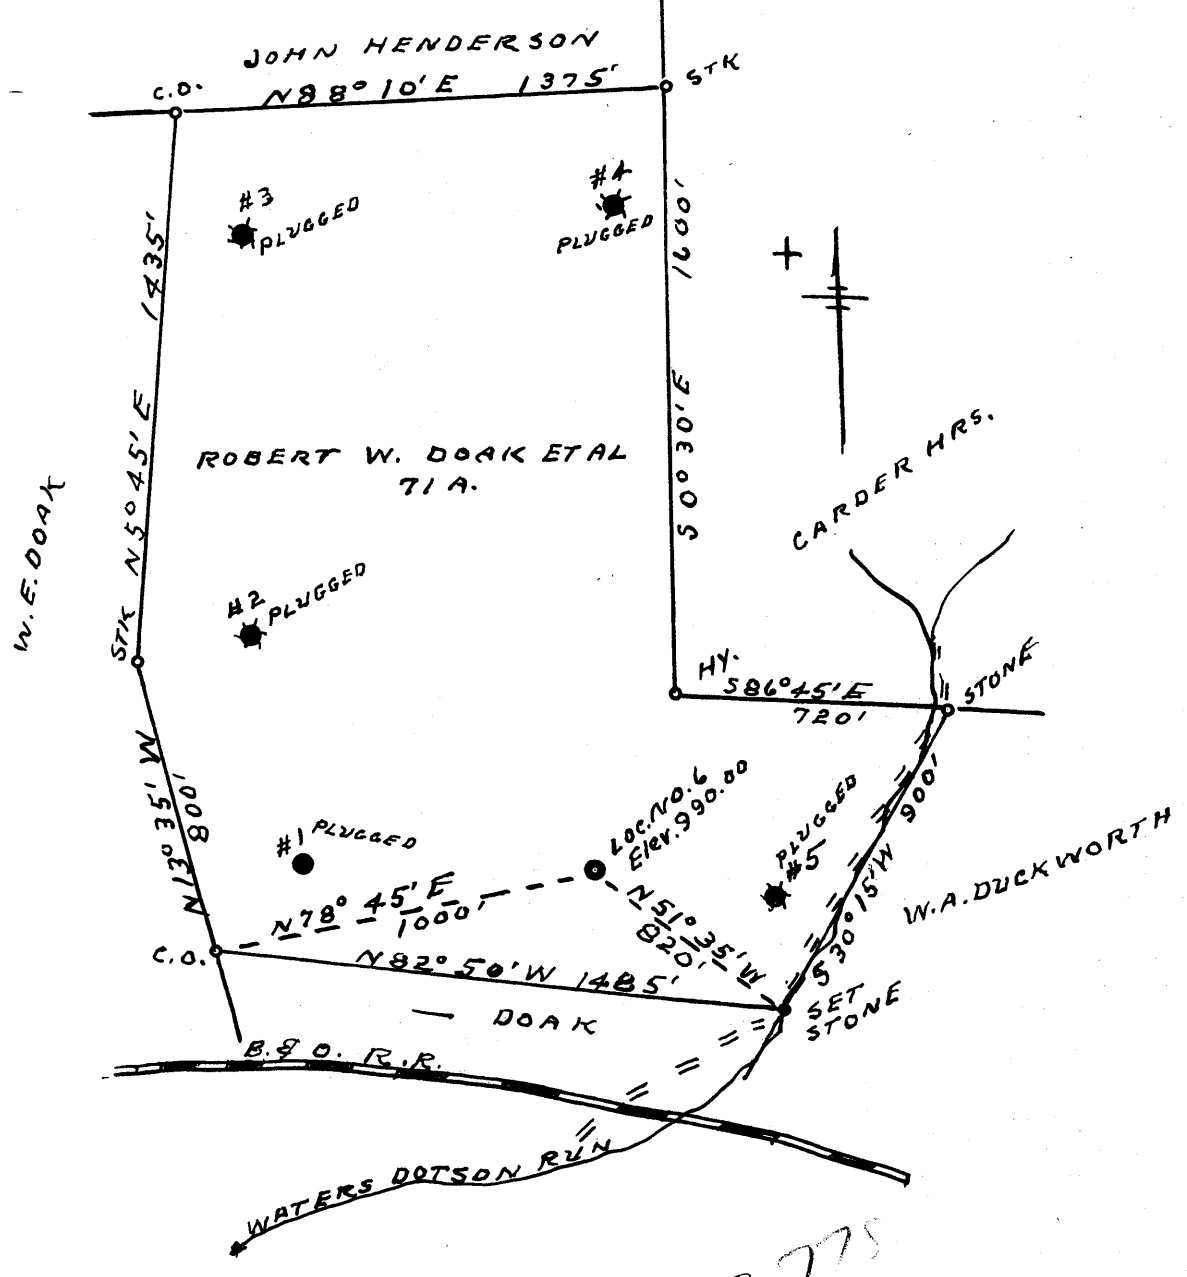

- New Location .
- Drill Deeper
- Redrill
- Abandonment

3,775
2,44

Company L. C. YOUNG
 608 FIRST NATL. BANK TRUST CO.
 Address LEXINGTON, KY.

Farm ROBERT W. DOAK ETAL

Tract _____ Acres 71 Lease No. _____

Well (Farm) No. 6 Serial No. _____

Elevation (Spirit Level) 990.00

Quadrangle WEST UNION-SC

County DOODRIDGE District CENTRAL

Engineer L. F. Dye

Engineer's Registration No. 804

File No. _____ Drawing No. _____

8-15-61 Scale 1" = 500'

STATE OF WEST VIRGINIA
 DEPARTMENT OF MINES
 OIL AND GAS DIVISION
 CHARLESTON

WELL LOCATION MAP

FILE NO. DOD-604

— Denotes location of well on United States Topographic Maps, scale 1 to 62,500, latitude and longitude lines being represented by border lines as shown.

— Denotes one inch spaces on border line of original tracing.



STATE OF WEST VIRGINIA
DEPARTMENT OF MINES
OIL AND GAS DIVISION 3

Quadrangle West Union

Permit No. DOD-604

WELL RECORD

Oil or Gas Well Oil
(KIND)

Company L. C. Young - 608 First Natl. Bank Bldg.
Address Lexington, Ky.
Farm Robt. W. Doak, et.al Acres 71
Location (waters) _____
Well No. 6 Elev. 990'
District Central County Doddridge
The surface of tract is owned in fee by Robt. W. Doak, et.al
R.R.#1 Address Vienna, Ohio
Mineral rights are owned by Robt. W. Doak, et.al
R.R.#1 Address Vienna, Ohio
Drilling commenced Sept. 25, 1961
Drilling completed Nov. 10, 1961
Date Shot _____ From _____ To _____
With _____
Open Flow _____ /10ths Water in _____ Inch
_____ /10ths Merc. in _____ Inch
Volume _____ Cu. Ft.
Rock Pressure _____ lbs. _____ hrs.
Oil _____ bbls., 1st 24 hrs.
WELL ACIDIZED _____
WELL FRACTURED Yes See note below

Casing and Tubing	Used in Drilling	Left in Well	Packers
Size			Kind of Packer
16			
13			
8 3/4			Size of
6 3/4 985			Depth set
5 3/4 1895			
3			Perf. top
2			Perf. bottom
Liners Used			Perf. top
			Perf. bottom

CASING CEMENTED 5 1/2 cemented from 1974' to 1935
SIZE _____ No. Ft. _____ Date _____
COAL WAS ENCOUNTERED AT _____ FEET _____ INCHES
_____ FEET _____ INCHES _____ FEET _____ INCHES
_____ FEET _____ INCHES _____ FEET _____ INCHES

RESULT AFTER TREATMENT Not yet determined 1 1/2 bbls.
ROCK PRESSURE AFTER TREATMENT 100#
Fresh Water _____ Feet Salt Water _____ Feet

Formation	Color	Hard or Soft	Top	Bottom	Oil, Gas or Water	Depth	Remarks
Rep R			0	80			
Sand			80	125			
B. Slate			125	170			
Sand			170	185			
B. Slate			185	210			
Sand			210	285			
B. Slate			285	310			
Slate			310	330			
Sand			330	530			
R. Rock			530	540			
Blue Slate			540	613			
Sand			613	665			
Blue Slate			665	670			
Sand			670	695			
Blue Shale			695	730			
Shale & R.R.			730	785			
Sand			785	845			
R. Rock			845	870			
Sand			870	1005			
Sand & Slate			1005	1090			
Sand			1090	1105			
Brown Shale			1105	1115			
R. Rock			1115	1120			
Sand			1120	1320			
Shale			1320	1325			
Sand			1325	1450			
Slate			1450	1465			
Sand			1465	1655			
B. Shale			1655	1770			

The well was fractured with 900# of water, 38,000# of sand, and 700 gallons of acid.

Formation	Color	Hard or Soft	Top <i>3</i>	Bottom	Oil, Gas or Water	Depth Found	Remarks
W. Sand			1770	1820			
Lime			1820	1935			
Sand			1935	2004			
Total Depth				2004			1940-Show of gas & oil Filled up to 1974 Finished 4-3/4" hole

Date Dec. 29, 19 61

APPROVED _____, Owner

By Owner (Title)