

Derivation of Elevation
 B.M. (U.S.G.S.) of Blandville
 Elevation = 830'

Goldie Kelley

- New Location
- Drill Deeper
- Abandonment

Company Paul McCutcheon
 Address West Union, W. Va.
 Farm Goldie Kelley
 Tract _____ Acres 26 Lease No. _____
 Well (Farm) No. One Serial No. _____
 Elevation (Spirit Level) 1107
 Quadrangle Centerpoint SW
 County Doddridge District New Milton
 Engineer W. H. H. J.
 Engineer's Registration No. 1227
 File No. _____ Drawing No. _____
 Date March 27 '63 Scale 1" = 300'

STATE OF WEST VIRGINIA
 DEPARTMENT OF MINES
 OIL AND GAS DIVISION
 CHARLESTON

WELL LOCATION MAP
 FILE NO. Dod-629 Revised Location

+ Denotes location of well on United States Topographic Maps, scale 1 to 62,500, latitude and longitude lines being represented by border lines as shown.

- Denotes one inch spaces on border line of original tracing.



STATE OF WEST VIRGINIA
DEPARTMENT OF MINES
OIL AND GAS DIVISION 7

Quadrangle Centerpoint

Permit No. DOD-629-Rev.

WELL RECORD

Oil or Gas Well Gas
(KIND)

Company Paul McCutchan
Address P. O. Box 144, West Union, W. Va.
Farm Goldie Kelley Acres 26
Location (waters) Sugar Camp Run
Well No. 1 Elev. 1107'
District New Milton County Doddridge
The surface of tract is owned in fee by Goldie Kelley
Address _____
Mineral rights are owned by Goldie Kelley and P. D. Farr
Address West Union, W. Va.
Drilling commenced 4/22/63
Drilling completed 6/10/63
Date Shot _____ From _____ To _____
With _____

Casing and Tubing	Used in Drilling	Left in Well	Packers
Size			Kind of Packer
16			
13			
10	471 ft.		Size of
8 1/2	1123 ft.		
6 3/4	920 ft.	X	Depth set
4 1/2	2,264 ft.	X	
3			Perf. top
2			Perf. bottom
Liners Used			Perf. top
			Perf. bottom

Open Flow /10ths Water in _____ Inch
/10ths Merc. in _____ Inch

Volume _____ Cu. Ft.

Rock Pressure _____ lbs. _____ hrs.

Oil _____ bbls., 1st 24 hrs.

WELL ACIDIZED _____


WELL FRACTURED June 29, 1963

RESULT AFTER TREATMENT 400,000 cu. ft. gas

ROCK PRESSURE AFTER TREATMENT 250 lbs. 24 hrs.

Fresh Water _____ Feet Salt Water _____ Feet

Formation	Color	Hard or Soft	Top	Bottom	Oil, Gas or Water	Depth	Remarks
Clay			0	14			
Rock			14	30			
Lime			30	60			
Slate			60	68			
Red Rock			68	86			
Lime			86	105			
Slate			105	140			
Red Rock			140	150			
Lime			150	160			
Slate & Shells			160	163			
Sand			163	174			
Slate & Shells			174	205			
Slate Shells			205	207			
Slate & Shells			207	254			
Red Rock			254	268			
Slate & Shells			268	272			
Lime			272	275			
R. Rock			295	301			
Lime			301	320			
Slate			320	346			
Lime			346	367			
Sand			367	382			
R. Rock			382	425			
Lime			425	470			
Lime			470	479			
R. Rock			479	500			
Lime			500	504			
P. Lime			504	520			
R. Rock			520	530			
Lime			530	533			

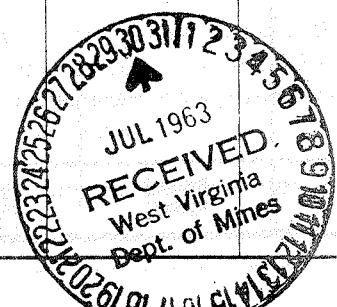

Formation	Color	Hard or Soft	Top ⁷	Bottom	Oil, Gas or Water	Depth Found	Remarks
Sand			533	540			
Lime			540	669			
Sand			669	680			
Lime			680	686			
Slate	Shells		686	700			
Lime			700	710			
Slate			710	794			
Sand			794	800			
Lime			800	814			
Sand			814	827			
Lime			827	867			
R. Rock			867	885			
Lime			885	913			
R. Rock			913	942			
Lime (Pink)			942	978			
Sand			978	994			
Lime			994	1132			
Sand			1132	1142			
Slate	& Shells		1142	1196			
Sand			1196	1220			
Broken Lime			1220	1259			
Slate	& Shells		1259	1280			
Lime			1280	1363			
Sand			1363	1383			
Lime			1383	1449			
P. Slate			1449	1465			
Lime			1465	1503			
Sand			1503	1554			
Slate			1554	1572			
Sand			1572	1610			
Slate			1610	1620			
Sand			1620	1707			
Lime	Black		1707	1726			
Sand			1726	1736			
Lime			1736	1757			
Slate	Shells		1757	1797			
Gritty Lime			1797	1826			
Sand			1826	1880			
Slate	& Shells		1880	1910			
Gritty Lime			1910	1968			
Slate	& Shells		1968	1992			
R. Rock			1992	2004			
Lime			2004	2018			
Sand			2018	2028			
R. Rock			2028	2032			
Lime			2032	2042			
Slate	& Shells		2042	2054			
Lime (Little)			2054	2069			
Pencil Cave			2069	2097			
Big Lime			2097	2145			
Big Injun Sand			2145	2235	Gas		

Date July 29, 1963
APPROVED Paul M. Cutler, Owner
By _____ (Title)