

New Location
 Drill Deeper
 Abandonment Issued 8-30-74

CORRECTION -- ELEVATIONS

Company FERRELL L. PRIOR
 Address 700 Union Trust Bldg. Parkersburg, West Va.
 Farm Mary Walton
 Tract _____ Acres 211.945 Lease No. _____
 Well (Farm) No. Three - Four Serial No. _____
 Elevation (Spirit Level) No. 3 - 1034'
No. 4 - 1096'
 Quadrangle Kadis NW
 County Doddridge District New Milton
 Engineer W. H. Hest
 Engineer's Registration No. 1227
 File No. _____ Drawing No. _____
 Date January 1967 Scale 1" = 400' = 660'

STATE OF WEST VIRGINIA
 DEPARTMENT OF MINES
 OIL AND GAS DIVISION
 CHARLESTON

WELL LOCATION MAP

FILE NO. Dev - 703 - # 3 - P
Dev - 704 - # 4 - P

+ Denotes location of well on United States Topographic Maps, scale 1 to 62,500, latitude and longitude lines being represented by border lines as shown.
 - Denotes one inch spaces on border line of original tracing.



STATE OF WEST VIRGINIA
DEPARTMENT OF MINES
OIL AND GAS DIVISION 14

Quadrangle Vadis
Permit No. DOD - 704

WELL RECORD

Oil or Gas Well Oil
(KIND)

Company Ferrell L. Prior
Address 720 Union Trust Bldg. Parkersburg, W. Va.
Farm Mary Walton Acres 211.945
Location (waters) Tom's Fork
Well No. Four Elev. 1096'
District New Milton County Doddridge
The surface of tract is owned in fee by Mary Walton
New Milton Address W. Va.
Mineral rights are owned by Mary Walton
New Milton Address W. Va.
Drilling commenced January 28, 1962
Drilling completed January 7, 1962
Date Shot _____ From _____ To _____
With _____
Open Flow /10ths Water in _____ Inch
/10ths Merc. in _____ Inch
Volume _____ Cu. Ft.
Rock Pressure Not taken lbs. _____ hrs.
Oil Show bbls., 1st 24 hrs.
WELL ACIDIZED 200 gal.


| Casing and Tubing | Used in Drilling | Left in Well | Packers |
|-------------------|------------------|--------------|-------------------|
| Size | | | Kind of Packer |
| 16 | | | |
| 18 | | | |
| 10 | 40 | 40 | Size of |
| 8 3/4 | | | |
| 6 3/4 | | | Depth set |
| 5 3/16 | | | |
| 4 1/2 | 2206' | 2206' | Perf. top 2157 |
| 2 | | | Perf. bottom 2159 |
| Liners Used | | | Perf. top 2167 |
| | | | Perf. bottom 2169 |

CASING CEMENTED 4 1/2 SIZE 2206 No. Ft. 2/7/62 Date
60 sks. cement LAWSON
COAL WAS ENCOUNTERED AT None FEET _____ INCHES
_____ FEET _____ INCHES FEET _____ INCHES
_____ FEET _____ INCHES FEET _____ INCHES

WELL FRACTURED 550 bbls. water 22,000 lbs. sand
Well drilled with Rotary Circulating Gel

RESULT AFTER TREATMENT 60 bbls. oil
ROCK PRESSURE AFTER TREATMENT 645 lbs. 24 hours
Fresh Water _____ Feet _____ Salt Water _____ Feet _____

| Formation | Color | Hard or Soft | Top | Bottom | Oil, Gas or Water | Depth | Remarks |
|----------------------|-------|--------------|-----|--------|-------------------|-------|---------|
| Clay | | | 0 | 11 | | | |
| Red rock | | | 11 | 31 | | | |
| Sand rock | | | 31 | 49 | | | |
| Red rock | | | 49 | 60 | | | |
| Shale | | | 60 | 72 | | | |
| Red rock | | | 72 | 85 | | | |
| Shale | | | 85 | 96 | | | |
| White sand | | | 96 | 110 | | | |
| Shale | | | 110 | 130 | | | |
| Lime | | | 130 | 138 | | | |
| Shale | | | 138 | 187 | | | |
| Red rock | | | 187 | 218 | | | |
| Shale | | | 218 | 224 | | | |
| Red rock | | | 224 | 269 | | | |
| Sand | | | 269 | 305 | | | |
| Shale | | | 305 | 311 | | | |
| Red rock | | | 311 | 331 | | | |
| Sandy lime | | | 331 | 334 | | | |
| Red rock | | | 334 | 357 | | | |
| Lime | | | 357 | 365 | | | |
| Shale | | | 365 | 386 | | | |
| Shale & lime | | | 386 | 420 | | | |
| Red rock | | | 420 | 439 | | | |
| Shale, lime & shells | | | 439 | 442 | | | |
| Lime | | | 442 | 449 | | | |

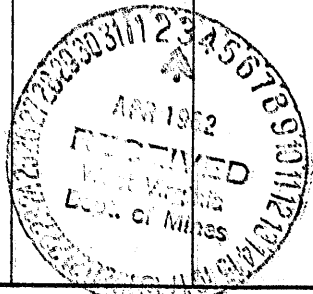

| Formation | Color | Hard or Soft | Top / 4 | Bottom | Oil, Gas or Water | Depth Found | Remarks |
|---------------------|-------|--------------|---------|--------|-------------------|-------------|---------|
| Lime shells & shale | | | 449 | 456 | | | |
| Red rock | | | 456 | 471 | | | |
| Lime | | | 471 | 489 | | | |
| Red rock | | | 489 | 515 | | | |
| Sandy lime | | | 515 | 525 | | | |
| Sand | | | 525 | 587 | | | |
| Sandy shale & lime | | | 587 | 617 | | | |
| Hard sand | | | 617 | 628 | | | |
| Broken Sand | | | 628 | 646 | | | |
| Shale & lime shells | | | 646 | 662 | | | |
| Shale | | | 662 | 671 | | | |
| Lime | | | 671 | 685 | | | |
| Sandy shale & lime | | | 685 | 694 | | | |
| Shale | | | 694 | 713 | | | |
| Shale & lime shells | | | 713 | 802 | | | |
| Red rock | | | 802 | 829 | | | |
| Shale | | | 829 | 856 | | | |
| Red rock | | | 856 | 914 | | | |
| Sand & slate | | | 914 | 927 | | | |
| Slate & lime shell | | | 927 | 937 | | | |
| Red rock & shale | | | 937 | 1072 | | | |
| Red rock | | | 1072 | 1083 | | | |
| Broken sand | | | 1083 | 1091 | | | |
| Shale | | | 1091 | 1112 | | | |
| Lime shells & shale | | | 1112 | 1157 | | | |
| Shale | | | 1157 | 1176 | | | |
| Shale & lime shells | | | 1176 | 1221 | | | |
| Gritty lime | | | 1221 | 1249 | | | |
| Shale | | | 1249 | 1289 | | | |
| Lime & sandy shale | | | 1289 | 1307 | | | |
| Sand | | | 1307 | 1342 | | | |
| Sandy lime | | | 1342 | 1391 | | | |
| Sandy shale | | | 1391 | 1464 | | | |
| Sandy shale | | | 1464 | 1487 | | | |
| Sand | | | 1487 | 1492 | | | |
| Shale Sandy | | | 1492 | 1571 | | | |
| Sand & shale | | | 1571 | 1705 | | | |
| Sand | | | 1705 | 1726 | | | |
| Sandy shale | | | 1726 | 1729 | | | |
| Broken sand | | | 1729 | 1748 | | | |
| Sand & slate | | | 1748 | 1776 | | | |
| Sandy slate | | | 1776 | 1820 | | | |
| Black slate | | | 1820 | 1841 | | | |
| Sand & slate | | | 1841 | 1860 | | | |
| Slate & shells | | | 1860 | 1935 | | | |
| Lime | | | 1935 | 1976 | | | |
| Sand & shale | | | 1976 | 1998 | | | |
| Slate & lime | | | 1998 | 2009 | | | |
| Blue Monday | | | 2009 | 2034 | | | |
| Big Lime | | | 2034 | 2087 | | | |
| Sand | | | 2087 | 2155 | | | |
| Shale | | | 2155 | 2174 | Oil & gas | | |
| | | | 2174 | 2209 | | | |

Date April 2, 1962

APPROVED Herold L. Prior Owner

By _____

(Title)