

- Redrill.....
- New Location.
- Drill Deeper.....
- Abandonment.....

Company HENRY O. GOSSETT JR.  
 Address LONGVIEW, TEXAS  
 Farm CHAS. B. SMITH  
 Tract \_\_\_\_\_ Acres 75 Lease No. \_\_\_\_\_  
 Well (Farm) No. 2 Serial No. 1  
 Elevation (Spirit Level) 984' VA.  
 Quadrangle CENTERPOINT SW1/4  
 County DODDRIDGE District GRANT  
 Engineer James D. Jeffries  
 Engineer's Registration No. 1084  
 File No. 209/36 Drawing No. \_\_\_\_\_  
 Date 2-28-62 Scale 1" = 500'

STATE OF WEST VIRGINIA  
 DEPARTMENT OF MINES  
 OIL AND GAS DIVISION  
 CHARLESTON

**WELL LOCATION MAP**  
 FILE NO. DOD-739

+ Denotes location of well on United States Topographic Maps, scale 1 to 62,500, latitude and longitude lines being represented by border lines as shown.

— Denotes one inch spaces on border line of original tracing.



STATE OF WEST VIRGINIA  
DEPARTMENT OF MINES  
OIL AND GAS DIVISION **4**

Quadrangle Centerpoint

Permit No. DOD-739

**WELL RECORD**

Oil or Gas Well Gas well  
*oil show*  
*+ Gas well*  
(KIND)

Company Henry O. Gossett, Jr.  
Address P. O. Box 88 Longview, Texas  
Farm Charles B. Smith Acres 75  
Location (waters) \_\_\_\_\_  
Well No. 1 Elev. 984  
District Grant County Doddridge  
The surface of tract is owned in fee by \_\_\_\_\_  
Address \_\_\_\_\_  
Mineral rights are owned by Enza B. Smith, Rt. 2,  
Box 53, West Union Address West Virginia  
Drilling commenced March 29, 1962  
Drilling completed April 30, 1962  
Date Shot \_\_\_\_\_ From \_\_\_\_\_ To \_\_\_\_\_  
With \_\_\_\_\_  
Open Flow \_\_\_\_\_ /10ths Water in \_\_\_\_\_ Inch  
\_\_\_\_\_ /10ths Merc. in \_\_\_\_\_ Inch  
Volume 40,000 Cu. Ft.  
Rock Pressure not taken lbs. \_\_\_\_\_ hrs.  
Oil \_\_\_\_\_ bbls., 1st 24 hrs.  
WELL ACIDIZED \_\_\_\_\_


Casing and Tubing	Used in Drilling	Left in Well	Packers
Size			Kind of Packer
16			
13 3/8	24.80	24.80	
10 3/4	207.99	none	Size of
8 1/2 5/8	796.00	none	
<del>X 7</del>	1664		Depth set
<del>X 4 1/2</del>	2165	2165	
3			Perf. top
2			Perf. bottom
Liners Used			Perf. top
			Perf. bottom

CASING CEMENTED 4 1/2 SIZE 2165 No. Ft. 4-30-62 Date  
40 S/c cement 5 aquagel  
COAL WAS ENCOUNTERED AT none FEET \_\_\_\_\_ INCHES  
\_\_\_\_\_ FEET \_\_\_\_\_ INCHES \_\_\_\_\_ FEET \_\_\_\_\_ INCHES  
\_\_\_\_\_ FEET \_\_\_\_\_ INCHES \_\_\_\_\_ FEET \_\_\_\_\_ INCHES

WELL FRACTURED May 13, 1962 48000 lbs. sand 972 bbls water 500 gal acid

RESULT AFTER TREATMENT Estimated 3,700,000 cf 1 B.O.D.  
ROCK PRESSURE AFTER TREATMENT 525 lbs shut in 24 hours  
Fresh Water none Feet \_\_\_\_\_ Salt Water none Feet \_\_\_\_\_

Formation	Color	Hard or Soft	Top	Bottom	Oil, Gas or Water	Depth	Remarks
Clay			0	5			
Red Rock			5	38			
Shale			38	44			
Red Rock			44	64			
Lime			64	73			
Shale			73	85			
Lime			85	90			
Red Rock			90	95			
Lime			95	115			
Shale			115	141			
Red Rock			141	146			
Lime			146	165			
Shale			165	190			
Red Rock			190	195			
Shale			195	208			
Lime			208	224			
Shale			224	276			
Lime			276	287			
Red Rock			287	302			
Shale			302	320			
Red Rock			320	335			
Sand			335	342			
Shale			342	359			
Lime			359	382			
Shale			382	388			
Red Rock			388	396			
Sand			396	412			
Lime			412	487			
Shale & Shells			487	515			
Lime			515	525			

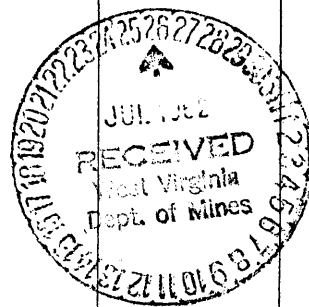

Formation	Color	Hard or Soft	Top #	Bottom	Oil, Gas or Water	Depth Found	Remarks
Shale			525	543			
Red Rock			543	554			
Lime			554	651			
Shale, Sandy			651	707			
Lime			707	718			
Shale & Red Rock			718	739			
Lime			739	760			
Sand			760	782			
Shale			782	801			
Lime			801	810			
Red Rock			810	814			
Shale & Shells			814	895			
Lime			895	900			
Shale			900	941			
Lime			941	980			
Shale & Shells			980	1057			
Lime			1057	1098			
Shale, Sandy			1098	1420			
Lime, sandy			1420	1450			
Shale & Sand			1450	1500			
Sand			1500	1569			
Shale, Sandy			1569	1660			
Lime			1660	1668			
Slate			1668	1672			
Sand			1672	1800			
Lime			1800	1806			
Shale			1806	1840			
Lime			1840	1873			
Sand			1873	1930			
Big Lime			1930	1958			
Sand			1958	1965			
Lime			1965	2020			
Sand			2020	2100			
Shale			2100	2167			
Total Depth				2167			

Date 7-13-64, 1964

APPROVED [Signature], Owner

By \_\_\_\_\_ (Title)