

New Location...   
 Drill Deeper.....   
 Abandonment.....

Company DEVONIAN GAS & OIL CO  
 Address 2003 COMMONWEALTH BLDG. PITTSBURG 22, PA.  
 Farm S.A. HURST JR.  
 Tract \_\_\_\_\_ Acres 69 Lease No. \_\_\_\_\_  
 Well (Farm) No. 9 Serial No. \_\_\_\_\_  
 Elevation (Spirit Level) 1126  
 Quadrangle VAD15 NW  
 County Doddridge District New Milton  
 Engineer A.L. Marshall - Surveyor  
 Engineer's Registration No. 2492  
 File No. \_\_\_\_\_ Drawing No. \_\_\_\_\_  
 Date MAY 10, 1962 Scale 1" = 300'

STATE OF WEST VIRGINIA  
 DEPARTMENT OF MINES  
 OIL AND GAS DIVISION  
 CHARLESTON

**WELL LOCATION MAP**  
 FILE NO. DOD-788

+ Denotes location of well on United States Topographic Maps, scale 1 to 62,500, latitude and longitude lines being represented by border lines as shown.

- Denotes one inch spaces on border line of original tracing.



STATE OF WEST VIRGINIA  
DEPARTMENT OF MINES  
OIL AND GAS DIVISION

Quadrangle Vadis

Permit No. Dod 788

**WELL RECORD**

Oil or Gas Well Oil & Gas

Company Devonian Gas & Oil Company  
Address 1112 Benedum Trees Bldg., Pgh. 22, Pa.  
Farm S. A. Hurst, Jr. et ux. Acres 69  
Location (waters) Tom's Fork  
Well No. 9 Elev. 1126 Gr.  
District New Milton County Doddridge  
The surface of tract is owned in fee by S. A. Hurst, Jr. et ux  
102 Beech St. Address West Union, W. Va.  
Mineral rights are owned by S. A. Hurst, Jr. et ux same  
J. C. Dicks et ux Address Petroleum, W. Va.

Drilling commenced 9-15-62  
Drilling completed 10-2-62  
Date Shot 10-6-62 From 2191 To 2201  
With 16 - 1" holes

Open Flow /10ths Water in \_\_\_\_\_ Inch  
/10ths Merc. in \_\_\_\_\_ Inch

Volume \_\_\_\_\_ Cu. Ft.

Rock Pressure \_\_\_\_\_ lbs. \_\_\_\_\_ hrs.

Oil \_\_\_\_\_ bbls., 1st 24 hrs.

WELL ACIDIZED 500 gal. MCA

WELL FRACTURED 1200 bbl. water 50,000 # 20-40 sd, 10,000 # 10-20 sd.  
500 # walnut hulls

RESULT AFTER TREATMENT 50 BOPD and 750 MCF

ROCK PRESSURE AFTER TREATMENT 600

Fresh Water \_\_\_\_\_ Feet Salt Water \_\_\_\_\_ Feet

| Casing and Tubing | Used in Drilling | Left in Well | Packers        |
|-------------------|------------------|--------------|----------------|
| Size              |                  |              | Kind of Packer |
| 16                |                  |              |                |
| 13                |                  |              |                |
| 10 3/4            | 53               | 53           | Size of        |
| 8 1/4             |                  |              |                |
| 6 3/8             |                  |              | Depth set      |
| 5 3/8 x 1/2       |                  | 2333         |                |
| 3                 |                  |              | Perf. top      |
| 2                 |                  | 2170         | Perf. bottom   |
| Liners Used       |                  |              | Perf. top      |
|                   |                  |              | Perf. bottom   |


CASING CEMENTED 5 1/2 SIZE 2333 No. Ft. 10-2-62 Date

Cementing data attached herewith  
100 sks. cement-6 sks. aquagel-Halliburton  
COAL WAS ENCOUNTERED AT \_\_\_\_\_ FEET \_\_\_\_\_ INCHES

\_\_\_\_\_ FEET \_\_\_\_\_ INCHES FEET \_\_\_\_\_ INCHES

\_\_\_\_\_ FEET \_\_\_\_\_ INCHES FEET \_\_\_\_\_ INCHES

| Formation    | Color      | Hard or Soft | Top    | Bottom | Oil, Gas or Water   | Depth | Remarks |
|--------------|------------|--------------|--------|--------|---|-------|---------|
| Gravel       | red        | soft         | 0      | 50     | No water noticeable due to hole being full at all times with rotary mud |       |         |
| Shale & sand | grey       | hard         | 50     | 70     |   |       |         |
| Shale & sand | red        | soft         | 70     | 235    |   |       |         |
| Shale & sand | green-red  | medium       | 235    | 430    |   |       |         |
| Sand         | yellow     | hard         | 430    | 570    |   |       |         |
| Shale        | grey       | soft         | 570    | 910    |   |       |         |
| Shale        | black      | soft         | 910    | 1150   |   |       |         |
| Shale        | grey       | soft         | 1150   | 1315   |   |       |         |
| Sand         | clear-tan  | hard         | 1315   | 1405   |   |       |         |
| Line & shale | grey       | hard         | 1405   | 1500   |   |       |         |
| Shale, silty | light      | soft         | 1500   | 1540   | None  |       |         |
| Sand         | Tan        | hard         | 1540   | 1605   |   |       |         |
| Silt, shale  | grey       | medium       | 1605   | 1700   |   |       |         |
| Shale        | lt. grey   | medium       | 1700   | 1745   |   |       |         |
| Sand         | white      | hard         | 1745   | 1760   |   |       |         |
| Shale        | silver     | hard         | 1760   | 1780   |   |       |         |
| Sand         | clear      | hard         | 1780   | 1800   |   |       |         |
| Lime & shale | grey       | medium       | 1800   | 1835   |   |       |         |
| Sand         | yellow     | hard         | 1835   | 1895   |   |       |         |
| Sand, shaley | grey       | medium       | 1895   | 1970   |   |       |         |
| Shale        | drk. grey  | soft         | 1970   | 2035   | None  |       |         |
| Shale        | green      | soft         | 2035   | 2085   |   |       |         |
| Lime         | brown      | medium       | - 2085 | 2105   |   |       |         |
| Sand         | clear      | hard         | 2105   | 2140   |   |       |         |
| Lime         | white      | hard         | - 2140 | 2190   |   |       |         |
| Sand & lime  | lt. grey   | hard         | 2190   | 2250   |   |       |         |
| Lime         | white      | hard         | 2250   | 2285   |   |       |         |
| Shale        | green-grey | soft         | 2285   | 2333   |   |       |         |
| T.D.         |            |              |        | 2333   |   |       |         |

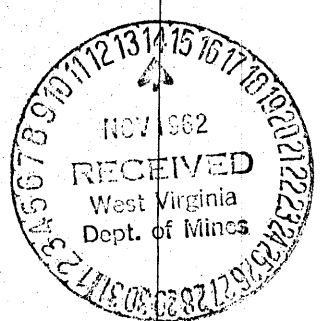

Little Line  
Blue Monday  
Big Lime  
Keener  
Injun