


Latitude 39° 20'

Longitude 80° 50'

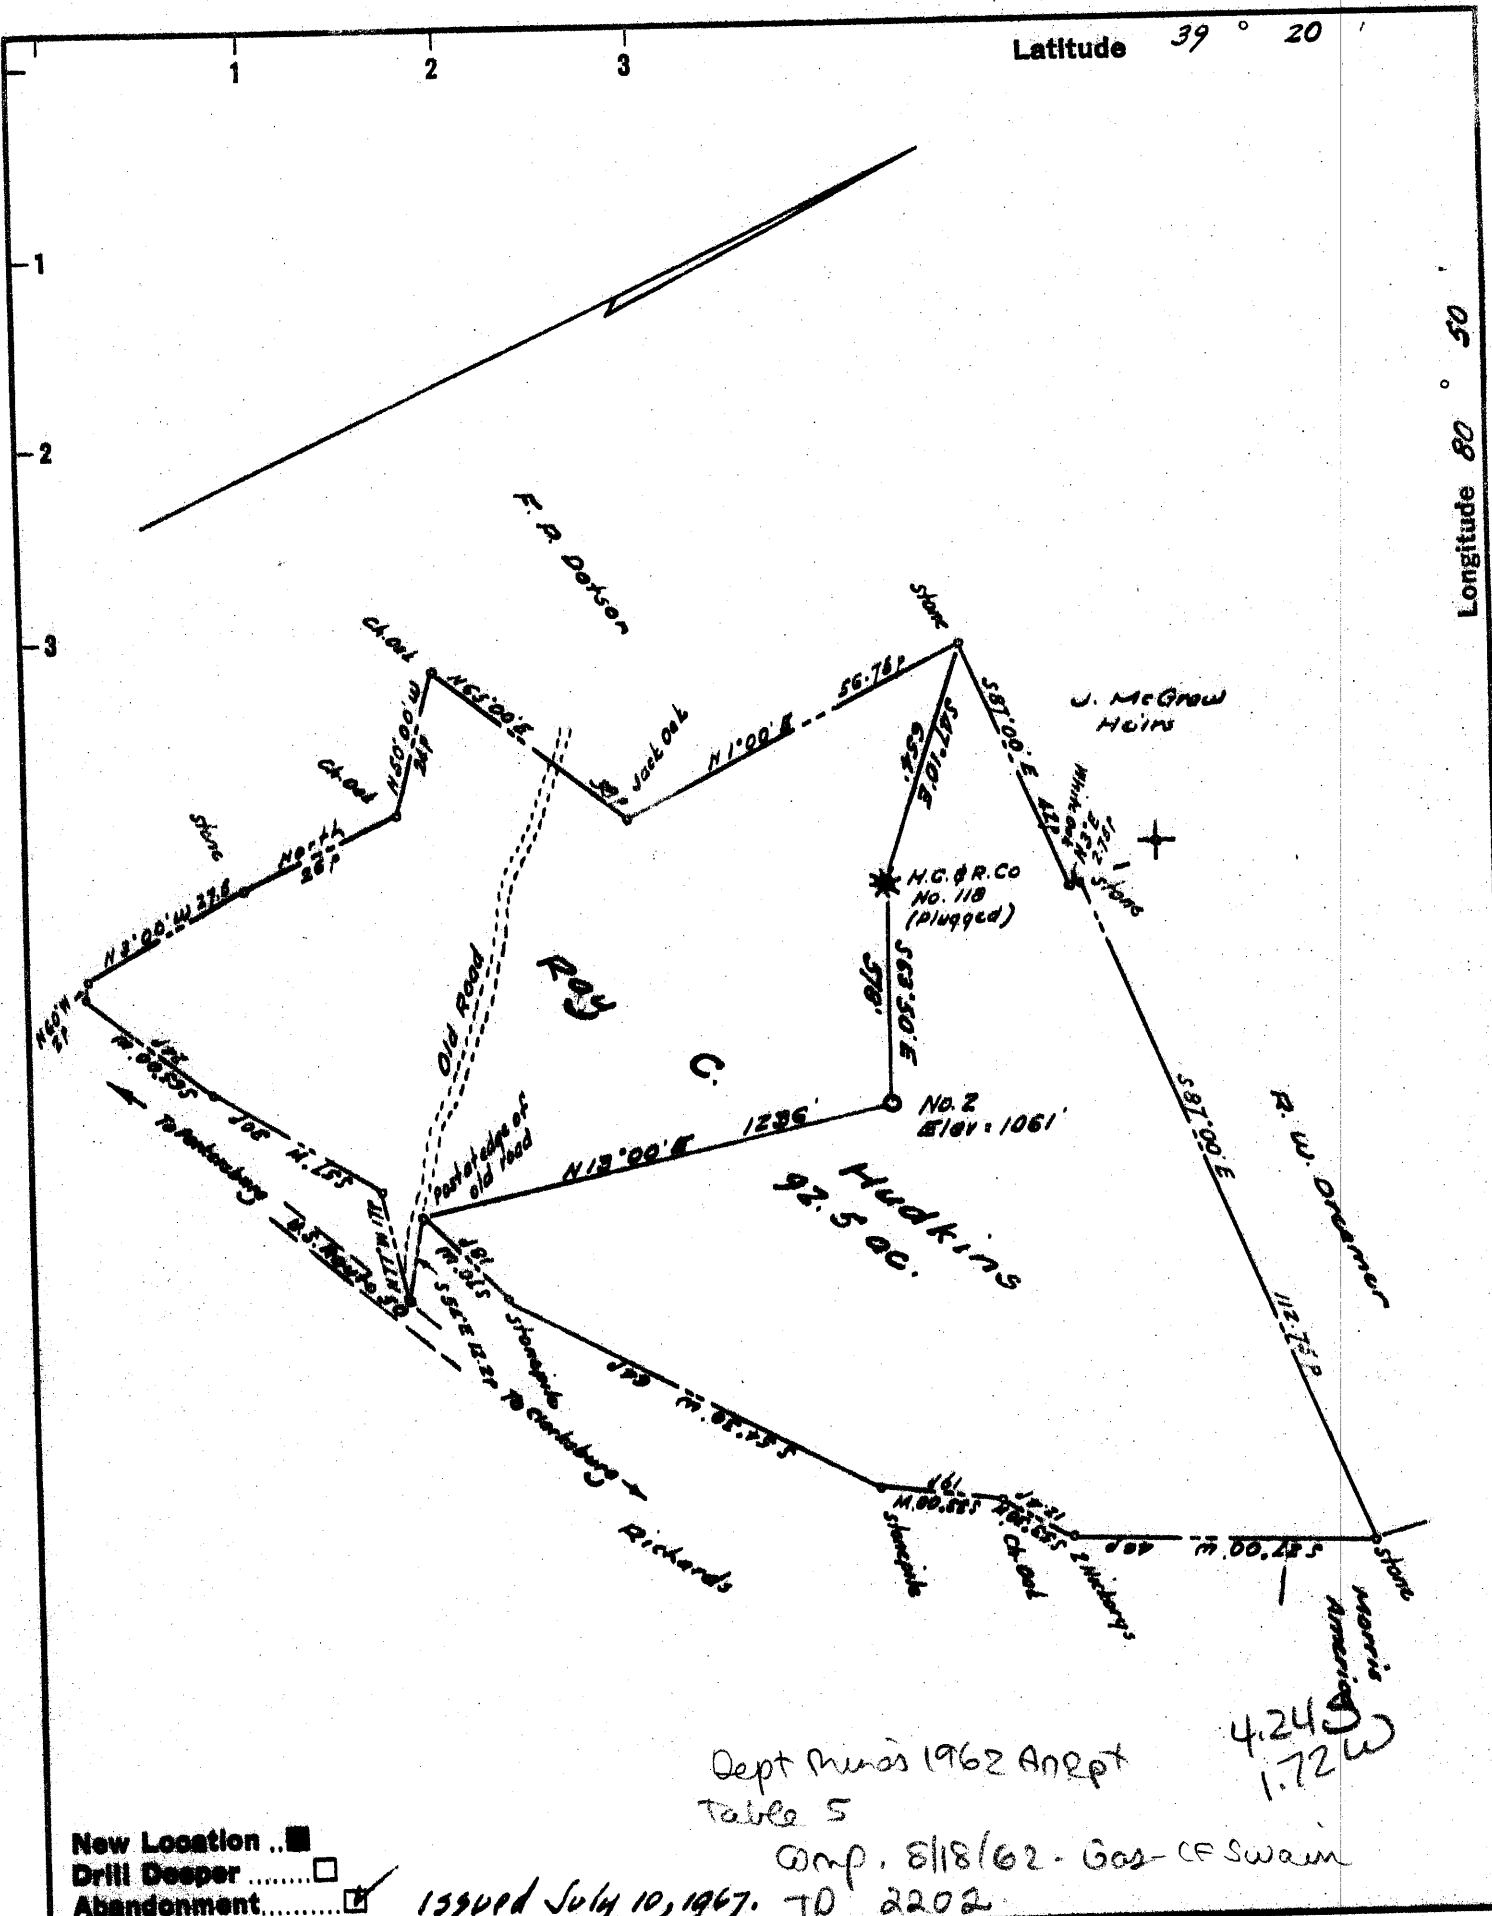

Dept Mines 1962 Anrpt
Table 5

4.24 S
1.72 W

Comp. 8/18/62 - Gas - CF Swain

New Location
Drill Deeper
Abandonment

Issued July 10, 1967. TD 2202

Company PETROLEUM PROMOTIONS 3023
 Address Alton, Illinois
 Farm Ray C. Hudkins
 Tract _____ Acres 92.5 Lease No. _____
 Well (Farm) No. Two Serial No. _____
 Elevation (Spirit Level) 1061'
 Quadrangle West Union SC
 County Doddridge District Central
 Engineer W. H. H. Jones
 Engineer's Registration No. 1227
 File No. _____ Drawing No. _____
 Date June 1962 Scale 1" = 300' = 495'

STATE OF WEST VIRGINIA
 DEPARTMENT OF MINES
 OIL AND GAS DIVISION
 CHARLESTON

WELL LOCATION MAP
 FILE NO. 000-821-P

+ Denotes location of well on United States Topographic Maps, scale 1 to 62,500, latitude and longitude lines being represented by border lines as shown.

- Denotes one inch spaces on border line of original tracing.