

4725
1171

New Location ..
 Drill Deeper
 Abandonment Issued July 10, 1967.

PETROLEUM PROMOTIONS

Company Petroleum Promotions
 Address Alton, Illinois
 Farm Leonard Dotson
 Tract _____ Acres 100 Lease No. _____
 Well (Farm) No. 000 Serial No. _____
 Elevation (Spirit Level) 862 ^{950' - 1015' 75' top}
 Quadrangle West U-200 S-C 75'
 County Doddridge District Central
 Engineer W. H. H. Sp.
 Engineer's Registration No. 1227
 File No. _____ Drawing No. _____
 Date August 1, 1962 Scale 1" = 400' 660'

STATE OF WEST VIRGINIA
 DEPARTMENT OF MINES
 OIL AND GAS DIVISION
 CHARLESTON

WELL LOCATION MAP
 FILE NO. 000-851-P

+ Denotes location of well on United States Topographic Maps, scale 1 to 62,500, latitude and longitude lines being represented by border lines as shown.

- Denotes one inch spaces on border line of original tracing.



STATE OF WEST VIRGINIA
DEPARTMENT OF MINES
OIL AND GAS DIVISION 10

Quadrangle West Union

Permit No. DOD-851

WELL RECORD

Oil or Gas Well oil

Company C.F. Swain
Address P.O. Box 57, Alton Illinois
Farm L.O. Dotson Acres 100
Location (waters) Dotson Creek
Well No. One Elev. 950'
District Central County Doddridge
The surface of tract is owned in fee by L.O. Dotson
Address Clarksburg W.Va.
Mineral rights are owned by L.O. Dotson
Address Clarksburg W.Va.
Drilling commenced 7/29/62
Drilling completed 8/16/62
Date Shot none From _____ To _____
With _____
Open Flow /10ths Water in no gas Inch _____
/10ths Merc. in _____ Inch _____
Volume _____ Cu. Ft. _____
Rock Pressure _____ lbs. _____ hrs. _____
Oil 6 bbls. bbls., 1st 24 hrs. _____
WELL ACIDIZED run ahead of frac
WELL FRACTURED Yes--Western Service Co.

Casing and Tubing	Used in Drilling	Left in Well	Packers
Size			Kind of Packer
16			<u>none</u>
13			Size of
10	<u>378'</u>	<u>378'</u>	Depth set
8 1/4	<u>1170'</u>	<u>none</u>	Perf. top
6 5/8	<u>1537'</u>	<u>none</u>	Perf. bottom
5 3/16	<u>1920'</u>	<u>1920'</u>	Perf. top
3			Perf. bottom
2			
Liners Used			

CASING CEMENTED 5 1/2 SIZE 1920' No. Ft. _____ Date _____
(5 1/2 set and cemented in the Big Line)
Lawson Cementing Co.
COAL WAS ENCOUNTERED AT None FEET _____ INCHES _____
FEET _____ INCHES _____ FEET _____ INCHES _____
FEET _____ INCHES _____ FEET _____ INCHES _____

RESULT AFTER TREATMENT No gas-- approx 6 bbl oil


ROCK PRESSURE AFTER TREATMENT not enough to gauge

Fresh Water 10' and 140' Feet _____ Salt Water 1470' to 1492' Feet Maxim 1835'

Formation	Color	Hard or Soft	Top	Bottom	Oil, Gas or Water	Depth	Remarks
topsoil & sand	gravel white	soft	0 Ft/	10 Ft.	water	10 Ft.	
slate	blk	soft	10	30		30	
redrock		soft	30	60		60	
slate			60	80		80	
redrock			80	130		130	
sand	grey		130	140	water	140	
slate			140	170		170	
slate			170	210		210	
sand			210	220		220	
slate			220	230		230	
redrock	red		230	245		245	
sand			245	260		260	
slate			260	271		271	
redrock	red		271	290		290	
rock&slate	pink		290	310		310	
sand			310	330		330	
slate			330	363		363	
sand			363	368		368	
redrock			368	378		378	
slate			378	390		390	
rock	pink		390	405		405	
slate			405	435		435	
lime			435	463		463	
redrock	red		463	525		525	
slate			525	566		566	
sand			566	585		585	
slate			585	610		610	
rock&slate	pink		610	620		620	

(over)

(over)

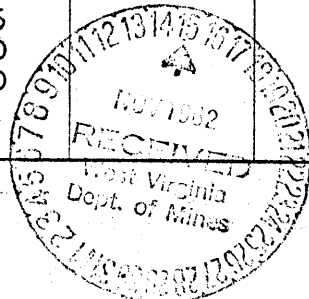

Formation	Color	Hard or Soft	Top /0	Bottom	Oil, Gas or Water	Depth Found	Remarks	
slate&shell		hard	620	645		645		
pitt lime			645	670		670		
shell&slate			670	790		790		
redrock	red		790	893		893		
slate			893	970		970		
sand			970	999		999		
sate slate			999	1007		1007		
rock	pink		1007	1012		1012		
slate			1012	1035		1035		
sand			1035	1050		1050		
slate& shells			1050	1112		1112		
sand			1112	1132		1132		
slate			1132	1165		1165		
sand			1165	1189		1189		
slate			1189	1210		1210		
sand			1210	1225		1225		
slate& shells			1225	1270		1270		
sand			1270	1285		1285		
slate			1285	1305		1305		
lime			1305	1323		1323		
sand			1323	1369		1369		
slate			1369	1450		1450		
lime			1450	1460		1460		
slate			1460	1470		1470		
Sand	white		1470	1492	water	1492	hole full	
shale			1492	1515		1515	water	
lime			1515	1525		1525		
sand			1525	1545		1545		
slate			1545	1576		1576		
sand			1576	1690		1690		
slate			1690	1795		1795		
sand	white		1795	1858	water	1858	hole full	
slate			1858	1872		1872	water at 1835	
lime			1872	1889		1889	1835'	
break			1889	1892	Break	1892		
Sand BM			1892	1897		1897		
Pencil cave			1897	1900		1900	pencil cave	
Big lime			1900	1985		1985	Big Lime	
SAND			1985	2057		2057		
			T O T A L - D E P T H 2057'					

Date OCTOBER 12th, 1962

APPROVED C.F. Swain, Owner

By Owner-Operator (Title)