

- Redrill.....
- New Location.
- Drill Deeper.....
- Abandonment.....

Company GEORGE JACKSON

Address CLARKSBURG, W.VA.

Farm BONITA FLING

Tract \_\_\_\_\_ Acres 29 Lease No. \_\_\_\_\_

Well (Farm) No. \_\_\_\_\_ Serial No. 1

Elevation (Spirit Level) 966' V.A.

Quadrangle VADIS NW 1/2

County DODDRIDGE District NEW MILTON

Engineer Jamund Jeffries

Engineer's Registration No. 1084

File No. 205/100 Drawing No. \_\_\_\_\_

Date 9-21-62 Scale 1" = 300'

STATE OF WEST VIRGINIA  
DEPARTMENT OF MINES  
OIL AND GAS DIVISION  
CHARLESTON

**WELL LOCATION MAP**  
FILE NO. DOD-876

+ Denotes location of well on United States Topographic Maps, scale 1 to 62,500, latitude and longitude lines being represented by border lines as shown.

— Denotes one inch spaces on border line of original tracing.

RDM-

6-6 140



STATE OF WEST VIRGINIA  
DEPARTMENT OF MINES  
OIL AND GAS DIVISION 7

Quadrangle Vadis

Permit No. DOD-876

**WELL RECORD**

Oil or Gas Well Oil  
(KIND)

Company GEORGE JACKSON  
Address P. O. DRAWER 351, CLARKSBURG, W. VA.  
Farm BONNETA FLING Acres 29  
Location (waters) Toms Fork  
Well No. One Elev. 966 VA  
District New Milton County Doddridge  
The surface of tract is owned in fee by Bonnetta Fling  
New Milton Address W. Va.  
Mineral rights are owned by Bonnetta Fling, et al  
Same Address \_\_\_\_\_  
Drilling commenced September 28, 1962  
Drilling completed November 10, 1962  
Date Shot \_\_\_\_\_ From \_\_\_\_\_ To \_\_\_\_\_  
With \_\_\_\_\_  
Open Flow \_\_\_\_\_ /10ths Water in \_\_\_\_\_ Inch  
\_\_\_\_\_ /10ths Merc. in \_\_\_\_\_ Inch  
Volume \_\_\_\_\_ Cu. Ft.  
Rock Pressure \_\_\_\_\_ lbs. \_\_\_\_\_ hrs.  
Oil 5 Barrels (Natural) bbls., 1st 24 hrs.  
~~San Fract with 700 bbls Water~~ feet  
~~expand 20 bbls after treatment~~ feet


Casing and Tubing	Used in Drilling	Left in Well	Packers
Size			Kind of Packer
16			
13			
10	60'	60'	Size of
8 1/4	296'	None	
6 3/8	1293'	1293'	Depth set
5 3/16	1952'	1952'	
3			Perf. top <u>1960'</u>
2	1993'	1993'	Perf. bottom <u>1970'</u>
Liners Used			Perf. top _____
			Perf. bottom _____

CASING CEMENTED 7" SIZE 100' No. Ft. 11/4/62 Date

COAL WAS ENCOUNTERED AT \_\_\_\_\_ FEET \_\_\_\_\_ INCHES  
\_\_\_\_\_ FEET \_\_\_\_\_ INCHES \_\_\_\_\_ FEET \_\_\_\_\_ INCHES  
\_\_\_\_\_ FEET \_\_\_\_\_ INCHES \_\_\_\_\_ FEET \_\_\_\_\_ INCHES

Formation	Color	Hard or Soft	Top	Bottom	Oil, Gas or Water	Depth Found	Remarks
Top Soil			0	5			
Slate			5	20			
Red Rock			20	50			
Slate			50	60			
Red Rock			60	75			
Blue Rock			75	115			
Red Rock			115	130			
Lime			130	145			
Slate			145	163			
Red Rock			163	175			
Lime			175	205			
Red Rock			205	213			
Slate			213	230			
Red Rock			230	250			
Slate & Shells			250	410			
Sand			410	420			
Slate			420	430			
Red Rock			430	465			
Slate & Shells			465	545			
Lime			545	560			
Slate			560	585			
Slate & Shells			585	665			
Red Rock			665	705			
Sand			705	720			
Slate			720	740			
Lime			740	758			
Red Rock			758	773			
Lime			773	785			
Red Rock			785	795			
Lime			795	820			
Red Rock			820	825			
Lime			825	840			
Sand			840	850			
Lime			850	865			
Slate & Shells			865	902			

(Over)

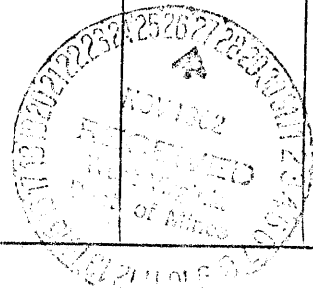

Formation	Color	Hard or Soft	Top	Bottom	Oil, Gas or Water	Depth Found	Remarks
Lime			902	920			
Red Rock			920	930			
Gritty Lime			930	950			
Slate & Shells			950	1017			
Sand			1017	1030			
Slate & Shells			1030	1075			
Sand			1075	1103			
Gritty Lime			1103	1152			
Lime			1152	1165			
Sand			1165	1220			
Slate & Shells			1220	1288			
Lime			1288	1321			
Slate			1321	1331			
Lime			1331	1350			
Slate			1350	1365			
Lime			1365	1380			
First Salt Sand			1380	1430			
Slate			1430	1432			
Lime			1432	1435			
Second Salt Sand			1435	1465			
Slate			1465	1480			
Lime			1480	1490			
Sand			1490	1508			
Lime			1508	1538			
Sand			1538	1548			
Slate & Shells			1548	1600			
Lime			1600	1610			
Sand			1610	1630			
Lime			1630	1640			
Slate & Shells			1640	1675			
Sand			1675	1695			
Slate & Shells			1695	1710			
Lime			1710	1720			
Slate & Shells			1720	1840			
L. Lime			1840	1862			
Slate			1862	1866			
Lime			1866	1880			
Blue Monday Sand			1880	1915			
Big Lime			1915	1960			
Big Injun			1960	2005			
Dark Lime			2005	2015			
Injun Sand			2015	2052			
Slate			2052	2061			
Total Depth			2061				

Gas & Oil 1965 to 1967  
 Filled back to 2040 with  
 Calseal Plug

Date November 26, 1962

APPROVED GEORGE JACKSON, Owner

By *George Jackson*  
 (Title)