

New Location
 Drill Deeper
 Abandonment

Company HILTON BEVER
 Address 119 E. 5th St., Williamstown, W. Va.
 Farm Gracie Cooper
 Tract _____ Acres 110 Lease No. _____
 Well (Farm) No. One Serial No. _____
 Elevation (Spirit Level) 1057
 Quadrangle West Union SC
 County Doddridge District Central
 Engineer M. H. H. J.
 Engineer's Registration No. 1227
 File No. _____ Drawing No. _____
 Date April 21, 1963 Scale 1" = 30p = 495'

STATE OF WEST VIRGINIA
 DEPARTMENT OF MINES
 OIL AND GAS DIVISION
 CHARLESTON

WELL LOCATION MAP
 FILE NO. Dod-965

+ Denotes location of well on United States Topographic Maps, scale 1 to 62,500, latitude and longitude lines being represented by border lines as shown.

- Denotes one inch spaces on border line of original tracing.



STATE OF WEST VIRGINIA
DEPARTMENT OF MINES
 OIL AND GAS DIVISION

Quadrangle West Union

Permit No. DOD-965

WELL RECORD

Oil or Gas Well Dry

Company Hilton Bever
 Address 119 - E - 5th St., Williamstown, W.Va
 Farm Gracie Cooper Acres 110
 Location (waters) _____
 Well No. One Elev. 1057'
 District Central County Doddrige
 The surface of tract is owned in fee by Same
 Address _____
 Mineral rights are owned by Gracie Cooper
 Address Pennsboro, W.Va
 Drilling commenced April 30th, 1963
 Drilling completed June 5th, 1963
 Date Shot _____ From _____ To _____
 With _____
 Open Flow _____ /10ths Water in _____ Inch
 _____ /10ths Merc. in _____ Inch
 Volume _____ Cu. Ft.
 Rock Pressure _____ lbs. _____ hrs.
 Oil _____ bbls., 1st 24 hrs.
 WELL ACIDIZED _____
 WELL FRACTURED _____

Casing and Tubing	Used in Drilling	Left in Well	Packers
Size			Kind of Packer
16			
12			
10	19'		Size of
8 1/4	535'		
6 3/4	1027'		Depth set
5 3/16			
3			Perf. top
2			Perf. bottom
Liners Used			Perf. top
			Perf. bottom

CASING CEMENTED _____ SIZE _____ No. Ft. _____ Date _____


COAL WAS ENCOUNTERED AT _____ FEET _____ INCHES
 _____ FEET _____ INCHES FEET _____ INCHES
 _____ FEET _____ INCHES FEET _____ INCHES

RESULT AFTER TREATMENT

ROCK PRESSURE AFTER TREATMENT

Fresh Water _____ Feet Salt Water _____ Feet

Formation	Color	Hard or Soft	Top	Bottom	Oil, Gas or Water	Depth	Remarks
Surface			0	25'			
Sand			25	45			
Red rock			45	95			
Sand			95	115			
Slate			115	150			
Red rock			150	175			
Slate			175	225			
Sand			225	250			
Red rock			250	350			
Sand			350	370			
W. Slate			370	390			
Red rock			390	400			
Lime			400	410			
Red rock			410	480			
Lime			480	500			
Sand			500	575			
Shale			575	585			
Sand			585	625			
Bl Slate			625	645			
Wh Slate			645	670			
Bl Slate			670	690			
Lime			690	705			
Shale			705	740			
Red rock			745	800			
Sand			800	820			
Red rock			820	950			
Lime			950	975			
Red rock			975	1040			
Gra Shale			1040	1125			
Sand			1125	1150			

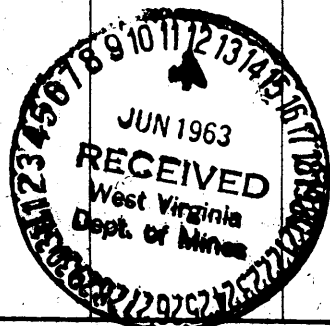

Formation	Color	Hard or Soft	Top 4	Bottom 100 FT	Oil, Gas or Water	Depth Found	Remarks
Shale			1150	1275			
Slate			1275	1442			
Lime			1442	1467			
Sand			1467	1580	Water, 1485'	1 bailer per hr.	
Shale			1580	1590			
Sand			1590	1740			
Bl Slate			1740	1795			
Shale			1795	1820			
Sand			1820	1870			
Shale			1870	1890			
Lime			1890	1895			
Glate			1895	1920			
Lime			1920	2025			
Sand			2025	2044			
Bl Shale			2044	2051			
Sand			2051	2060			
Bl Shale			2060	2065			
Sand			2065	2069			
Bl Shale			2069	2075	I.D.		

Date 6/12, 1963
 APPROVED Hilton Beer, Owner
 By _____ (Title)