


2/5/69

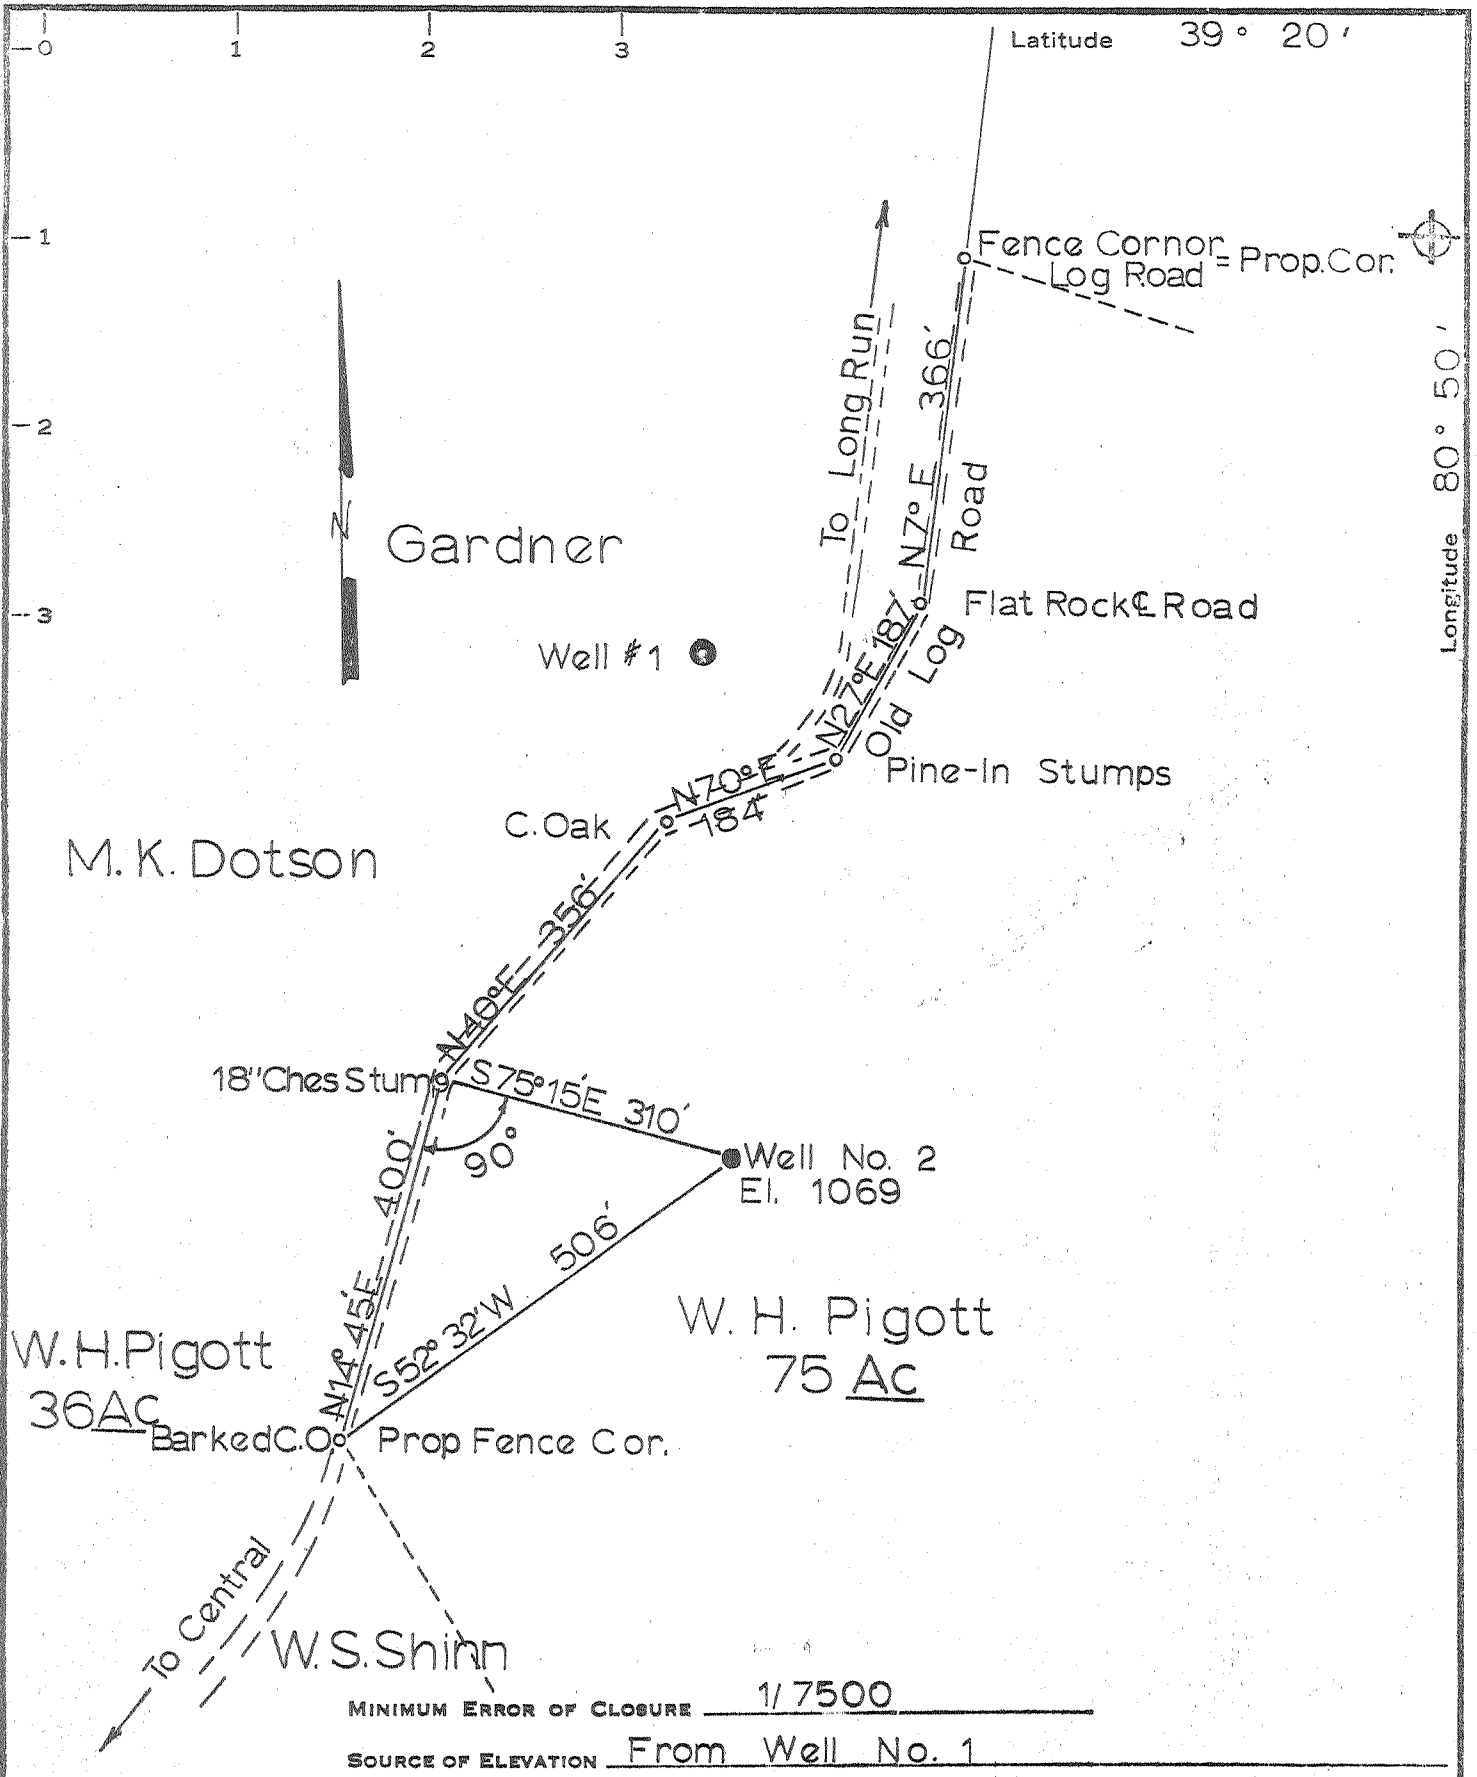

- New Location
- Drill Deeper
- Abandonment

issued 8-5-69

I, THE UNDERSIGNED, HEREBY CERTIFY THAT THIS MAP IS CORRECT TO THE BEST OF MY KNOWLEDGE AND BELIEF AND SHOWS ALL THE INFORMATION REQUIRED BY PARAGRAPH 6 OF THE RULES AND REGULATIONS OF THE OIL AND GAS SECTION OF THE MINING LAWS OF WEST VIRGINIA.

Company F. L. Prior, A. A. Pursley, dba Pursley's Pulling & Well Service
Box 31, Gray, W. Va. 25252
Union Trust Bldg., Parkersburg, W. Va.

Address _____

Farm W. H. Pigott Hrs.

Tract _____ Acres 75 Lease No. _____

Well (Farm) No. 2 Serial No. _____

Elevation (Spirit Level) 1069

Quadrangle West Union SC

County Doddridge District Central

Engineer Gordon C. Ralls

Engineer's Registration No. 4052

File No. _____ Drawing No. _____

Date 11/20/63 Scale 1" = 200'


STATE OF WEST VIRGINIA
 DEPARTMENT OF MINES
 OIL AND GAS DIVISION
 CHARLESTON

WELL LOCATION MAP

FILE NO. DOD-1072-P

+ Denotes location of well on United States Topographic Maps, scale 1 to 62,500, latitude and longitude lines being represented by border lines as shown.

- Denotes one inch spaces on border line of original tracing.

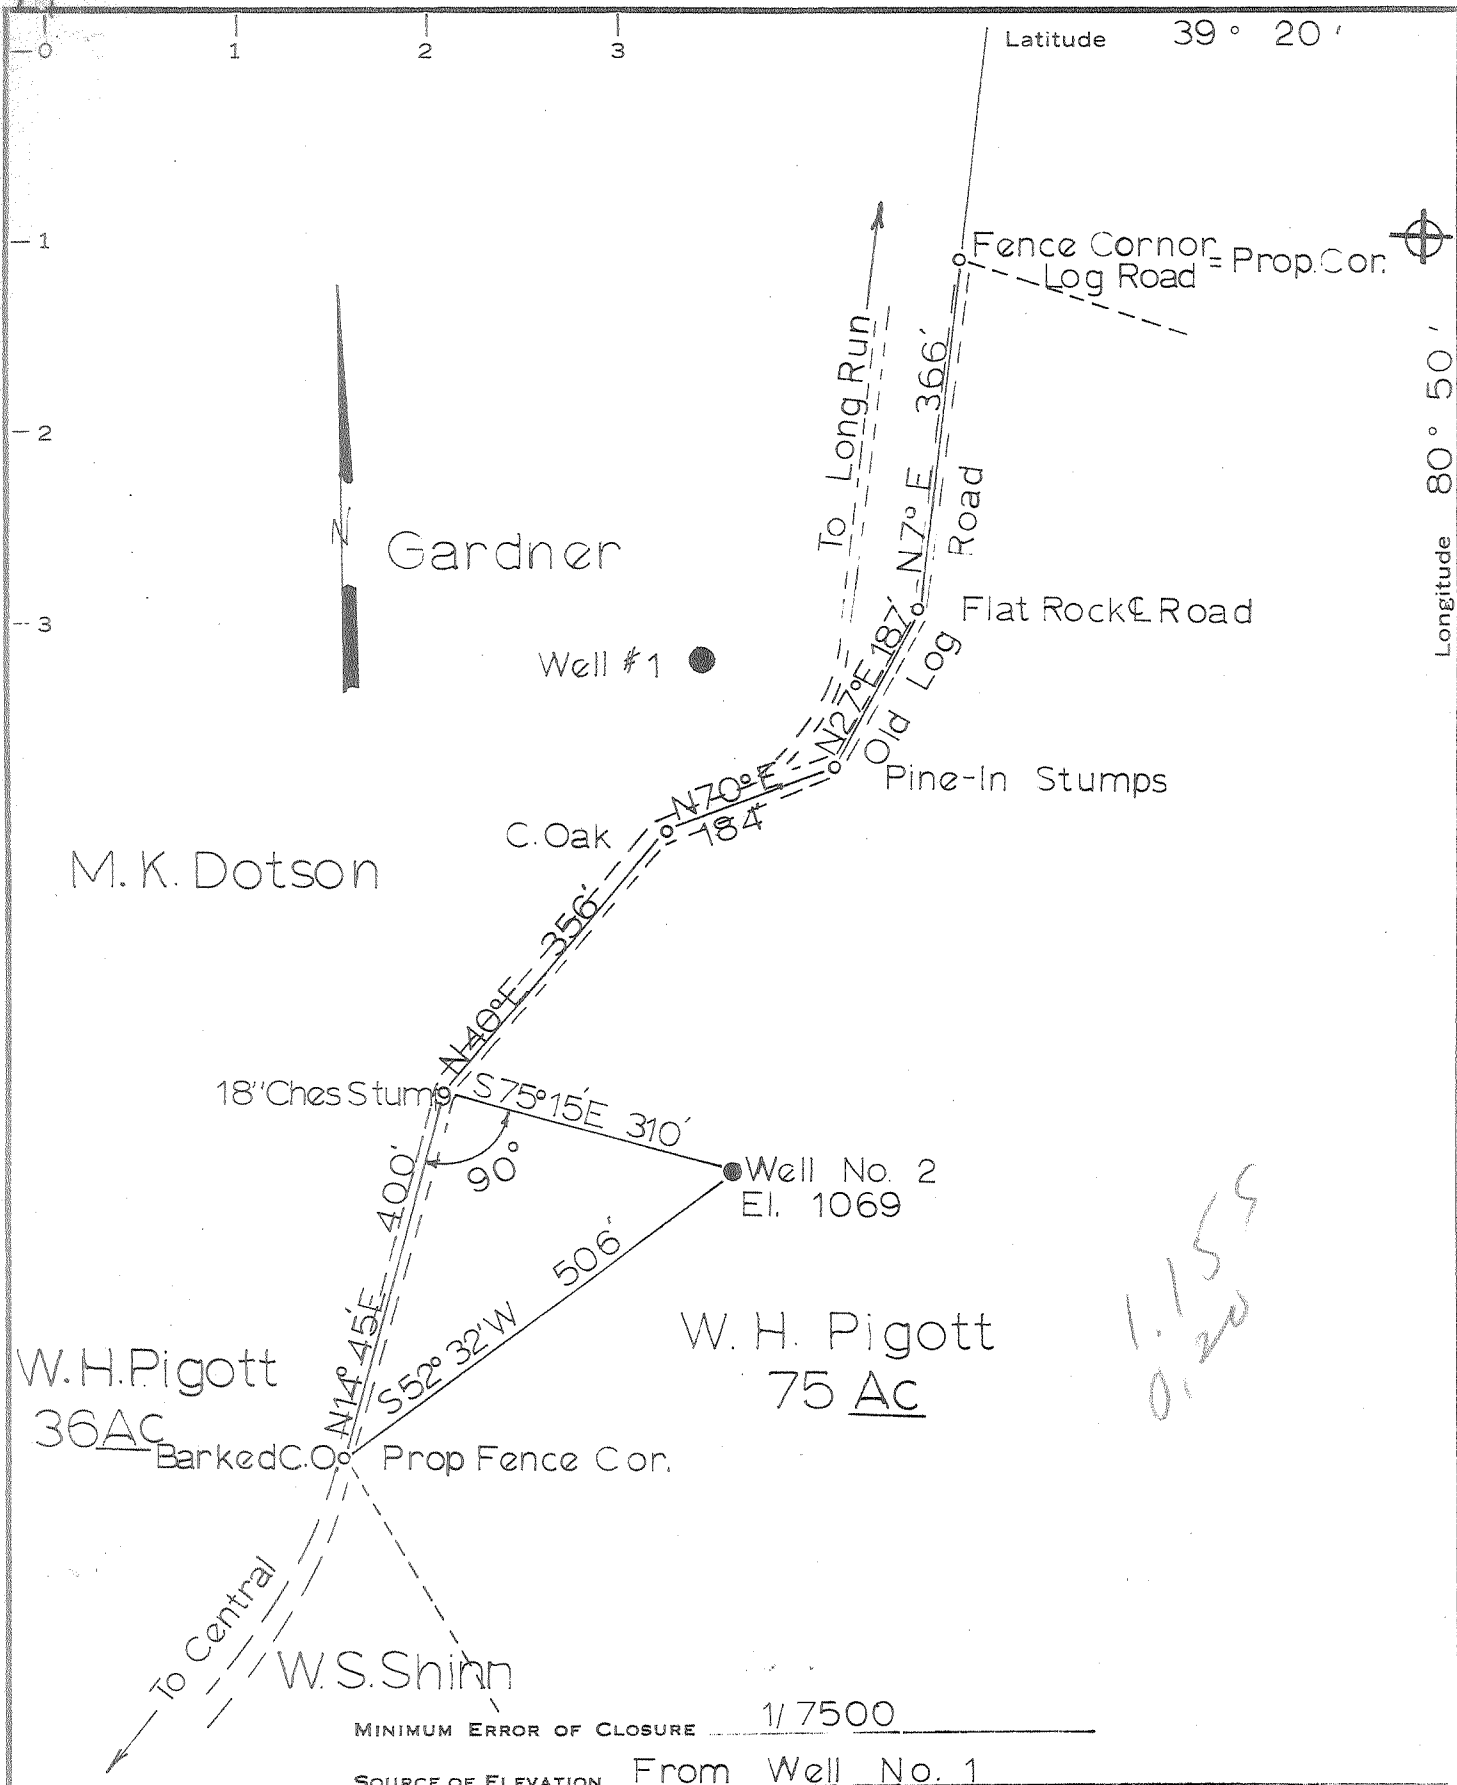

MINIMUM ERROR OF CLOSURE 1/7500
 SOURCE OF ELEVATION From Well No. 1

New Location
 Drill Deeper
 Abandonment

"I, THE UNDERSIGNED, HEREBY CERTIFY THAT THIS MAP IS CORRECT TO THE BEST OF MY KNOWLEDGE AND BELIEF AND SHOWS ALL THE INFORMATION REQUIRED BY PARAGRAPH 6 OF THE RULES AND REGULATIONS OF THE OIL AND GAS SECTION OF THE MINING LAWS OF WEST VIRGINIA."

Company F. L. Prior
 Address Union Trust Bldg., Parkersburg, W. Va.
 Farm W. H. Pigott Hrs.
 Tract _____ Acres 75 Lease No. _____
 Well (Farm) No. 2 Serial No. _____
 Elevation (Spirit Level) 1069
 Quadrangle West Union - SC
 County Doddridge District Central
 Engineer Gordon C. Ralls
 Engineer's Registration No. 4052
 File No. _____ Drawing No. _____
 Date 11/20/63 Scale 1" = 200'

STATE OF WEST VIRGINIA
 DEPARTMENT OF MINES
 OIL AND GAS DIVISION
 CHARLESTON

WELL LOCATION MAP
 FILE NO. DOD-1072

+ Denotes location of well on United States Topographic Maps, scale 1 to 62,500, latitude and longitude lines being represented by border lines as shown.

— Denotes one inch spaces on border line of original tracing.



STATE OF WEST VIRGINIA
DEPARTMENT OF MINES
OIL AND GAS DIVISION

- Rotary
- Spudder
- Cable Tools
- Storage

Quadrangle WEST UNION

WELL RECORD

Permit No. D00-1072

Oil or Gas Well GAS
(KIND)

Company PRIOR OIL COMPANY
 Address 720 UNION TRUST BLDG., PARKERSBURG, W. VA.
 Farm W. H. PIGOTT HEIRS Acres 75
 Location (waters) long run
 Well No. 2 Elev. 1069
 District CENTRAL County DODDRIDGE
 The surface of tract is owned in fee by D. D. CHIPPS
 Address KALAMAZOO, MICHIGAN
 Mineral rights are owned by D. D. CHIPPS, ET AL
 Address KALAMAZOO, MICH.
 Drilling commenced 12/4/64
 Drilling completed 4/1/64
 Date Shot _____ From _____ To _____
 With _____
 Open Flow _____ /10ths Water in _____ Inch
 _____ /10ths Merc. in _____ Inch
 Volume _____ Cu. Ft.
 Rock Pressure _____ lbs. _____ hrs.
 Oil _____ bbls., 1st 24 hrs.
 WELL ACIDIZED 250 GAL
 WELL FRACTURED 20,000#

Casing and Tubing	Used in Drilling	Left in Well	Packers
Size			Kind of Packer
16			
13			
10	25	25	Size of
8 1/4	850		
6 3/4	1870		Depth set
5 1/2	2035	2035	
3			Perf. top <u>1953</u>
2			Perf. bottom
Liners Used			Perf. top <u>1975</u>
			Perf. bottom

CASING CEMENTED 4 1/2 SIZE 2035 No. Ft. 12/26/63 Date
75 cement- 6 aquagel- Halliburton
 COAL WAS ENCOUNTERED AT _____ FEET _____ INCHES
NO COAL
 _____ FEET _____ INCHES _____ FEET _____ INCHES
 _____ FEET _____ INCHES _____ FEET _____ INCHES

RESULT AFTER TREATMENT 50 MCF
 ROCK PRESSURE AFTER TREATMENT 400#
 Fresh Water NONE RECORDED Feet _____ Salt Water NONE RECORDED Feet _____

Formation	Color	Hard or Soft	Top	Bottom	Oil, Gas or Water	Depth	Remarks
Surface			0	94			
Sand			94	163			
Sand & shells			163	247			
Sandy shale			247	376			
Shale			376	448			
Slate & shells			448	594			
Sand			594	742			
Slate-shells			742	894			
Britty lime			894	1011			
Shale			1011	1142			
Sandy slate			1142	1294			
Sand			1294	1426			
Shale			1426	1591			
Sandy shale			1591	1698			
Sand			1698	1706			
Shale			1706	1735			
Sand			1735	1761			
Shale			1761	1857			
Lime			1857	2014			
Shale			2014	2047			

1857
1069
789

