

New Location.....
 Drill Deeper.....
 Abandonment.....

Error in Closure: - Less than 1' in 200'

Company Ferrell L. Prier
 Address 720 Union Trust Bldg. Parkersburg W.Va.
 Farm Elizabeth Thomas
 Tract _____ Acres 43 Lease No. _____
 Well (Farm) No. One Serial No. _____
 Elevation (Spirit Level) 771'
 Quadrangle West Union - SC
 County Doddridge District Central
 Engineer W. S. Stacey
 Engineer's Registration No. 1227
 File No. _____ Drawing No. _____
 Date Dec 10, 1963 Scale 1" = 200' - 330'

STATE OF WEST VIRGINIA
 DEPARTMENT OF MINES
 OIL AND GAS DIVISION
 CHARLESTON

WELL LOCATION MAP
 FILE NO. Dod-1079

plugged 3/13/1964
 + Denotes location of well on United States Topographic Maps, scale 1 to 62,500, latitude and longitude lines being represented by border lines as shown.
 - Denotes one inch spaces on border line of original tracing.



STATE OF WEST VIRGINIA
DEPARTMENT OF MINES
OIL AND GAS DIVISION 5

Rotary
Spudder
Cable Tools
Storage

Quadrangle WEST UNION

Permit No. DOD-1079

WELL RECORD

Oil or Gas Well DRY HOLE
(KIND)

Company PRIOR OIL COMPANY
Address 720 UNION TRUST BLDG. PARKERSBURG, W. VA.
Farm ELIZABETH THOMAS Acres 43
Location (waters) LONG RUN
Well No. 1 Elev. 771
District CENTRAL County DODDRIDGE
The surface of tract is owned in fee by _____
Address _____
Mineral rights are owned by STELLA DOAK, ET AL
Address GREENWOOD, W. VA.
Drilling commenced 1/2/64
Drilling completed 1/15/64
Date Shot _____ From _____ To _____
With _____
Open Flow _____ /10ths Water in _____ Inch
_____ /10ths Merc. in _____ Inch
Volume _____ Cu. Ft.
Rock Pressure _____ lbs. _____ hrs.
Oil _____ bbls., 1st 24 hrs.
WELL ACIDIZED _____
WELL FRACTURED _____

Casing and Tubing	Used in Drilling	Left in Well	Packers
Size			Kind of Packer
16			
13			
10			Size of
8 5/8	72	72	Depth set
6 5/8			
5 3/16			
3			Perf. top
2			Perf. bottom
Liners Used			Perf. top
			Perf. bottom

WELL TO BE PLUGGED
CASING CEMENTED _____ SIZE _____ No. Ft. _____ Date _____


COAL WAS ENCOUNTERED AT _____ FEET _____ INCHES
NONE
_____ FEET _____ INCHES _____ FEET _____ INCHES
_____ FEET _____ INCHES _____ FEET _____ INCHES

RESULT AFTER TREATMENT WELL DRILLED WITH ROTARY-MUD & GEL

ROCK PRESSURE AFTER TREATMENT WELL TO BE PLUGGED

Fresh Water NONE RECORDED Feet _____ Salt Water NONE RECORDED Feet _____

Formation	Color	Hard or Soft	Top	Bottom	Oil, Gas or Water	Depth	Remarks
Surface			0	32			
Sand			32	46			
Shale			46	54			
Sand			54	66			
Shale			66	84			
Sand & shells			84	102			
Sandy shale			102	176			
Sand			176	184			
Sand & shells			184	218			
Black shale			218	248			
Sand & shale			248	314			
Slate & shells			314	378			
Shale			378	442			
Sand & shale			442	491			
Shale			491	564			
Slate & shells			564	632			
Sand			632	714			
Sandy shale			714	793			
Sand			793	814			
Shale			814	882			
Shale & sand			882	943			
Sand			943	962			
Sandy shale			962	1061			
Gray shale			1061	1132			
Sand			1132	1149			
Sandy shale			1149	1264			
Shale			1264	1312			
Sand			1312	1377			
Shale			1377	1466			
Sandy shale			1466	1532			

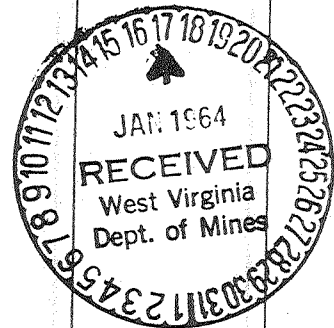

APPROVED _____
 PRIOR OIL COMPANY
 BY Edmund B. Johnson (Title)
 Date January 17, 1964

Formation	Color	Hard or Soft	Top 5'	Bottom	Oil, Gas or Water	Depths Found	Remarks
Sand Shale Big Lime Sandy Lime Shale			1532 1537 1753 1848 1919	1577 1753 1848 1919 2553	1753 771 882		Y