


PV

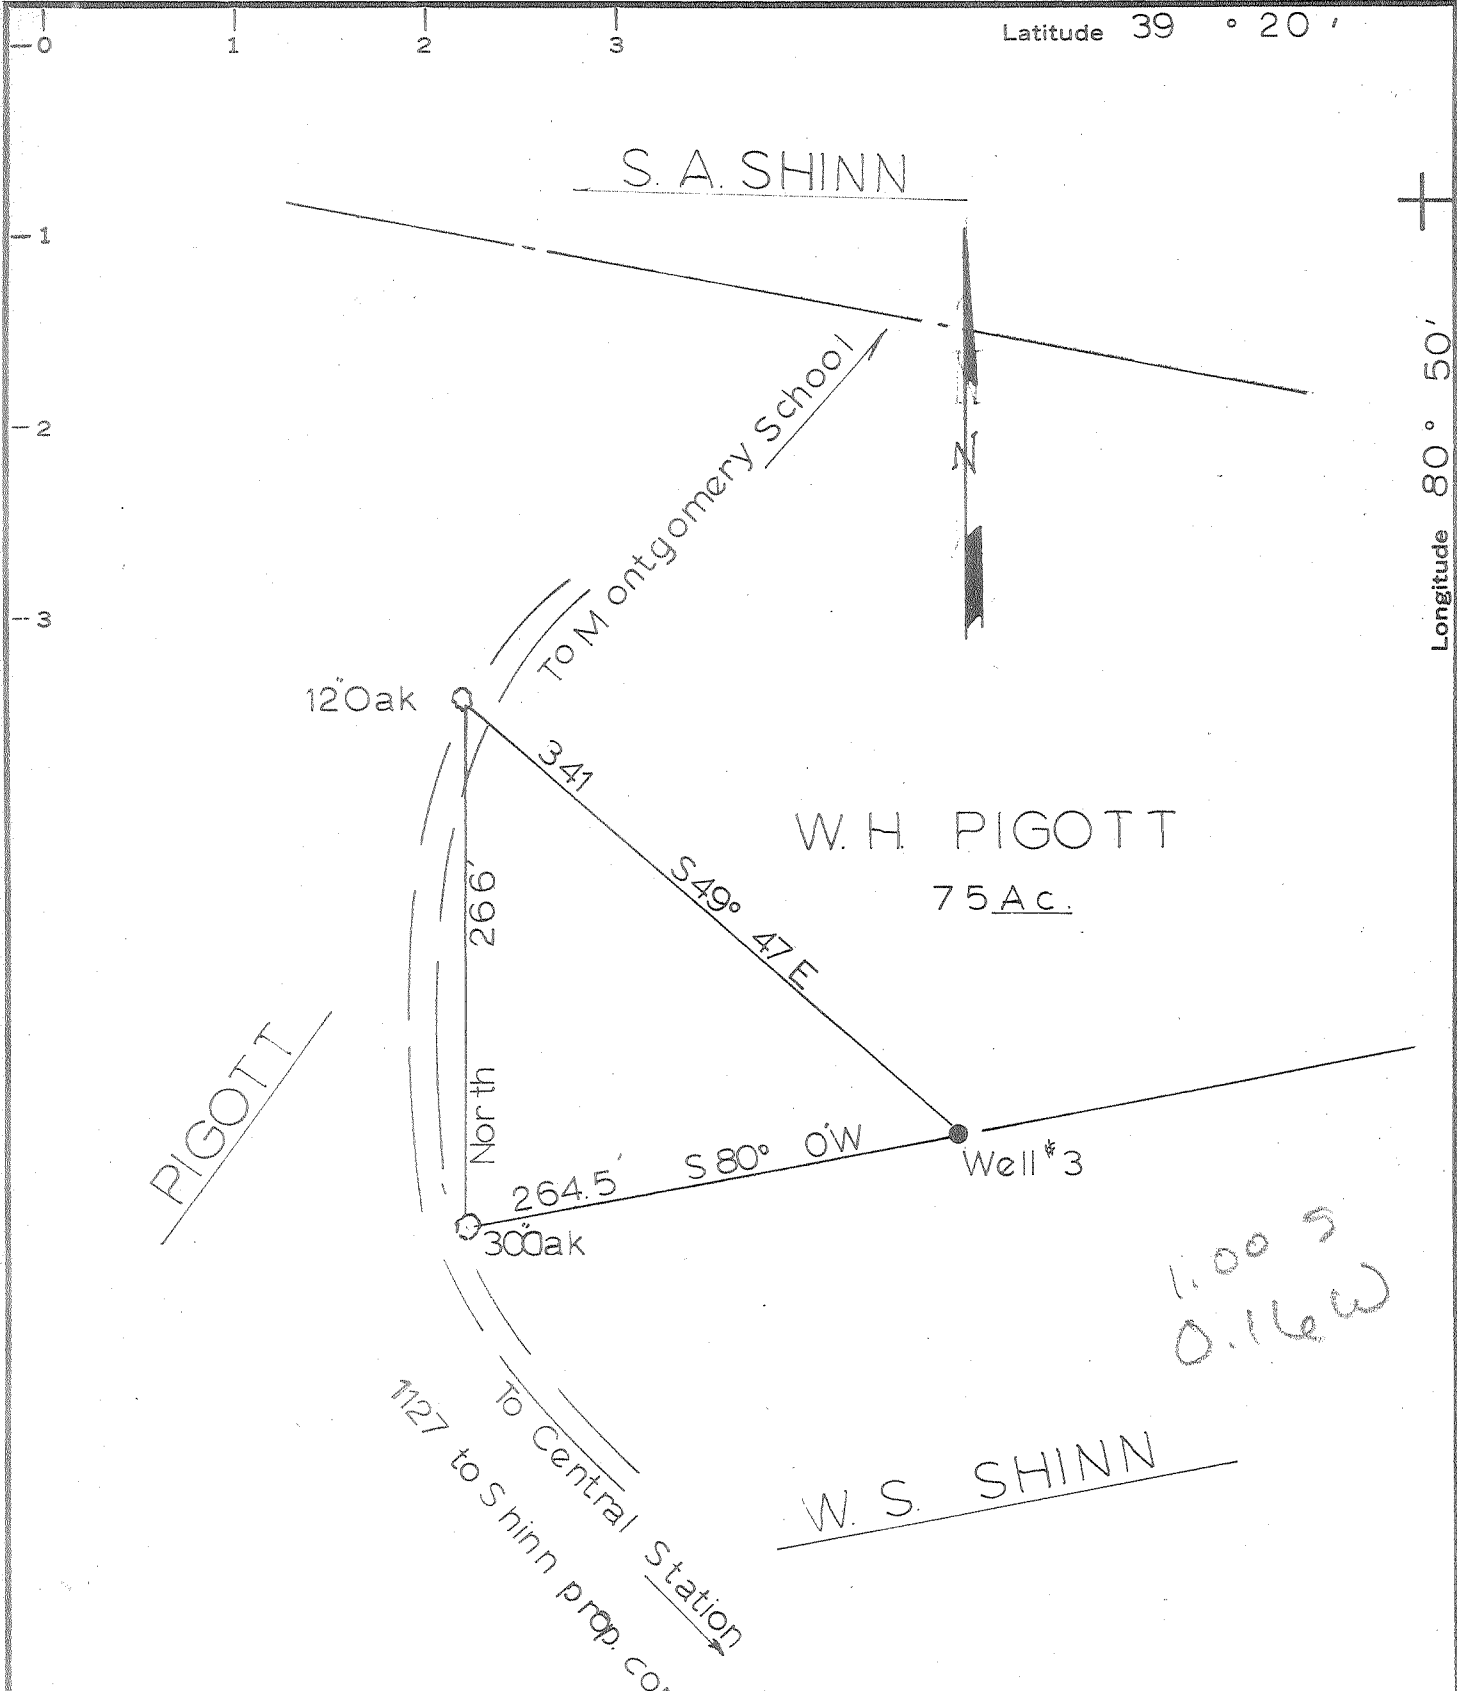

MINIMUM ERROR OF CLOSURE 1/10,000

SOURCE OF ELEVATION Well #1 W. H. Pigott Tract

New Location
 Drill Deeper
 Abandonment

"I, THE UNDERSIGNED, HEREBY CERTIFY THAT THIS MAP IS CORRECT TO THE BEST OF MY KNOWLEDGE AND BELIEF AND SHOWS ALL THE INFORMATION REQUIRED BY PARAGRAPH 6 OF THE RULES AND REGULATIONS OF THE OIL AND GAS SECTION OF THE MINING LAWS OF WEST VIRGINIA."

Company Prior Oil Company
 Address Union Trust Bldg, Parkersburg, W. VA.
 Farm W H Pigott
 Tract 1 Acres 75 Lease No. _____
 Well (Farm) No. 3 Serial No. _____
 Elevation (Spirit Level) 1019
 Quadrangle West Union - SC
 County Doddridge District Central
 Engineer Gordon C. Rallt
 Engineer's Registration No. 4052
 File No. _____ Drawing No. _____
 Date Dec. 14, 1963 Scale 1" = 100'

STATE OF WEST VIRGINIA
 DEPARTMENT OF MINES
 OIL AND GAS DIVISION
 CHARLESTON

WELL LOCATION MAP
 FILE NO. Dod-1093

+ Denotes location of well on United States Topographic Maps, scale 1 to 62,500, latitude and longitude lines being represented by border lines as shown.

- Denotes one inch spaces on border line of original tracing.