

Company Petroleum Promotions
 Address P.O. Box 105, Weston, W. Va
 Farm Western 1/2 A'House 182 ac.
 Tract _____ Acres 91 Lease No. _____
 Well (Farm) No. One A Serial No. _____
 Elevation (Spirit Level) 1187'
 Quadrangle Vadis WC
 County Doddridge District New Milton
 Engineer W. H. H. H.
 Engineer's Registration No. 1227
 File No. _____ Drawing No. _____
 Date Dec 14, 1963 Scale 1" = 400' = 660'

STATE OF WEST VIRGINIA
 DEPARTMENT OF MINES
 OIL AND GAS DIVISION
 CHARLESTON

WELL LOCATION MAP
 FILE NO. Dod - 1097

+ Denotes location of well on United States Topographic Maps, scale 1 to 62,500, latitude and longitude lines being represented by border lines as shown.
 - Denotes one inch spaces on border line of original tracing.



STATE OF WEST VIRGINIA
DEPARTMENT OF MINES
OIL AND GAS DIVISION 5

Rotary
Spudder
Cable Tools
Storage

Quadrangle Vadis

Permit No. DOD-1097

WELL RECORD

Oil or Gas Well Dry (KIND)

Company Petroleum Promotions, Inc.
Address Box 105, Weston, W. Va.
Farm Henry A'House Acres 91
Location (waters) Brushy Fork
Well No. 1A Elev. 1187
District New Milton County Doddridge
The surface of tract is owned in fee by O. C. Haught
Address Salem, W. Va.
Mineral rights are owned by Same
Address _____
Drilling commenced February 20, 1964
Drilling completed April 1, 1964
Date Shot _____ From _____ To _____
With _____
Open Flow _____ /10ths Water in _____ Inch
_____ /10ths Merc. in _____ Inch
Volume Dry _____ Cu. Ft.
Rock Pressure _____ lbs. _____ hrs.
Oil _____ bbls., 1st 24 hrs.
WELL ACIDIZED No
WELL FRACTURED No


Casing and Tubing	Used in Drilling	Left in Well	Packers
Size			Kind of Packer
16			
18	21"	21'	
10	225'	Pulled	Size of
8 3/4	1150'	Pulled	
6 3/4			Depth set
5 3/16	2331'	Cemented	
3			Perf. top
2			Perf. bottom
Liners Used			Perf. top
			Perf. bottom

CASING CEMENTED 5 1/2 SIZE 2331 No. Ft. 3/16/64 Date
50 sks. Cement, 19sks. Gel

COAL WAS ENCOUNTERED AT None FEET _____ INCHES
_____ FEET _____ INCHES _____ FEET _____ INCHES
_____ FEET _____ INCHES _____ FEET _____ INCHES

RESULT AFTER TREATMENT _____
ROCK PRESSURE AFTER TREATMENT _____
Fresh Water _____ Feet _____ Salt Water _____ Feet

Formation	Color	Hard or Soft	Top	Bottom	Oil, Gas or Water	Depth	Remarks
Soil			0	17			
Red Rock & Shells			17	105			
Shale & Shells			105	189			
Red Rock & Shale			189	312			
Slate & Shells			312	381			
Slate & Sand			381	415			
Red Rock & Shale			415	439			
Sand			439	448			
Red Rock & Shale			448	472			
Lime			472	493			
Red Rock & Shells			493	607			
Sand			607	615			
Slate & Shells			615	633			
Red Rock & Shells			633	680			
Red Rock & Lime			680	740			
Sand			740	775	Water	764'	
Lime & Slate			775	896			
Sandy Lime			896	914			
Slate & Shells			914	962			
Sand			962	1007			
Red Rock & Shale			1007	1054			
Red Rock			1054	1070			
Sand			1070	1080			
Shale & Red Rock			1080	1112			
Lime			1112	1126			
Shale & Shells			1126	1142			
Lime			1142	1146			
Slate			1146	1175			
Lime			1175	1182			
Red Rock & Shale			1182	1194			

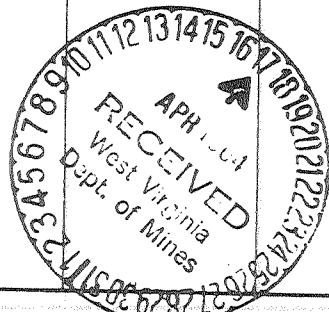

Formation	Color	Hard or Soft	Top 5	Bottom	Oil, Gas or Water	Depth Found	Remarks
Red Rock			1194	1200			
Lime			1200	1237			
Red Rock & Slate			1237	1309			
Shale & Lime			1309	1380			
Lime			1380	1392			
Slate & Shells			1392	1427			
Sand			1427	1506			
Slate & Lime Shells			1506	1580			
Sandy Lime			1580	1615			
Slate & Lime			1615	1645			
Sandy Lime			1645	1685			
Slate & Shells			1685	1730			
Sand			1730	1827			
Sand & Slate			1827	1928	Water	1760-65	6bailers.
Lime			1928	1958			
Sand & Slate			1958	2090			
Sand			2090	2109			
Slate & Shells			2109	2145			
Sandy Lime			2145	2162			
Red Rock & Shale			2162	2293			
Lime			2293	2303			
Slate			2303	2312			
Sand			2312	2377			
Lime			2377	2386			
Sand----			2386	2405			
Lime			2405	2415			
Sandy Lime			2415	2444			
Lime			2444	2470			
Sandy Lime			2470	2490			
Shale			2490	2506			
				TD 2566			

Date 4-16, 1964

APPROVED Jessy M. Meamer, Owner
 By Sept. (Title)