

- New Location.....
- Drill Deeper.....
- Abandonment.....

Company PRIOR OIL COMPANY

Address 224 Washington Blvd., Belpre, Ohio

Farm J. A. Wilcox

Tract \_\_\_\_\_ Acres 40.5 Lease No. \_\_\_\_\_

Well (Farm) No. Two Serial No. \_\_\_\_\_

Elevation (Spirit Level) 1219

Quadrangle Centerpoint - WC

County Doddridge District West Union

Engineer W. Steel

Engineer's Registration No. 1227

File No. \_\_\_\_\_ Drawing No. \_\_\_\_\_

Date May 22, 1965 Scale 1" = 200' = 330'

STATE OF WEST VIRGINIA  
DEPARTMENT OF MINES  
OIL AND GAS DIVISION  
CHARLESTON

**WELL LOCATION MAP**

FILE NO. DOD - 1257

† Denotes location of well on United States Topographic Maps, scale 1 to 62,500, latitude and longitude lines being represented by border lines as shown.

— Denotes one inch spaces on border line of original tracing.

66 97



STATE OF WEST VIRGINIA  
DEPARTMENT OF MINES  
OIL AND GAS DIVISION

Rotary   
Spudder   
Cable Tools   
Storage

Quadrangle Centerpoint

WELL RECORD

Oil or Gas Well Oil

Permit No. DOD-1257

Company Prior Oil Company  
Address 224 Washington Blvd., Belpre, Ohio  
Farm J. A. Wilcox Acres 40.5  
Location (waters) Nutter Fork  
Well No. Two Elev. 1219  
District West Union County Doddridge  
The surface of tract is owned in fee by Foster et al  
Address Weston, W. Va.  
Mineral rights are owned by Foster et al  
Address Weston, W. Va.  
Drilling commenced June 8, 1965  
Drilling completed July 10, 1965  
Date Shot \_\_\_\_\_ From \_\_\_\_\_ To \_\_\_\_\_  
With \_\_\_\_\_  
Open Flow \_\_\_\_\_ /10ths Water in \_\_\_\_\_ Inch  
\_\_\_\_\_ /10ths Merc. in \_\_\_\_\_ Inch  
Volume \_\_\_\_\_ Cu. Ft.  
Rock Pressure \_\_\_\_\_ lbs. \_\_\_\_\_ hrs.  
Oil \_\_\_\_\_ bbls., 1st 24 hrs.  
WELL ACIDIZED \_\_\_\_\_  
WELL FRACTURED 15,000# sand 20/40 500 bbls. water


Casing and Tubing	Used in Drilling	Left in Well	Packers
Size			Kind of Packer
16			
14 <sup>1</sup> / <sub>2</sub>	20'	20'	
10			Size of
8 <sup>3</sup> / <sub>4</sub>	1258		
6 <sup>5</sup> / <sub>8</sub>	2078		Depth set
5 3/16			
4 <sup>1</sup> / <sub>2</sub>	2224	2224	Perf. top 1893
2			Perf. bottom 1895
Liners Used			Perf. top
			Perf. bottom

CASING CEMENTED 4<sup>1</sup>/<sub>2</sub> SIZE 2224 No. Ft. 7/4/65 Date

COAL WAS ENCOUNTERED AT (No Coal) FEET \_\_\_\_\_ INCHES  
\_\_\_\_\_ FEET \_\_\_\_\_ INCHES FEET 2 INCHES  
\_\_\_\_\_ FEET \_\_\_\_\_ INCHES FEET \_\_\_\_\_ INCHES

RESULT AFTER TREATMENT 10 bbls. oil  
ROCK PRESSURE AFTER TREATMENT 525#  
Fresh Water None Recorded Feet \_\_\_\_\_ Salt Water None Recorded Feet \_\_\_\_\_

Formation	Color	Hard or Soft	Top	Bottom	Oil, Gas or Water	Depth	Remarks
Surface			0	10			
Red Rx			10	45			
Yellow Sand			45	87			
Red Rock			87	132			
Gray Shale			132	147			
Sand			147	180			
Gray Shale			180	192			
Red Rock			192	240			
Gray Shale			240	270			
Red Rock			270	308			
Gray Shale			308	357			
Lime			357	400			
Red Rock			400	429			
Lime			429	445			
Gray Shale			445	475			
Lime			475	492			
Gray Shale			492	521			
Lime			521	540			
Red Rock			540	552			
Gray Shale			552	580			
Lime			580	602			
Red Rx.			602	610			
Slate & Shells			610	632			
Lime			632	675			
Red Rock & Shells			675	705			
Gray Shale			705	721			
Sand			721	750			
Gray Shale			750	937			
Red Rx.			937	957			

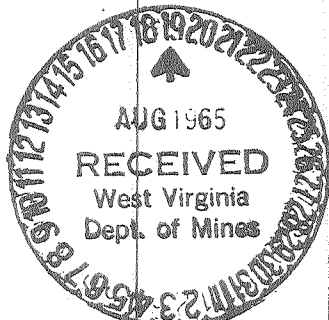

Formation	Color	Hard or Soft	Top /	Bottom	Oil, Gas or Water	Depth Found	Remarks
Gray Shale			957	1020			
Lime			1020	1050			
Gray Shale			1050	1110			
Dark Shale			1110	1130			
Slate & Shells			1130	1164			
Red Rock			1164	1205			
Gray Shale			1205	1252			
Lime			1252	1276			
Sand			1276	1295			
Slate & Shells			1295	1333			
Sand			1333	1355			
Gray Shale			1355	1370			
Grit Shale			1370	1425			
Sand			1425	1480			
Gray Shale			1480	1570			
Sand			1570	1610			
Slate & Shells			1610	1622			
Sand			1622	1755			
Shale			1755	1818			
Sand			1818	1915			
Gray Shale			1915	1936			
Slate & Shells			1936	2031			
Lime			2031	2043			
Shale			2043	2064			
Lime (Broken)			2064	2090			
Sand			2090	2095			
Lime			2095	2170			
Sand			2170	2193			
Lime			2193				
Oil Showing between 2180 and 2185							
TOTAL DEPTH -- 2224							

Date August 17, 1965

APPROVED PRIOR OIL COMPANY, Owner

By Herold L. Duor  
(Title)