

I, the undersigned, hereby certify that this map is correct to the best of my knowledge and belief and shows all of the information required by paragraph 6 of the rules and regulations of the oil and gas section of the mining laws of West Virginia.

W. H. Stearman
 S. P. A. No. 12

New Location.....
 Drill Deeper.....
 Abandonment.....

Elev. ref.: Statewide No. 1: 973'
 Error in Closure: - Less than 1 in 200

Company Statewide Oil & Gas Co.
 Address 224 S. Greenwood, Marion, Ohio
 Farm F. & H. Stearman
 Tract _____ Acres 25.00 Lease No. _____
 Well (Farm) No. 1-G Serial No. _____
 Elevation (Spirit Level) 1077
 Quadrangle Kedis *we*
 County Doddridge District Cann
 Engineer W. H. Stearman
 Engineer's Registration No. 1227
 File No. 77-A-38 Drawing No. _____
 Date March 11, 1967 Scale 1" = 300'

STATE OF WEST VIRGINIA
 DEPARTMENT OF MINES
 OIL AND GAS DIVISION
 CHARLESTON

WELL LOCATION MAP
 FILE NO. Dod-1447

plugged 7/10/1967

+ Denotes location of well on United States Topographic Maps, scale 1 to 62,500, latitude and longitude lines being represented by border lines as shown.

- Denotes one inch spaces on border line of original tracing.

6-0 356



STATE OF WEST VIRGINIA
DEPARTMENT OF MINES
OIL AND GAS DIVISION

- Rotary
- Spudder
- Cable Tools
- Storage

Quadrangle

WELL RECORD

Permit No. DOD-1447

Oil or Gas Well DRY *gas show*
(KIND)

Company <u>Statewide Oil & Gas Co.</u>	Casing and Tubing	Used in Drilling	Left in Well	Packers
Address <u>224 S. Greenwood St. Marion, Ohio</u>	Size			
Farm <u>F. & H. Starrman</u> Acres <u>25</u>	16			Kind of Packer
Location (waters)	13			Size of
Well No. <u>1-G</u> Elev. <u>1077'</u>	10	<u>318'</u>		Depth set
District <u>Cove</u> County <u>Doddridge</u>	8 1/4	<u>1183'</u>		
The surface of tract is owned in fee by <u>F. & H. Starrman Brothers</u>	6 3/4	<u>1620'</u>		
Mineral rights are owned by	5 3/16			
Address	4 1/2	<u>2050</u>	<u>2050</u>	Perf. top <u>1018</u>
Drilling commenced <u>3/2/67</u>	3			Perf. bottom
Drilling completed <u>4/16/67</u>	2			Perf. top
Date Shot From	Liners Used			Perf. bottom
To				
With				

Attach copy of cementing record.

CASING CEMENTED 4 1/2 SIZE 2050 No. Ft. Date

Amount of cement used (bags) 75

Name of Service Co.

COAL WAS ENCOUNTERED AT None FEET INCHES

FEET INCHES FEET INCHES

FEET INCHES FEET INCHES

WELL ACIDIZED (DETAILS)

WELL FRACTURED (DETAILS)


RESULT AFTER TREATMENT (Initial open Flow or bbls.) 20,000 *MCF* slight show of oil

ROCK PRESSURE AFTER TREATMENT HOURS

Fresh Water None Feet Salt Water Feet

Producing Sand Depth

Formation	Color	Hard or Soft	Top	Bottom	Oil, Gas or Water	Depth	Remarks
Clay			0	15			
Sand			15	40			
Red Rock & Slate			40	240			
Lime			240	280			
Slate & Red Rock			280	425			
Lime			425	500			
Slate & Red Rock			500	606			
Sand			606	645			
Slate & Red Rock			645	745			
Sand			745	785			
Slate & Shells			785	900			
Sand			900	940			
Slate & Red Rock			940	1320			
Sand			1320	1370			
Slate			1370	1380			
Sand			1380	1450			
Slate			1450	1580			
Sand			1580	1620			
Slate			1620	1650			
Sand			1650	1700			
Lime <i>Big Lime</i>			1700	1845			
Sand <i>Big Injun</i>			1845	1940			
Slate			1940	1945			
Sand <i>Squaw</i>			1945	1968			
Slate			1968				

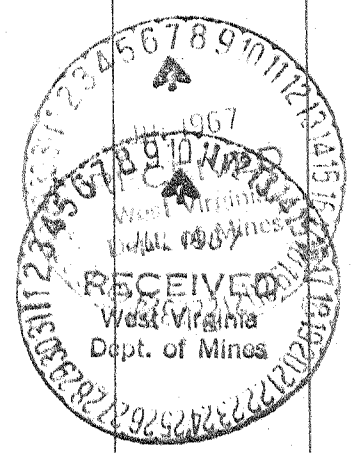

STATE OF WEST VIRGINIA
DEPARTMENT OF MINES
OIL AND GAS DIVISION

AFFIDAVIT OF PLUGGING AND FILLING WELL

AFFIDAVIT SHOULD BE MADE IN TRIPPLICATE, ONE COPY MAILED TO THE DEPARTMENT, ONE COPY TO BE RETAINED BY THE WELL OPERATOR AND THE THIRD COPY (AND EXTRA COPIES IF REQUIRED) SHOULD BE MAILED TO EACH COAL OPERATOR AT THEIR RESPECTIVE ADDRESSES.

None
COAL OPERATOR OR OWNER

Statewide Oil & Gas Co.
NAME OF WELL OPERATOR

224 S. Greenwood St., Marion, Ohio
COMPLETE ADDRESS

July 10 1967
WELL AND LOCATION

Cave District

Dedridge County

F. & M. Starrman, Brothers
LEASE OR PROPERTY OWNER

Well No. 1-0

Starrman Farm


STATE INSPECTOR SUPERVISING PLUGGING Mr. William Blosser

AFFIDAVIT

STATE OF WEST VIRGINIA, }
County of Gilmer } ss:

I. I. Morris and Yearl E. Summers
being first duly sworn according to law depose and say that they are experienced in the work of plugging and filling oil and gas wells and were employed by Statewide Oil & Gas Co., well operator, and participated in the work of plugging and filling the above well, that said work was commenced on the 10 day of July, 1967, and that the well was plugged and filled in the following manner:

SAND OR ZONE RECORD FORMATION	FILLING MATERIAL	PLUGS USED SIZE & KIND	CASING	
			CGG PULLED	CGG LEFT IN
1840	Cement	5 Sacks		
1840 - 1255	6% Gel			
1255 - 900	Cement	5 Sacks	4 1/2"	1255
1255 - 900	6% Gel			
900	Cement	5 Sacks		
900 - 318	6% Gel			
318	Cement	10 Sacks		
318 - 75	6% Gel			
75 - 0	Rock & Cement		15"	14"
		Total Cement 34 Sacks		
COAL SEAMS		DESCRIPTION OF MONUMENT		
(NAME)		8" casing cemented 30" above ground.		
(NAME)				
(NAME)				
(NAME)				

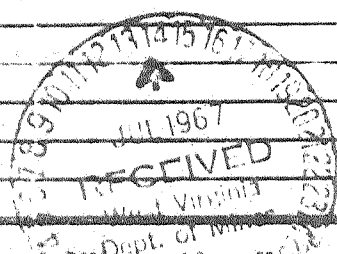

and that the work of plugging and filling said well was completed on the 10 day of July, 1967.

And further deponents saith not.

Sworn to and subscribed before me this 11 day of July, 1967.

Yearl E. Summers
Carol L. Long

My commission expires: Aug 03, 1976

Notary Public.
Permit No. D.O.M. 111-1