

1701506 P

RECEIVED  
Office of Oil and Gas

FEB 25 2015

WV Department of  
Environmental Protection

WW-7  
8-30-06



West Virginia Department of Environmental Protection  
Office of Oil and Gas  
**WELL LOCATION FORM: GPS**

API: 47-017-01506 WELL NO.: WV 655176 (Jones #1235)  
FARM NAME: B. F. Jones, Jr.  
RESPONSIBLE PARTY NAME: EOT Production Company  
COUNTY: Doddridge DISTRICT: West Union  
QUADRANGLE: Smithburg 7.5'  
SURFACE OWNER: Helen Jane Jones Credit Trust  
ROYALTY OWNER: Thomas A. Jones, et al.  
UTM GPS NORTHING: 4348183  
UTM GPS EASTING: 525261 GPS ELEVATION: 260 m (854 ft)

The Responsible Party named above has chosen to submit GPS coordinates in lieu of preparing a new well location plat for a plugging permit or assigned API number on the above well. The Office of Oil and Gas will not accept GPS coordinates that do not meet the following requirements:

1. Datum: NAD 1983, Zone: 17 North, Coordinate Units: meters, Altitude: height above mean sea level (MSL) – meters.
2. Accuracy to Datum – 3.05 meters
3. Data Collection Method:  
Survey grade GPS     : Post Processed Differential       
Real-Time Differential       
Mapping Grade GPS X: Post Processed Differential X  
Real-Time Differential

4. Letter size copy of the topography map showing the well location.

I the undersigned, hereby certify this data is correct to the best of my knowledge and belief and shows all the information required by law and the regulations issued and prescribed by the Office of Oil and Gas.

Signature

PS # 2180  
Title

2/16/15  
Date


Topo Quad: Smithburg 7.5' Scale: 1" = 2000'

County: Doddridge Date: February 12, 2015

District: West Union Project No: 67-30-00-08

47-017-01506 WV 655176 (Jones #1235)

Topo

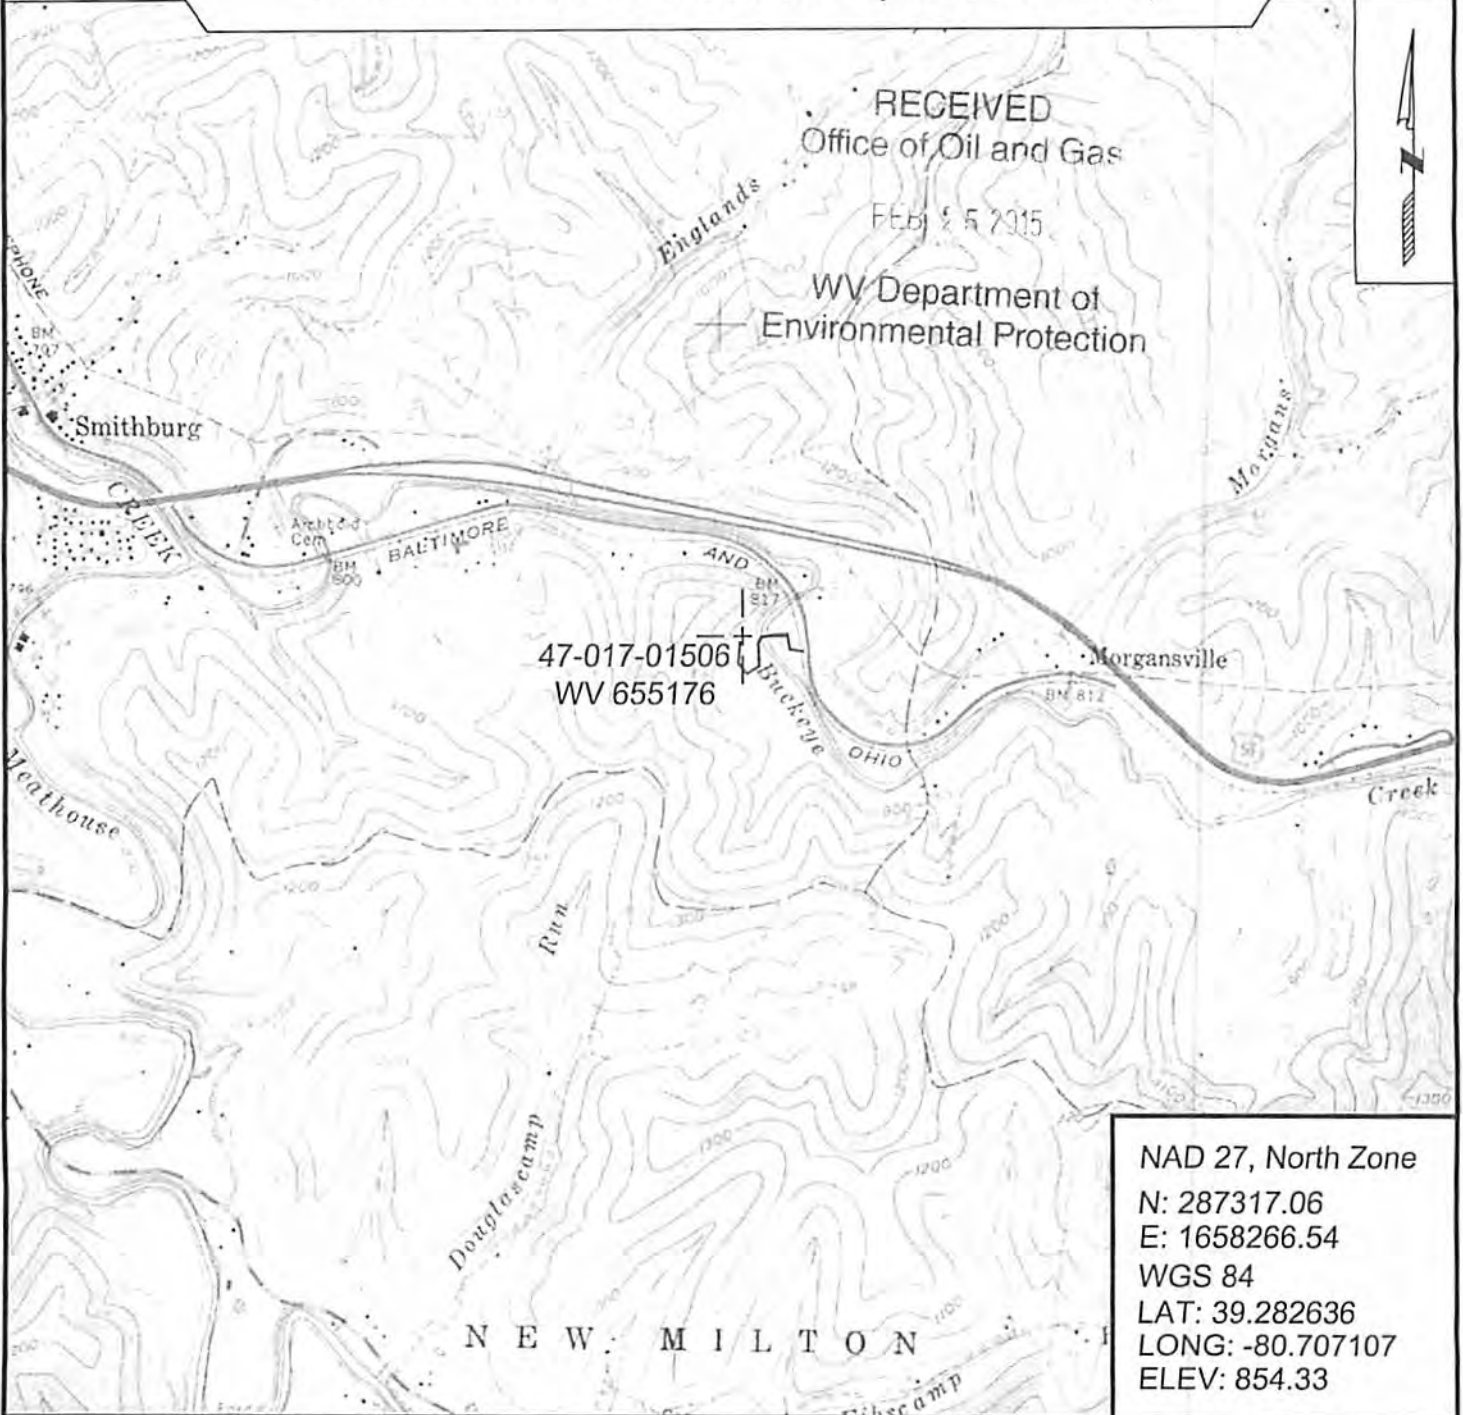

NAD 27, North Zone  
 N: 287317.06  
 E: 1658266.54  
 WGS 84  
 LAT: 39.282636  
 LONG: -80.707107  
 ELEV: 854.33



SURVEYING AND MAPPING SERVICES PERFORMED BY:

**ALLEGHENY SURVEYS, INC.**

1-800-482-8606  
 237 Birch River Road  
 Birch River, WV 26610  
 PH: (304) 649-8606  
 FAX: (304) 649-8608

PREPARED FOR:

**EQT Production Company**

P.O. Box 280  
 Bridgeport, WV 26330