

WW-7
8-30-06



West Virginia Department of Environmental Protection
Office of Oil and Gas
WELL LOCATION FORM: GPS

API: 47-017-02106 WELL NO.: WV 604970 (E.W. Summers #4970)

FARM NAME: E.W. Summers

RESPONSIBLE PARTY NAME: EQT Production Company

COUNTY: Doddridge DISTRICT: Southwest

QUADRANGLE: Oxford 7.5'

SURFACE OWNER: James R. Haught

ROYALTY OWNER: Cynthia F. Powell, et al.

UTM GPS NORTHING: 4334064

UTM GPS EASTING: 513355 GPS ELEVATION: 327 m (1074 ft)

The Responsible Party named above has chosen to submit GPS coordinates in lieu of preparing a new well location plat for a plugging permit or assigned API number on the above well. The Office of Oil and Gas will not accept GPS coordinates that do not meet the following requirements:

1. Datum: NAD 1983, Zone: 17 North, Coordinate Units: meters, Altitude: height above mean sea level (MSL) – meters.
2. Accuracy to Datum – 3.05 meters
3. Data Collection Method:

Survey grade GPS : Post Processed Differential
Real-Time Differential

Mapping Grade GPS X: Post Processed Differential X
Real-Time Differential

4. **Letter size copy of the topography map showing the well location.**

I the undersigned, hereby certify this data is correct to the best of my knowledge and belief and shows all the information required by law and the regulations issued and prescribed by the Office of Oil and Gas.

RECEIVED
Office of Oil and Gas
FEB 18 2015

Steve Brown
Signature

PS# 2180
Title

WV Department of Environmental Protection
2/9/16
Date

Topo Quad: Oxford 7.5'

Scale: 1" = 2000'

County: Ritchie


Date: February 9, 2016

District: Union

Project No: 67-30-00-08

47-017-02106 WV 604970 (E. W. Summers #4970)

Topo

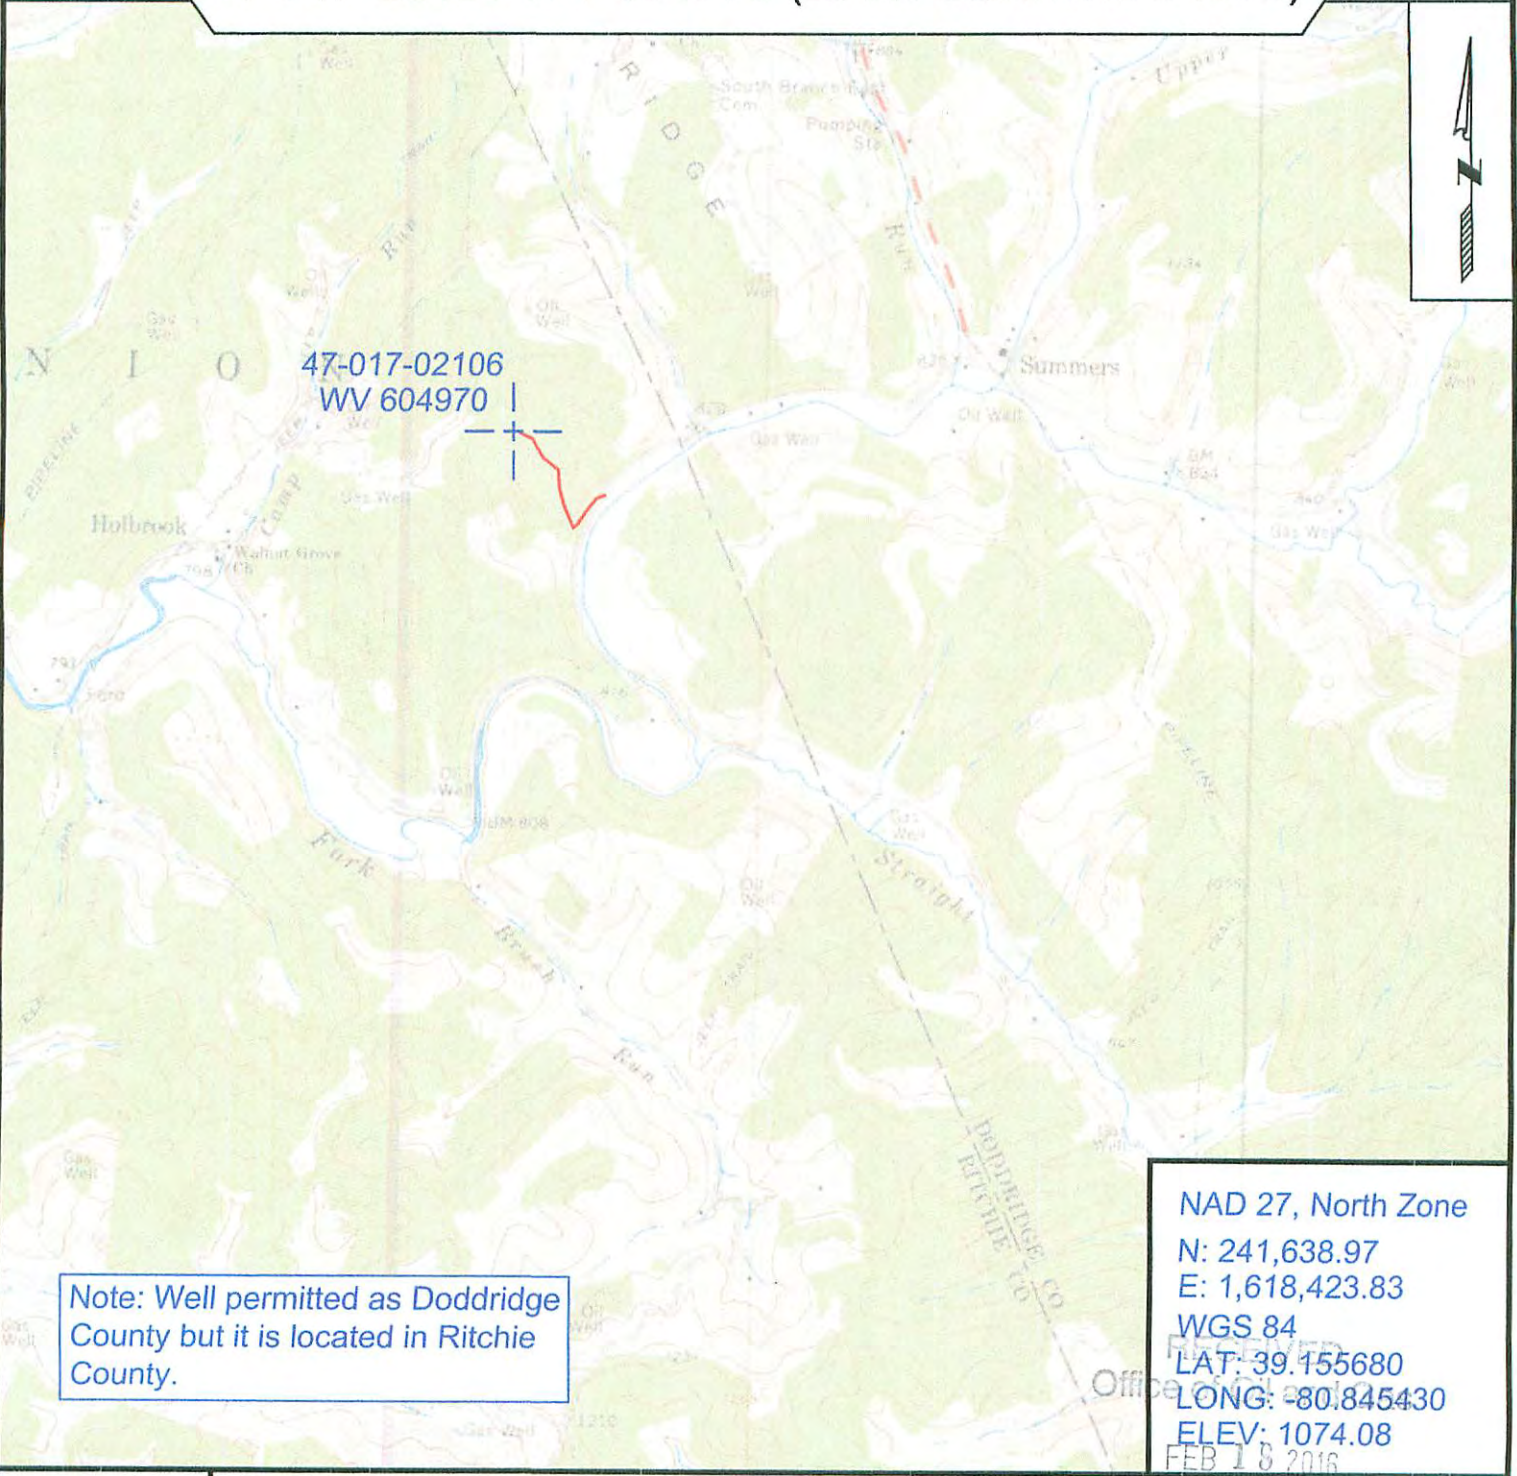

47-017-02106
WV 604970

Note: Well permitted as Doddridge County but it is located in Ritchie County.

NAD 27, North Zone
N: 241,638.97
E: 1,618,423.83
WGS 84
LAT: 39.155680
LONG: -80.845430
ELEV: 1074.08
FEB 18 2016



SURVEYING AND MAPPING SERVICES PERFORMED BY:
ALLEGHENY SURVEYS, INC.
1-800-482-8606
237 Birch River Road
Birch River, WV 26610
PH: (304) 649-8606
FAX: (304) 649-8608

PREPARED FOR:
EQT Production Company
WV Department of Environmental Protection
P.O. Box 280
Bridgeport, WV 26330
03/11/2016