

1702107 A

WW-7  
8-30-06



West Virginia Department of Environmental Protection  
Office of Oil and Gas  
**WELL LOCATION FORM: GPS**

API: 47-017-02107 WELL NO.: WV 604983 (Rosa B. Rymer #4983)

FARM NAME: Rymer

RESPONSIBLE PARTY NAME: EQT Production Company

COUNTY: Doddridge DISTRICT: South West

QUADRANGLE: Oxford 7.5'

SURFACE OWNER: Edward S. & Gina B. Bassett

ROYALTY OWNER: Marian G. Zorn, et al.

UTM GPS NORTHING: 4335224

UTM GPS EASTING: 517152 GPS ELEVATION: 303 m (994 ft)

The Responsible Party named above has chosen to submit GPS coordinates in lieu of preparing a new well location plat for a plugging permit or assigned API number on the above well. The Office of Oil and Gas will not accept GPS coordinates that do not meet the following requirements:

1. Datum: NAD 1983, Zone: 17 North, Coordinate Units: meters. Altitude: height above mean sea level (MSL) – meters.
2. Accuracy to Datum – 3.05 meters
3. Data Collection Method:

Survey grade GPS     : Post Processed Differential       
Real-Time Differential     

Mapping Grade GPS X: Post Processed Differential X  
Real-Time Differential     

4. **Letter size copy of the topography map showing the well location.** WV Department of Environmental Protection  
I the undersigned, hereby certify this data is correct to the best of my knowledge and belief and shows all the information required by law and the regulations issued and prescribed by the Office of Oil and Gas.

RECEIVED  
Office of Oil and Gas

FEB 17 2015

Signature

PS # 2180  
Title

1/23/15  
Date

1702107 P

Topo Quad: Oxford 7.5'

Scale: 1" = 2000'

County: Doddridge


Date: January 21, 2015

District: South West

Project No: 67-30-00-08

47-017-02107 WV 604983 (Rosa B. Rymer #4983)

Topo

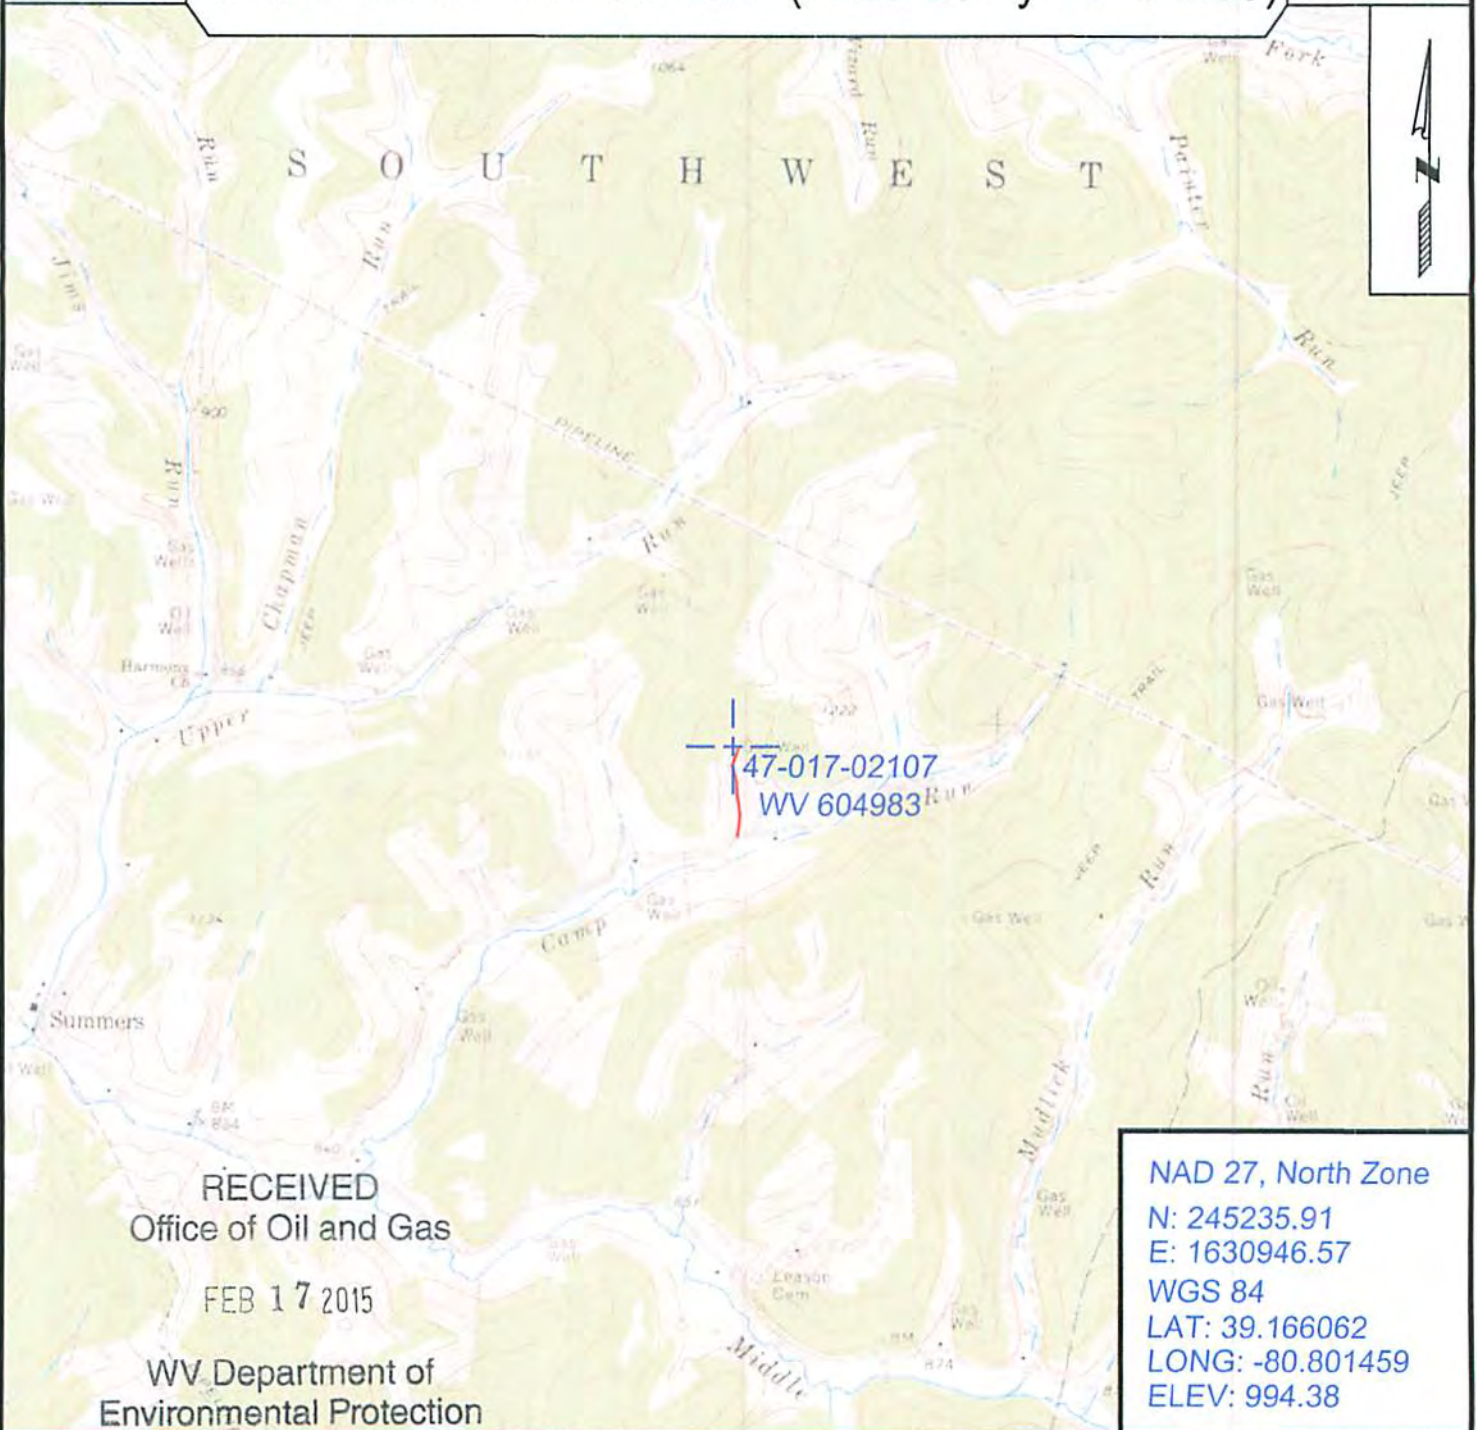

RECEIVED  
Office of Oil and Gas

FEB 17 2015

WV Department of  
Environmental Protection

NAD 27, North Zone  
N: 245235.91  
E: 1630946.57  
WGS 84  
LAT: 39.166062  
LONG: -80.801459  
ELEV: 994.38



SURVEYING AND MAPPING SERVICES PERFORMED BY:

**ALLEGHENY SURVEYS, INC.**

1-800-482-8606  
237 Birch River Road  
Birch River, WV 26610  
PH: (304) 649-8606  
FAX: (304) 649-8608

PREPARED FOR:

**EQT Production Company**

P.O. Box 280  
Bridgeport, WV 26330