

WW-7
8-30-06



West Virginia Department of Environmental Protection
Office of Oil and Gas
WELL LOCATION FORM: GPS

API: 47-017-02114 WELL NO.: WV 606111 (Gaston Heirs #6111)

FARM NAME: Gaston

RESPONSIBLE PARTY NAME: EQT Production Company

COUNTY: Doddridge DISTRICT: South West

QUADRANGLE: Oxford 7.5'

SURFACE OWNER: Donald L. White Sr. & Anne K. White

ROYALTY OWNER: Jeanette Kiracofe, et al.

UTM GPS NORTHING: 4334659

UTM GPS EASTING: 516882 GPS ELEVATION: 300 m (984 ft)

The Responsible Party named above has chosen to submit GPS coordinates in lieu of preparing a new well location plat for a plugging permit or assigned API number on the above well. The Office of Oil and Gas will not accept GPS coordinates that do not meet the following requirements:

1. Datum: NAD 1983, Zone: 17 North, Coordinate Units: meters, Altitude: height above mean sea level (MSL) – meters.
2. Accuracy to Datum – 3.05 meters
3. Data Collection Method:

Survey grade GPS : Post Processed Differential
Real-Time Differential

Mapping Grade GPS X: Post Processed Differential X
Real-Time Differential

4. **Letter size copy of the topography map showing the well location.**

I the undersigned, hereby certify this data is correct to the best of my knowledge and belief and shows all the information required by law and the regulations issued and prescribed by the Office of Oil and Gas.

RECEIVED
Office of Oil and Gas

FEB 17 2015

WV Department of
Environmental Protection


Signature

PS # 2180
Title

1/22/15
Date

1702114A

Topo Quad: Oxford 7.5'

Scale: 1" = 2000'

County: Doddridge


Date: January 21, 2015

District: South West

Project No: 67-30-00-08

47-017-02114 WV 606111 (Gaston Heirs #6111)

Topo

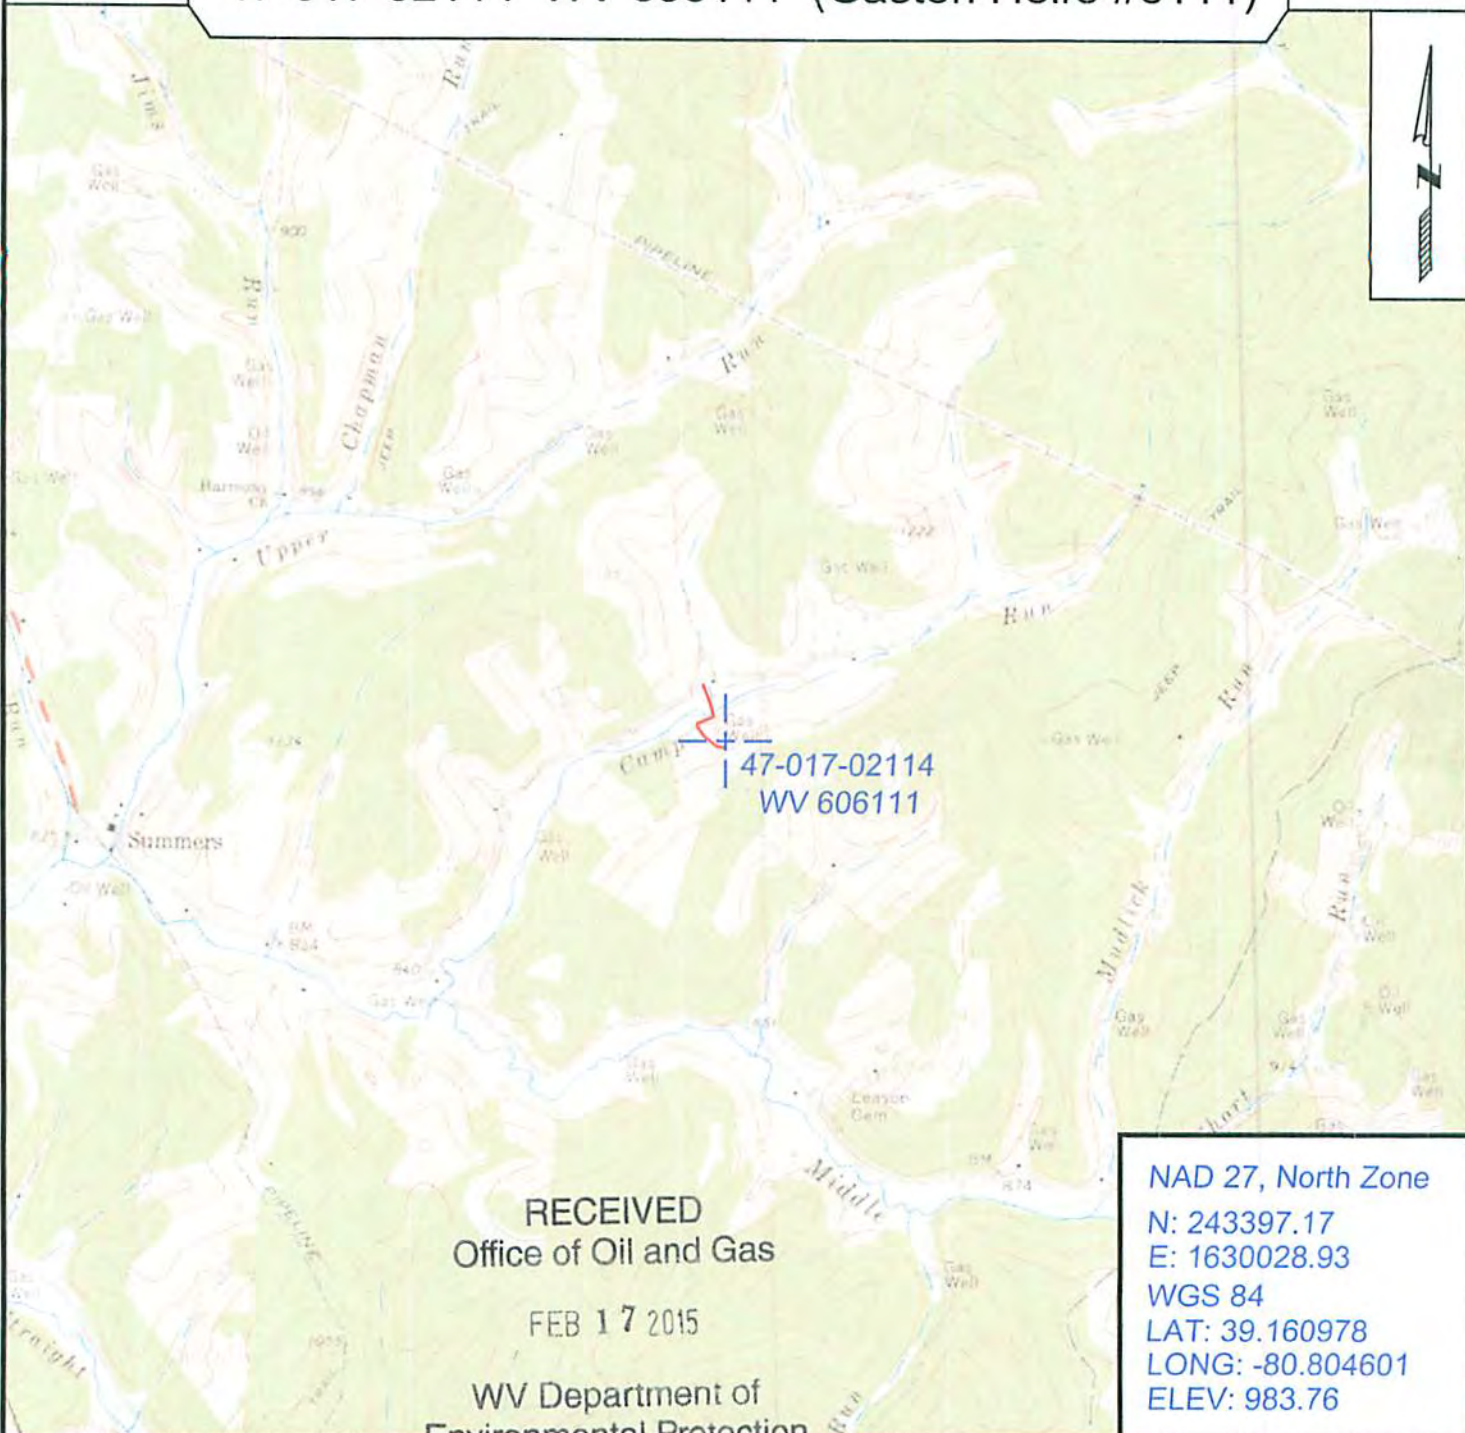

47-017-02114
WV 606111

RECEIVED
Office of Oil and Gas

FEB 17 2015

WV Department of
Environmental Protection

NAD 27, North Zone
N: 243397.17
E: 1630028.93
WGS 84
LAT: 39.160978
LONG: -80.804601
ELEV: 983.76



SURVEYING AND MAPPING SERVICES PERFORMED BY:

ALLEGHENY SURVEYS, INC.

1-800-482-8606
237 Birch River Road
Birch River, WV 26610
PH: (304) 649-8606
FAX: (304) 649-8608

PREPARED FOR:

EQT Production Company

P.O. Box 280
Bridgeport, WV 26330