


LATITUDE 39°07'30"

LONGITUDE 80°45'00"

Dodd - 3200

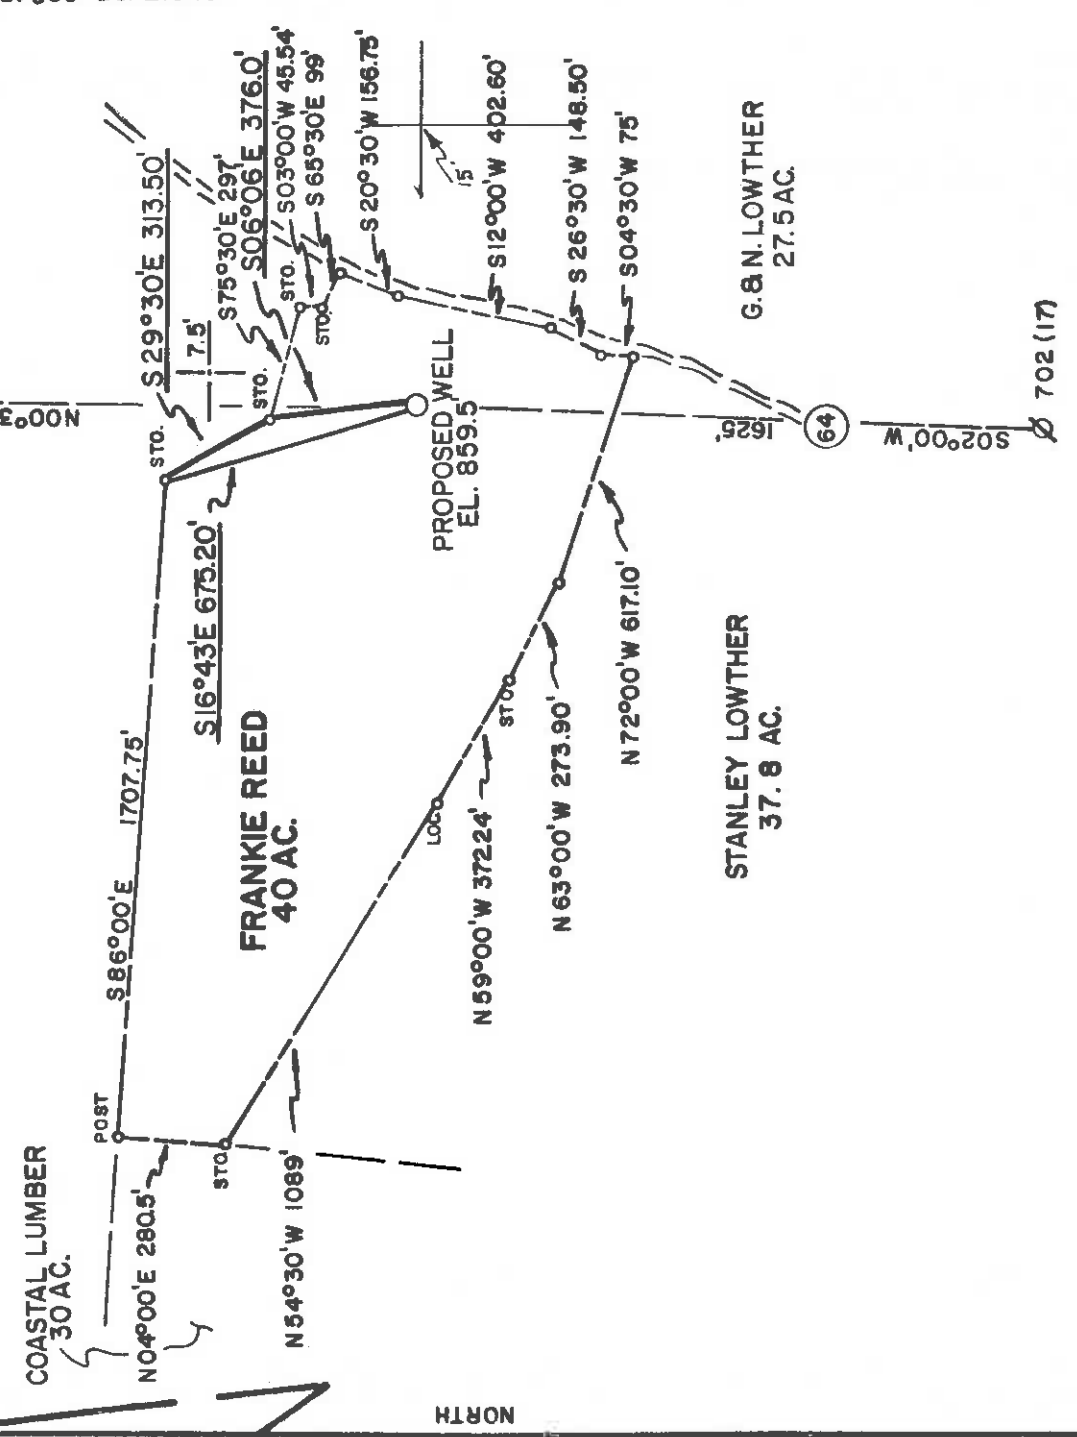

PREPARED BY MOUNTAIN STATE ENVIRONMENTAL SERVICE

FILE NO. MSES 135
 DRAWING NO. _____
 SCALE 1"=500'
 MINIMUM DEGREE OF ACCURACY 1 PART IN 200
 PROVEN SOURCE OF ELEVATION USGS DISK EL. 901' 4000' NORTHEAST ON RT 64

I, THE UNDERSIGNED, HEREBY CERTIFY THAT THIS PLAT IS CORRECT TO THE BEST OF MY KNOWLEDGE AND BELIEF AND SHOWS ALL THE INFORMATION REQUIRED BY LAW AND THE REGULATIONS ISSUED AND PRESCRIBED BY THE DEPARTMENT OF MINES.

(SIGNED) John D. Bailey
 R.P.E. _____ V.L.S. 652

(+) DENOTES LOCATION OF WELL ON UNITED STATES TOPOGRAPHIC MAPS
 FORM IV-6
 (8-78)



Department of Mines
 Oil & Gas Division

DATE NOVEMBER 1 19 82
 OPERATOR'S WELL NO. D-12
 API WELL NO. 47-017-3200
 STATE W.V. COUNTY CLARKSBURG PERMIT CANCELLED

PLACE SEAL HERE

WELL TYPE: OIL GAS LIQUID INJECTION WASTE DISPOSAL SHALLOW
 (IF "GAS", PRODUCTION STORAGE DEEP RUSH RUN

LOCATION: ELEVATION 859.50 WATER SHED RUSH RUN
 DISTRICT COVE COUNTY DODDRIDGE

QUADRANGLE AUBURN 7.5' (1964)
 SURFACE OWNER FRANKIE REED ACREAGE 40
 OIL & GAS ROYALTY OWNER FRANKIE REED LEASE ACREAGE 70

PROPOSED WORK: DRILL CONVERT DRILL DEEPER REDRILL FRACTURE OR STIMULATE PLUG OFF OLD FORMATION PERFORATE NEW FORMATION OTHER PHYSICAL CHANGE IN WELL (SPECIFY) _____

PLUG AND ABANDON CLEAN OUT AND REPLUG _____
 TARGET FORMATION ALEXANDER ESTIMATED DEPTH 5000'


WELL OPERATOR C.B.P. OIL & GAS CO. INC. DESIGNATED AGENT GUY E. MORRIS JR.
 ADDRESS 437 HOLDEN AVENUE ADDRESS 437 HOLDEN AVENUE
CLARKSBURG, W.V. 26301 CLARKSBURG, W.V. 26301

ALLEN BLUEPRINT Co.

Charleston, WV

OCT 23 1982

M.A. 12/19/82 Plot Card CSD

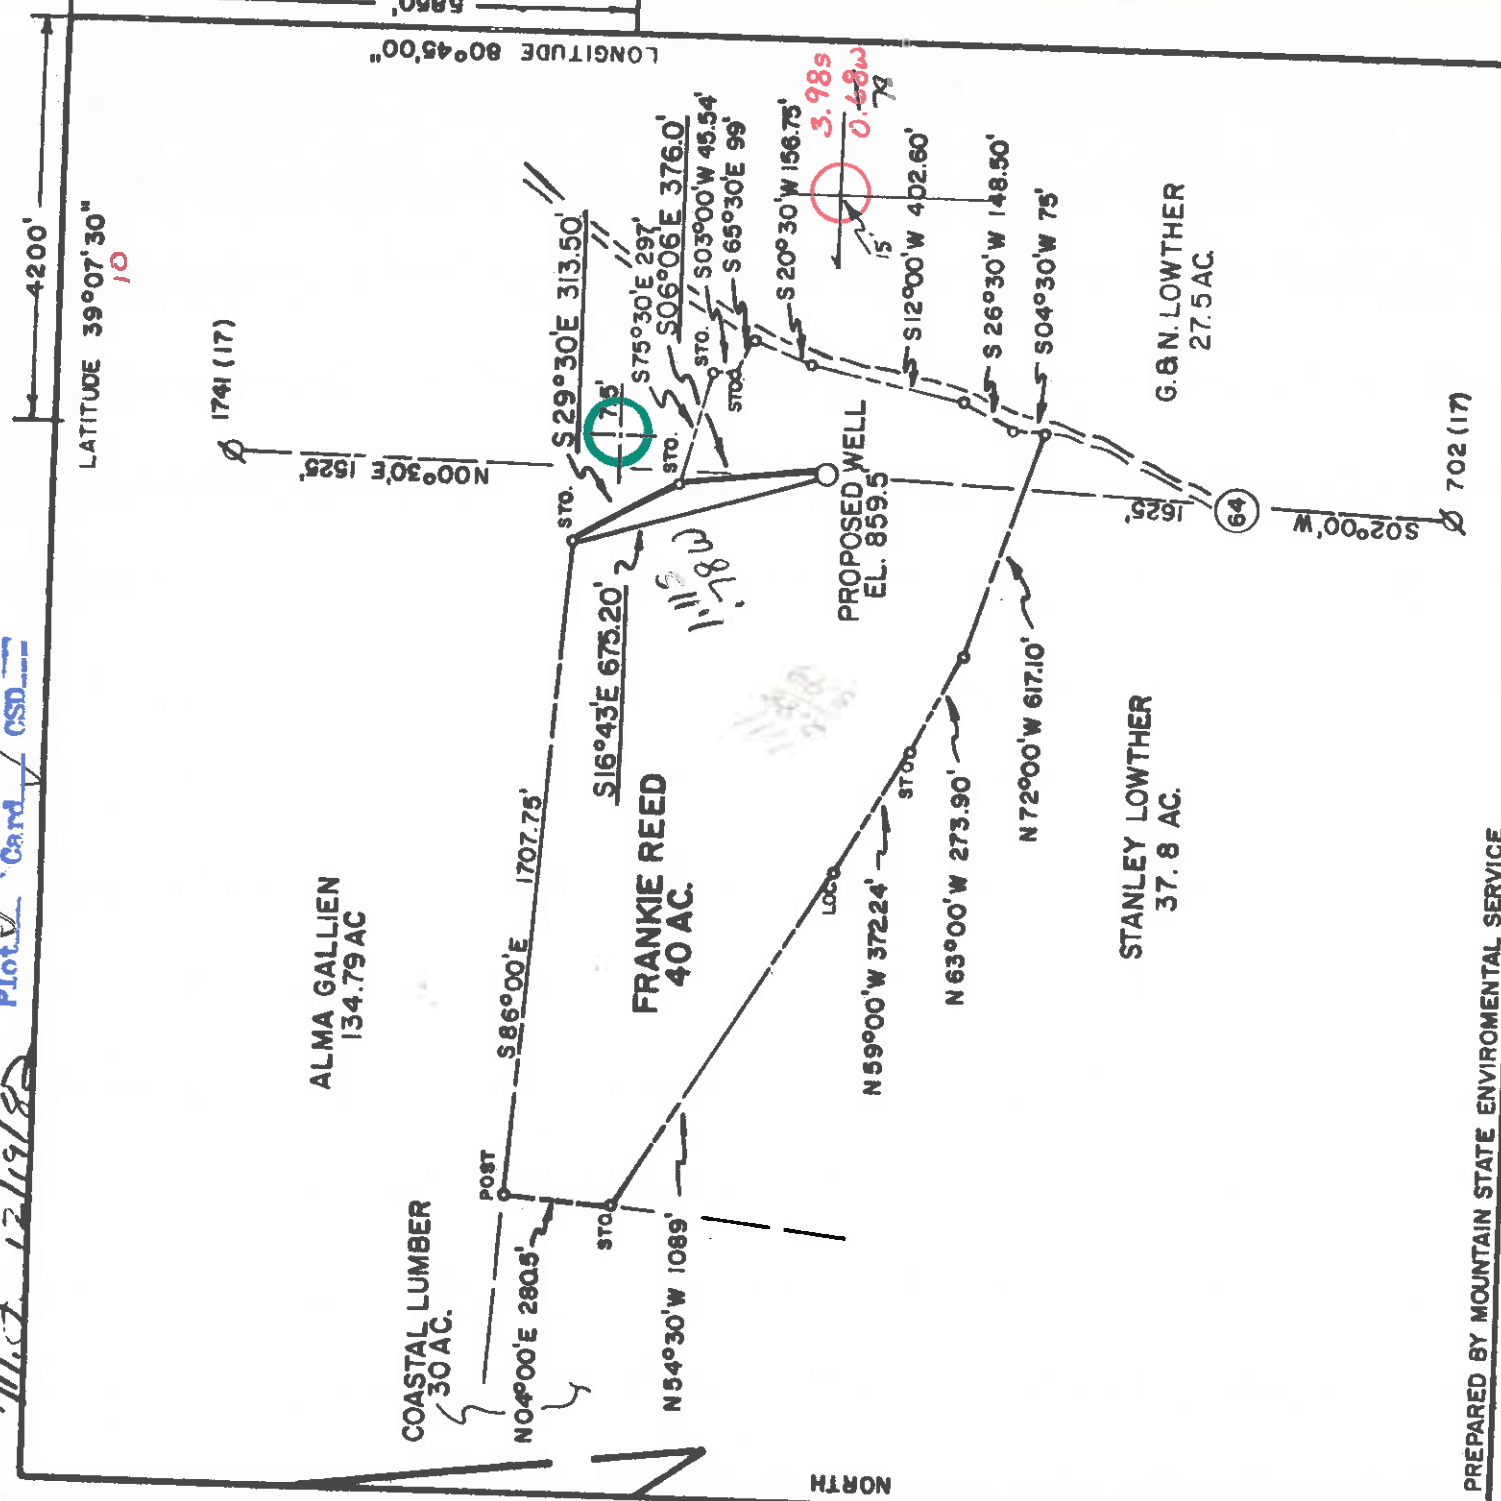

PREPARED BY MOUNTAIN STATE ENVIRONMENTAL SERVICE

FILE NO. MSES 135
 DRAWING NO. _____
 SCALE 1"=500'
 MINIMUM DEGREE OF ACCURACY 1 PART IN 200
 PROVEN SOURCE OF ELEVATION USGS DISK EL 901.4000' NORTHEAST OR RT 64

I, THE UNDERSIGNED, HEREBY CERTIFY THAT THIS PLAT IS CORRECT TO THE BEST OF MY KNOWLEDGE AND BELIEF AND SHOWS ALL THE INFORMATION REQUIRED BY LAW AND THE REGULATIONS ISSUED AND PRESCRIBED BY THE DEPARTMENT OF MINES.
 (SIGNED) John D. Bailey
 R.P.E. _____ L.T.S. 652

(+) DENOTES LOCATION OF WELL ON UNITED STATES TOPOGRAPHIC MAPS
 FORM IV-6
 (8-78)



Department of Mines
 Oil & Gas Division

DATE NOVEMBER 1 1982
 OPERATOR'S WELL NO. D-12
 API WELL NO. 47-017
 STATE WV COUNTY DOODRIDGE PERMIT 3200

WELL TYPE: OIL _____ GAS X LIQUID INJECTION _____ WASTE DISPOSAL _____
 (IF "GAS", PRODUCTION STORAGE _____ DEEP _____ SHALLOW X
 LOCATION: ELEVATION 859.50 WATER SHED RUSH RUN
 DISTRICT COVE COUNTY DOODRIDGE
 QUADRANGLE ASBURN 7-8 (1964) Holbrook 15' EC
 SURFACE OWNER FRANKIE REED
 OIL & GAS ROYALTY OWNER FRANKIE REED ACREAGE 40 LEASE ACREAGE 70

PROPOSED WORK: DRILL X CONVERT _____ LEASE NO. _____
 STIMULATE _____ PLUG OFF OLD FORMATION _____ REDRILL _____ FRACTURE OR
 FORMATION _____ OTHER _____ PERFORATE NEW

PLUG AND ABANDON _____ CLEAN OUT AND REPLUG _____
 TARGET FORMATION ALEXANDER ESTIMATED DEPTH 5000'
 WELL OPERATOR C&P OIL & GAS CO. INC. DESIGNATED AGENT GUY E. MORRIS JR.
 ADDRESS 437 HOLDEN AVENUE ADDRESS 437 HOLDEN AVENUE
CLARKSBURG, W.V. 26301 CLARKSBURG, W.V. 26301

ALLEN REPRINT CO.

JAN 03 1983

Line Item Explanation

- 1) Date of Application
- 2) Your well name and number
- 3) To be filled out by office of oil & gas
- 4A) "Oil" means natural crude oil or petroleum and other hydrocarbons, regardless of gravity, which are produced at the well in liquid form by ordinary production methods and which are not the result of condensation of gas after it leaves underground reservoirs. "Gas" means all natural gas and all other fluid hydrocarbons not defined as oil.
- 4B) "Shallow well" means any well drilled and completed in a formation above the top of the uppermost member of the "Onondaga Group" or a depth less than six thousand feet, whichever is shallower.
 "Deep well" means any well drilled and completed in a formation at or below the top of the uppermost member of the "Onondaga Group" or at a depth less than six thousand feet, whatever is shallower.
- 5) Where well is located
- 6) Before a permit can be issued in a corporation, company partnership, or fictitious name, the name must be registered with the Secretary of State Office
- 7) Use separate sheet if necessary
- 8) Present surface owner at time application is filed.
- 9) Optional
- 11) See Reg. 7.01 relating to code §22-4-1k
- 12) "Coal Operator" means any persons, firm, partnership, partnership association or corporation that proposes to or does operate a coal mine. See Note 24
- 13 & 14) As per §22-4-20; See Note 24
- 15) Work that will be attempted—A separate Form IV-2 shall not be required for fracturing or stimulating a well where fracturing or stimulating is to be part of the work for which a permit is sought and is noted as such on the Form IV-2 filed in connection therewith.
- 16) Anticipated formation for which well will be completed
- 17) Self explanatory
- 18) Depth to deepest freshwater, and shallowest salt water, taken from nearby wells corrected for differences in elevation
- 19) All coal seam depths
- 20) Proposed casing program and cementing refer to Code 22-4-5, 22-4-6, 22-4-7, 22-4-8, 22-4-8a Reg 9.01, 15.01, 15.02, 15.03, 15.04, 25.01, 25.02, 25.03, 25.04
- 21) Code 22-4-11(c) - In lieu of filing the lease or leases or other continuing contract or contracts, the applicant for a permit described herein may file the following:
 (1) A brief description of the tract of land including the district and county wherein the tract is located;
 (2) The identification of all parties to all leases or other continuing contractual agreements by which the right to extract, produce or market the oil or gas is claimed;
 (3) The book and page number wherein each such lease or contract by which the right to extract, produce or market the oil or gas is recorded;
 (4) A brief description of the royalty provisions of each such lease or contract.
- 22) Code 22-4-11(d) and 22-4-11(e).
- 23) Regulation 7.02 of the Department of Mines provides that the original and four copies of Form IV-2 must be filed with the Department, accompanied by (i) a plat in the form prescribed by Regulation 11, (ii) a bond in one of the forms prescribed by Regulation 12, or in lieu thereof the other security allowed by Code §22-4-2, (iii) Form IV-9, "Reclamation Plan", applicable to the reclamation required by Code §22-4-12b and Regulation 23, (iv) unless previously paid on the same well, the fee required by Code §22-4-12a, and (v) if applicable, the consent required by Code §22-4-8a from the owner of any water well or dwelling within 200 feet of the proposed well.
- 24) **The above named coal operator, coal owner(s), and coal lessee are hereby notified that any objection they wish to make or are required to make by Code §22-4-3 must be filed with the Department of Mines within fifteen (15) days after the receipt of this Application by the Department.**

The following waiver must be completed by the coal operator and by any coal owner or coal lessee who has recorded a declaration under Code 22-4-20, if the permit is to be issued within fifteen (15) days of receipt thereof.

WAIVER

The undersigned coal operator _____ / owner _____ / lessee _____ / of the coal under this well location has examined this proposed well location. If a mine map exists which covers the area of the well location, the well location has been added to the mine map. The undersigned has no objection to the work proposed to be done at this location, provided, the well operator has complied with all applicable requirements of the West Virginia Code and the governing regulations.

Travis P. Reed

Date: 12/1, 19 82 By _____ Its _____