


INSTRUCTIONS

1) Attach a photo copy of the location of the well on a 7.5 minute Quadrangle with the corresponding Longitude and Latitude.
 2) Designate the location of the well with the symbol(+).

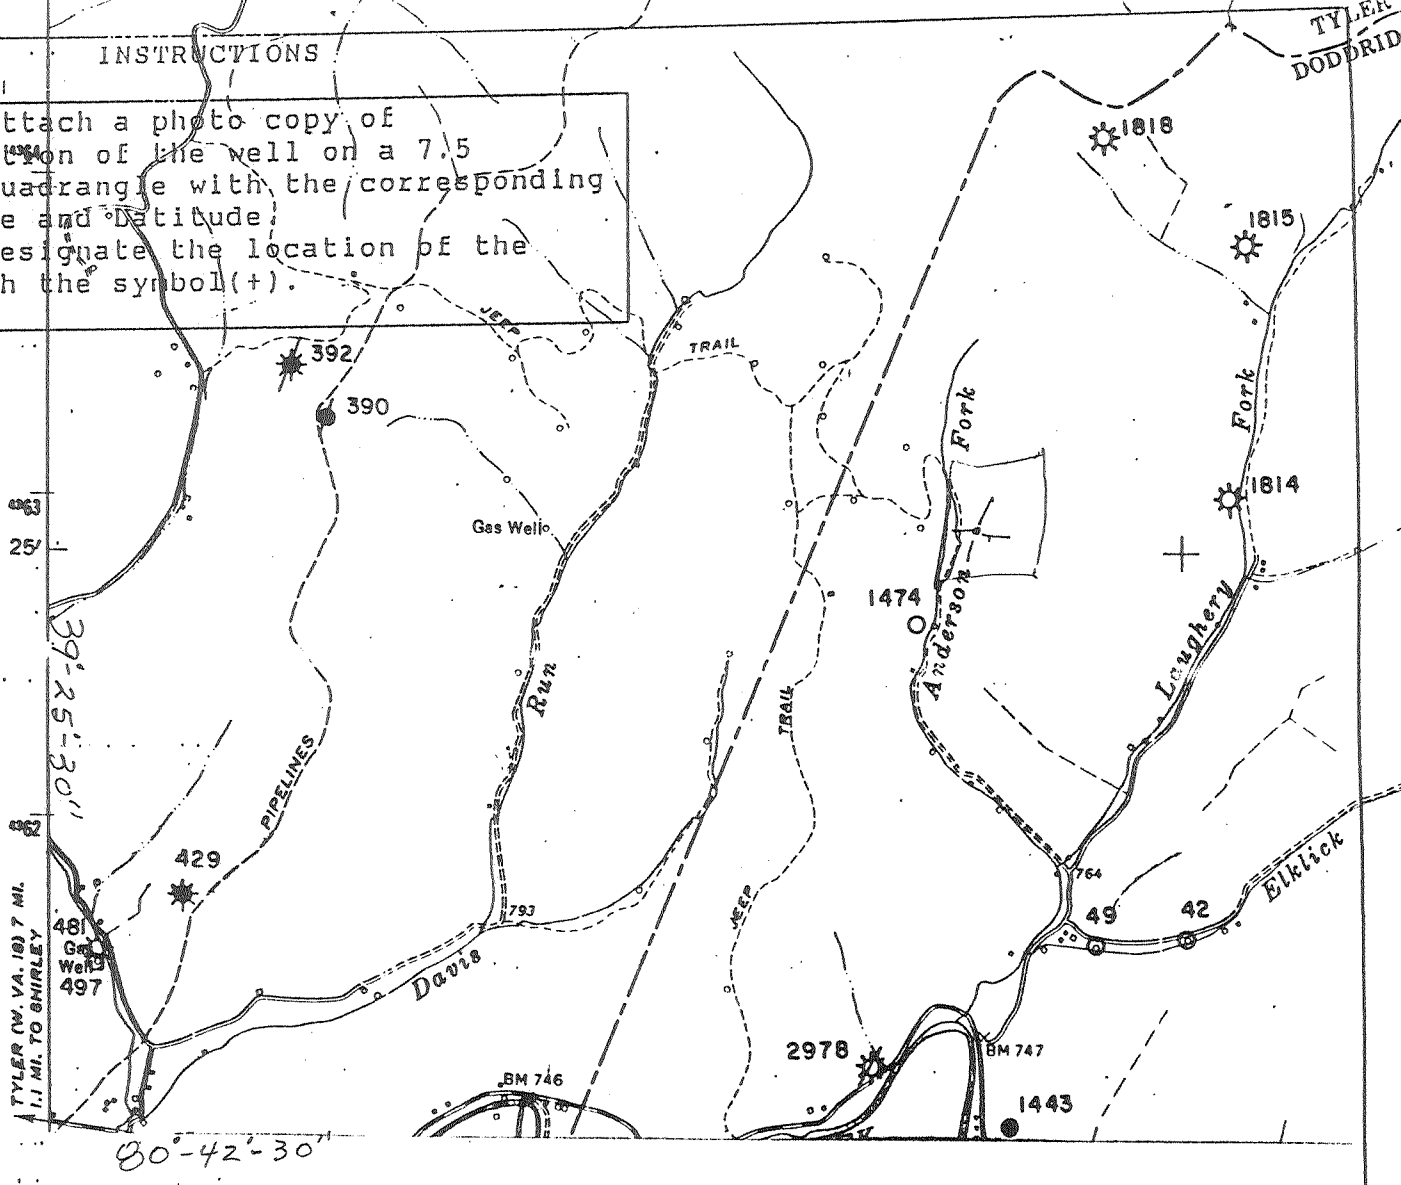

I, the undersigned, Hereby certify that this plat is correct to the best of my knowledge and belief.

SIGNED Charles E. Anderson
 TITLE VICE PRESIDENT

DATE AUGUST 21, 1990
 OPERATORS WELL NO. 2
 API WELL NO. 017-3926

STATE OF WEST VIRGINIA
 DEPARTMENT OF ENERGY
 OIL AND GAS DIVISION

WELL TYPE: OIL GAS LIQUID INJECTION WASTE DISPOSAL
 (If "GAS" PRODUCTION STORAGE DEEP SHALLOW

LOCATION: ELEVATION 880 WATER SHED ANDERSON FORK
 DISTRICT McCELLEN COUNTY DODDRIDGE
 QUADRANGLE CENTERPOINT

SURFACE OWNER COSTAL LUMBER COMPANY ACREAGE 100
 OIL & GAS ROYALTY OWNER OWO HARDMAN HEIRS LEASE ACREAGE 100
 LEASE NO. 6

PRODUCING FORMATION BIG INJUN TOTAL DEPTH 2000

WELL OPERATOR DILMUR OIL COMPANY DESIGNATED AGENT CHARLES E. ANDERSON
 ADDRESS WEST UNION, W.Va. 26456 ADDRESS SAME

O.W.O. HARDMAN.

(6)