

LATITUDE

39° 17' 30"

80 47 30

LONGITUDE

1.76  
0.55

7'5 OGIS topo. location

7.5' loc \_\_\_\_\_

15' loc \_\_\_\_\_  
(calc.) \_\_\_\_\_

Company \_\_\_\_\_

Form: \_\_\_\_\_


Quad \_\_\_\_\_

County \_\_\_\_\_

District \_\_\_\_\_

WELL LOCATION MAP

File No. 017 3927

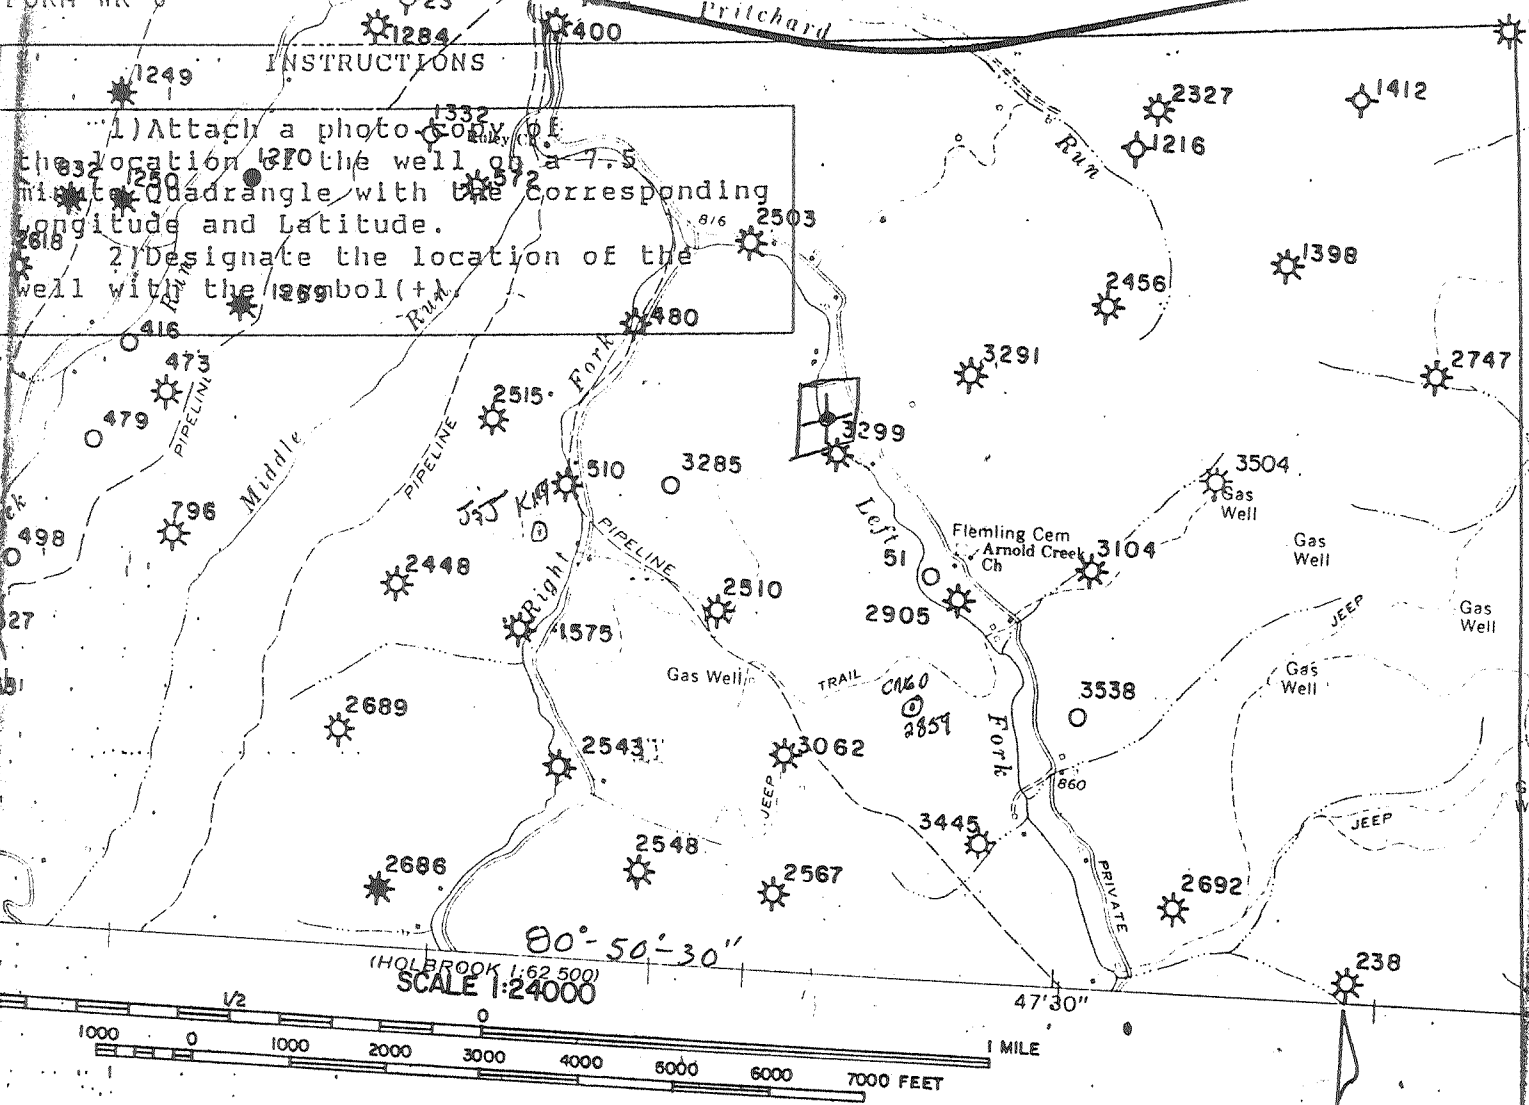

Well locations have been determined based upon information derived from surveyed well plats. Accuracy of well locations is relative to quality of available information.

map may not be reproduced without written consent of Oil & Gas Information Service  
 I, the undersigned, certify that this plat is correct to the best of my knowledge and belief.

SIGNED Charles E. Anderson  
 TITLE VICE PRESIDENT

DATE AUGUST 21, 19 90  
 OPERATORS WELL NO. 1  
 API WELL NO. 017-3927

STATE OF WEST VIRGINIA  
 DEPARTMENT OF ENERGY  
 OIL AND GAS DIVISION

WELL TYPE: OIL  GAS  LIQUID INJECTION  WASTE DISPOSAL   
 (IE "GAS" PRODUCTION  STORAGE  DEEP  SHALLOW   
 LOCATION: ELEVATION 825 WATER SHED LEFT HAND FORK ARONLDS CREEK  
 DISTRICT WEST UNION COUNTY DODDRIDGE  
 QUADRANGLE WEST UNION  
 SURFACE OWNER ANDREW GAINS ACREAGE 110  
 OIL & GAS ROYALTY OWNER T.J. FLEMMINGS HEIRS LEASE ACREAGE 110  
 LEASE NO. 7  
 PRODUCING FORMATION BIG INJUN TOTAL DEPTH 2000  
 WELL OPERATOR DILMUR OIL COMPANY DESIGNATED AGENT CHARLES E. ANDERSON  
CENTERPOINT STAR ROUTE BOX 165  
 ADDRESS WEST UNION, W.V.a 26456 ADDRESS SAME

T. J. FLEMMINGS -

(7)