


INSTRUCTIONS

1) Attach photo copy of the location of the well on a 7.5 minute Quadrangle with the corresponding Longitude and Latitude.  
 2) Designate the location of the well with the symbol (+).

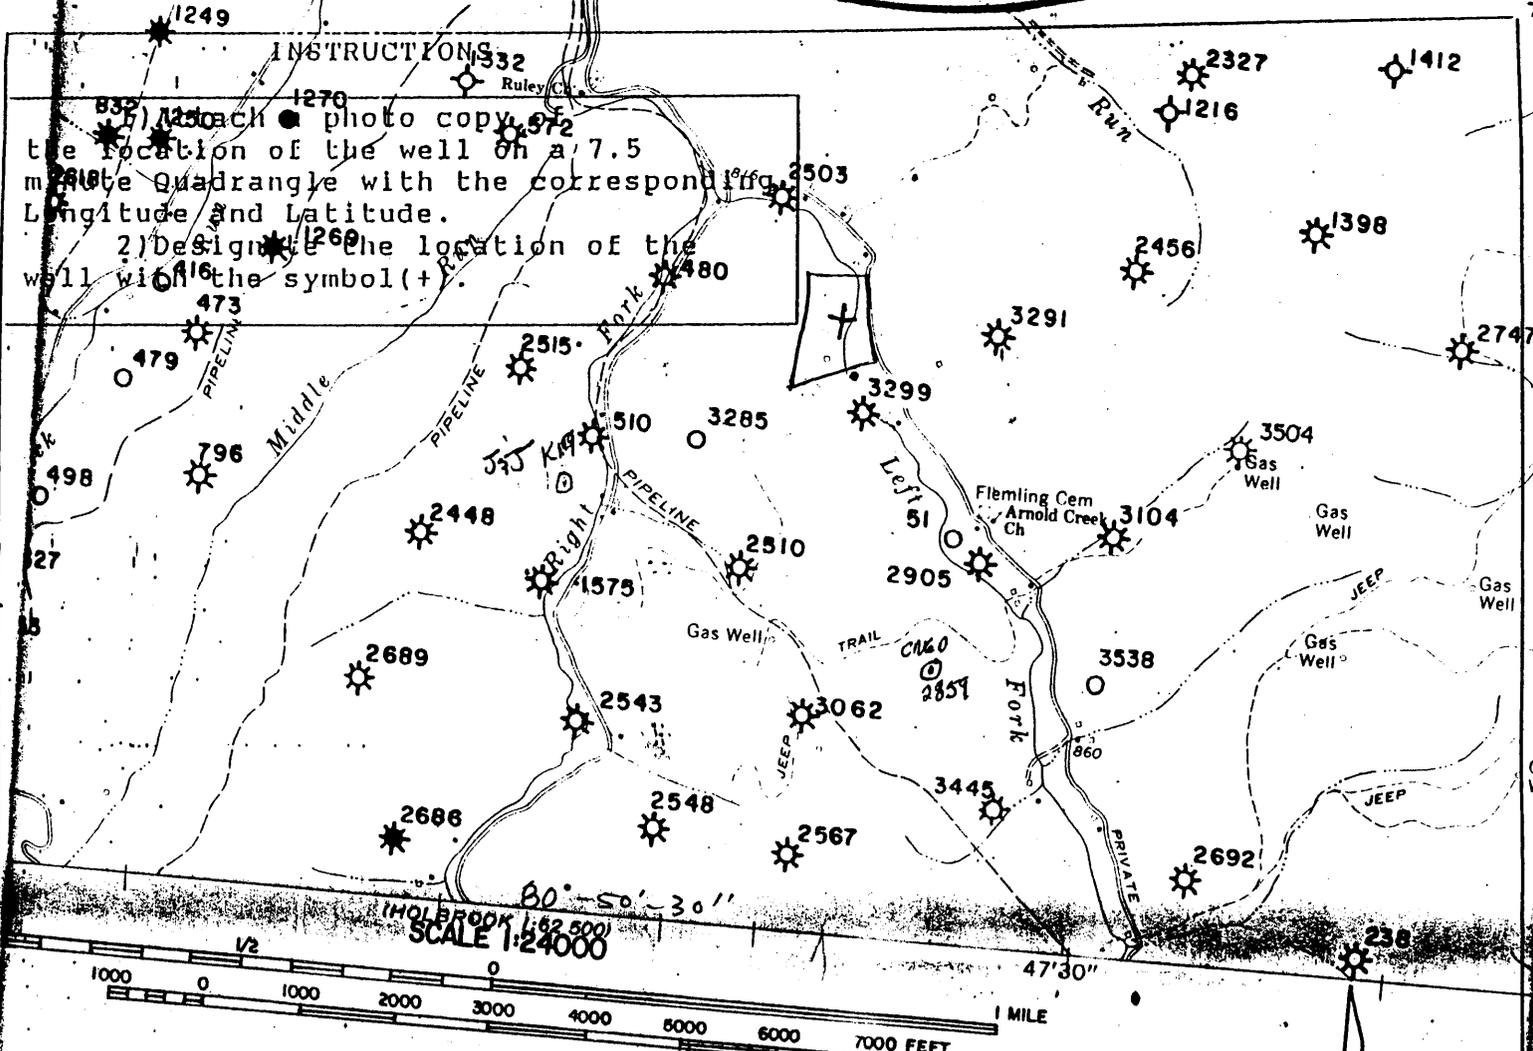

Well locations have been determined based upon information derived from surveyed well plats. Accuracy of well locations is relative to quality of available information.

This map may not be reproduced without written consent of Oil & Gas Information Service

I, the undersigned, hereby certify that this plat is correct to the best of my knowledge and belief.

SIGNED Charles E. Anderson

TITLE VICE PRESIDENT

DATE AUGUST 21, 1990

OPERATORS WELL NO. 1

API WELL NO. 017-3929

STATE OF WEST VIRGINIA  
 DEPARTMENT OF ENERGY  
 OIL AND GAS DIVISION

WELL TYPE: OIL X GAS \_\_\_\_\_ LIQUID INJECTION \_\_\_\_\_ WASTE DISPOSAL \_\_\_\_\_  
 (IE "GAS" PRODUCTION \_\_\_\_\_ STORAGE \_\_\_\_\_ DEEP \_\_\_\_\_ SHALLOW \_\_\_\_\_)

LOCATION: ELEVATION 850 WATER SHED LEFT HAND FORK ARONLDS CREEK  
 DISTRICT WEST UNION COUNTY DODDRIDGE  
 QUADRANGLE WEST UNION

SURFACE OWNER ANDREW GAINS ACREAGE 75

OIL & GAS ROYALTY OWNER WILMER ROLLINS HEIRS LEASE ACREAGE 75  
 LEASE NO. 9

PRODUCING FORMATION BIG INJUN TOTAL DEPTH 2000

WELL OPERATOR DILMUR OIL COMPANY DESIGNATED AGENT CHARLES E. ANDERSON  
 CENTERPOINT STAR ROUTE BOX 165  
 ADDRESS WEST UNION, W.Va. 26456 ADDRESS SAME

