


LATITUDE 39 10 00
090 12 309

INSTRUCTIONS

1) Attach a photo copy of the location of the well on a 7.5 minute Quadrangle with the corresponding Longitude and Latitude.
 2) Designate the location of the well with the symbol(+).

79 S
140 W

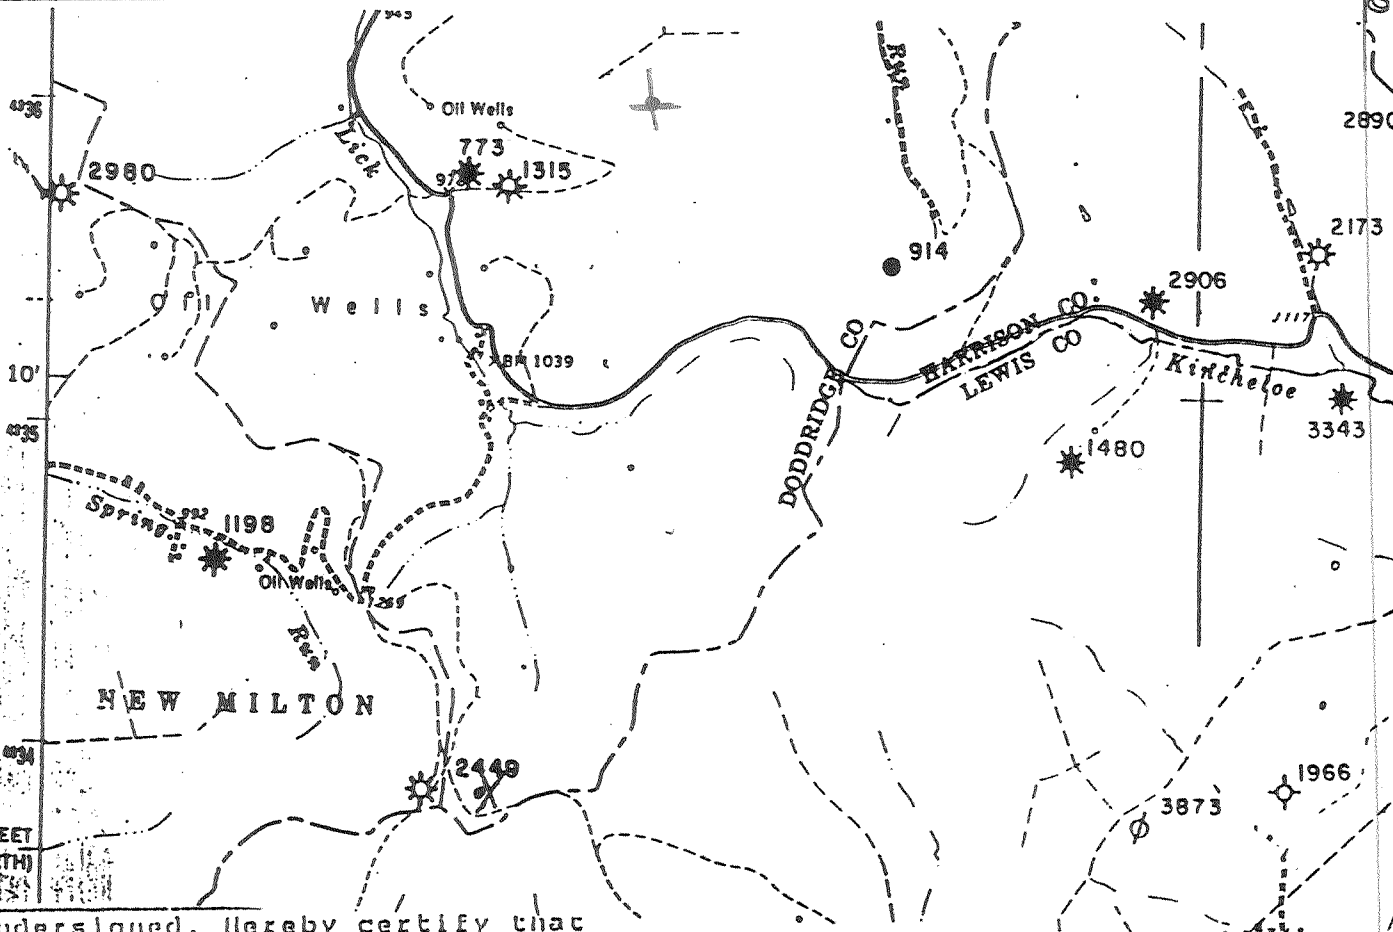

I, the undersigned, hereby certify that this plat is correct to the best of my knowledge and belief.

SIGNED Lowell P. Bee
 TITLE Pres

DATE May 21, 1992
 OPERATORS WELL NO. ED. FOLEY 2
 API WELL NO. 017-3965

STATE OF WEST VIRGINIA
 DEPARTMENT OF ENERGY
 OIL AND GAS DIVISION

WELL TYPE: OIL GAS LIQUID INJECTION _____ WASTE DISPOSAL _____
 (IE "GAS" PRODUCTION STORAGE _____ DEEP _____ SHALLOW _____)

LOCATION: ELEVATION 1325 WATER SHED BEECH LICK RUN
 DISTRICT GREENBRIER COUNTY DODDRIDGE
 QUADRANGLE B16 TSAAC

SURFACE OWNER CLARENCE SMITH JR ACREAGE _____
 OIL & GAS ROYALTY OWNER _____ LEASE ACREAGE 61
 LEASE NO. _____

PRODUCING FORMATION BIG INJUN TOTAL DEPTH 2352
 WELL OPERATOR BEECH LICK O.I., INC. DESIGNATED AGENT Lowell P. Bee
 ADDRESS RT 3 Box 26 ADDRESS RT 3 Box 62
SALEM WV 26426 SALEM WV 26426

JUL 21 1992