


LATITUDE ~~39° 10' 00"~~
39° 12' 30"

LONGITUDE ~~80° 57' 30"~~
80° 55' 00"

INSTRUCTIONS

1) Attach a photo copy of the location of the well on a 7.5 minute Quadrangle with the corresponding Longitude and Latitude.
2) Designate the location of the well with the symbol (+).

2.60 S
2.04 W

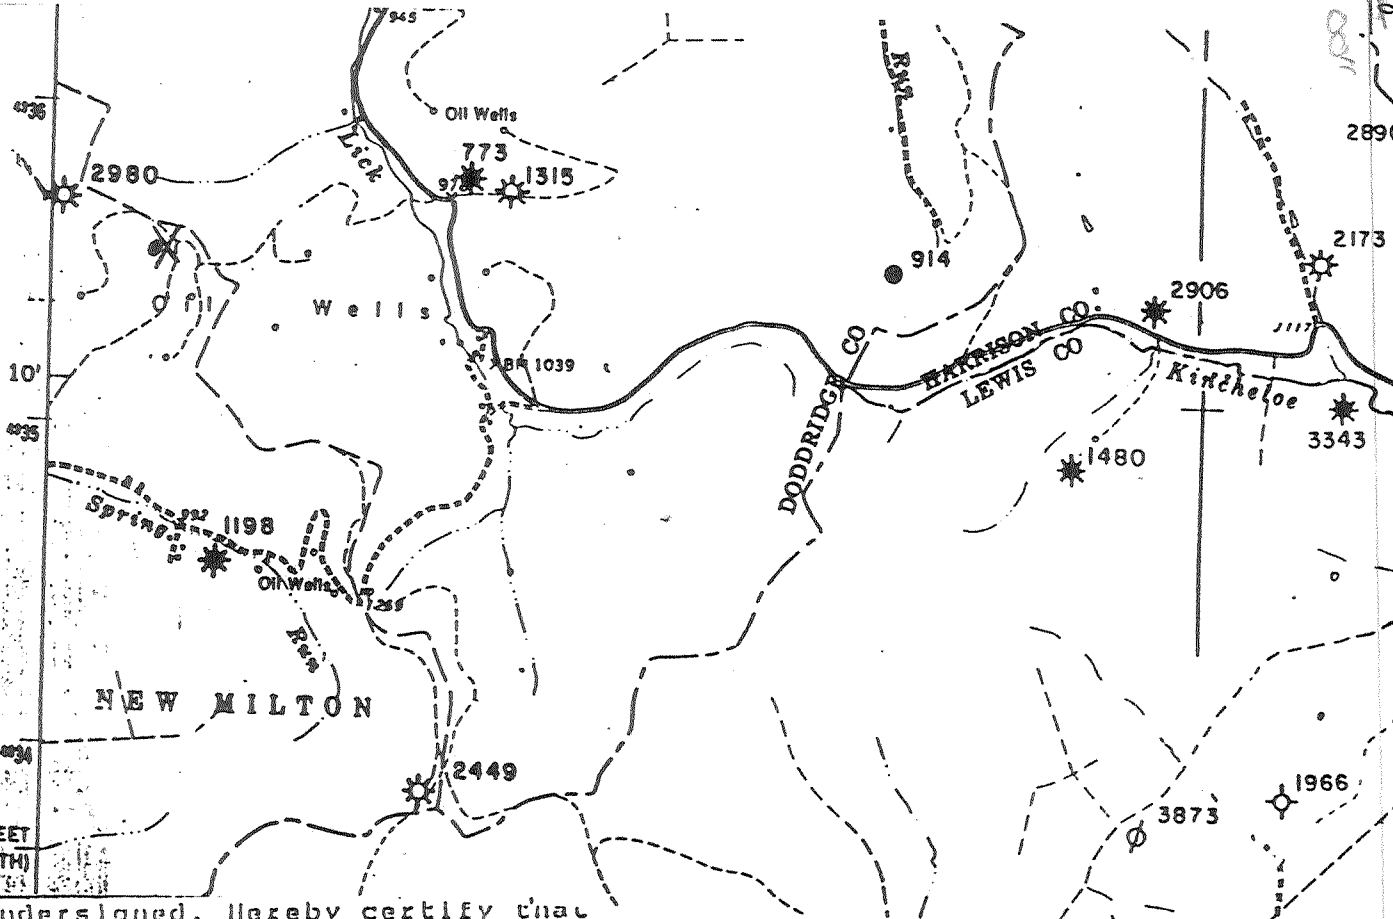

I, the undersigned, hereby certify that this plat is correct to the best of my knowledge and belief.



SIGNED Lowell P Bee

TITLE Pres

DATE May 20, 1992

OPERATORS WELL NO. C.E. Nicholson 3

API WELL NO. 017-3969

STATE OF WEST VIRGINIA
DEPARTMENT OF ENERGY
OIL AND GAS DIVISION

WELL TYPE: OIL GAS LIQUID INJECTION _____ WASTE DISPOSAL _____
(IE "GAS" PRODUCTION STORAGE _____ DEEP _____ SHALLOW _____)

LOCATION: ELEVATION 1200 WATER SHED SPRING RUN
DISTRICT NEW MILTON COUNTY DODDRIDGE
QUADRANGLE BIG ISAAC

SURFACE OWNER LOUISE CAIN WALKINS ACREAGE 68

OIL & GAS ROYALTY OWNER _____ LEASE ACREAGE 68
LEASE NO. _____

PRODUCING FORMATION BIG INJUN TOTAL DEPTH 2245

WELL OPERATOR BEECHLICK O.I, INC. DESIGNATED AGENT Lowell P BEE

ADDRESS RT 3 BOX 26 ADDRESS RT 3 BOX 62

SALEM, WV 26426 SALEM, WV 26426

JUL 21 1992