


RECEIVED
 Division of
 Environmental Protection
 29 93
 Submitting
 of Oil & Gas

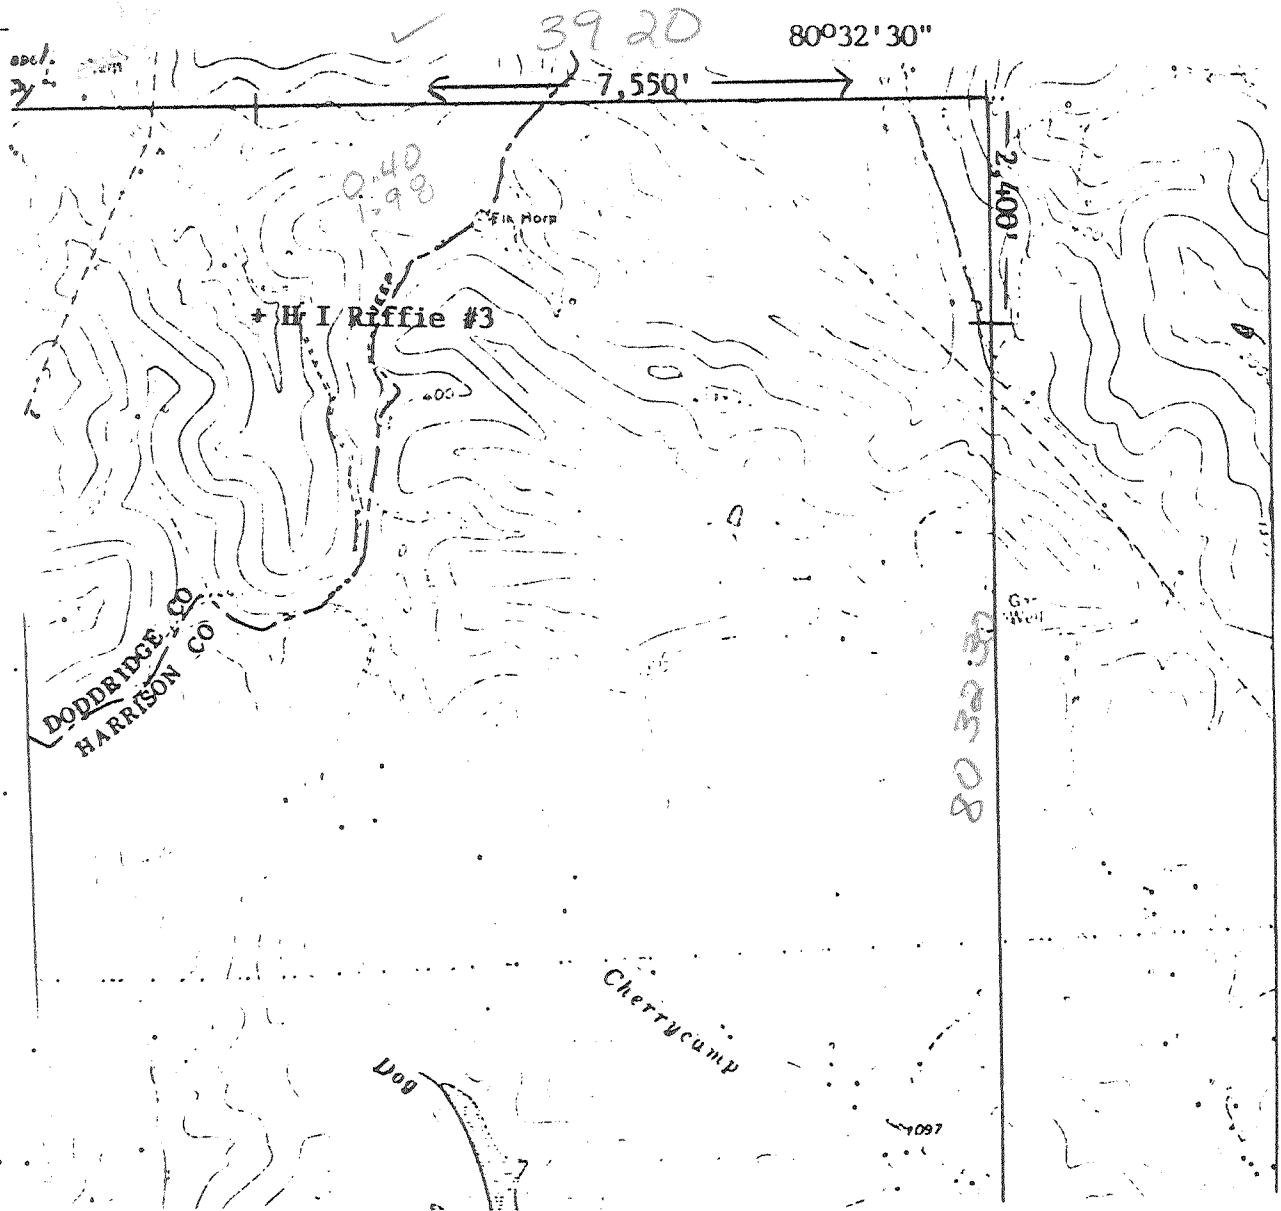

I, the undersigned, hereby certify that this plat is correct to the best of my knowledge and belief.

SIGNED Thomas J. Flubarty
 TITLE President

17506

calc 15' loc
 0.405
 4.21W

DATE June 21, 19 93
 OPERATORS WELL NO. #3
 API WELL NO. 017-4026-N

STATE OF WEST VIRGINIA
 DEPARTMENT OF ENERGY
 OIL AND GAS DIVISION

WELL TYPE: OIL GAS LIQUID INJECTION _____ WASTE DISPOSAL _____
 IE "GAS" PRODUCTION STORAGE _____ DEEP _____ SHALLOW

LOCATION: ELEVATION 980' WATER SHED Trib. of Robinson Fork
 DISTRICT McClelland COUNTY Doddridge
 QUADRANGLE Salem S45 Centerpoint SE

SURFACE OWNER Unknown At This Time = UATT ACREAGE UATT

OIL & GAS ROYALTY OWNER H I Riffie LEASE ACREAGE UATT
 LEASE NO. UATT

JUL 2 1993

PRODUCING FORMATION Big Injun TOTAL DEPTH UATT

WELL OPERATOR Flubarty Enterprises, Inc. DESIGNATED AGENT Thomas J. Flubarty
 ADDRESS P. O. Box 226 ADDRESS P. O. Box 226
Salem, WV 26426 Salem, WV 26426

STATE OF WEST VIRGINIA
DIVISION OF ENVIRONMENTAL PROTECTION
SECTION OF OIL AND GAS

WELL REGISTER ASSIGNMENT

This API Number 47- 17-04026, issued to FLUHARTY ENTERPRISES, INC. is evidence of permission to operate the well that is referenced at the location described on the attached plat, subject to the provisions of Chapters 22 and 22B of the West Virginia Code of 1931, as amended, and all rules and regulations promulgated thereunder. The name and telephone number of the Oil and Gas Inspector for this well is MIKE UNDERWOOD -
304-782-1043.

Spills or emergency discharges must be reported to 1-800-654-3312.

Failure to abide by all statutory and regulatory provisions governing all duties and operations hereunder may result in suspension or revocation of your permits and in addition may result in civil and/or criminal penalties.

The enclosed WR-35 must be completed by you and returned to this office. In addition annual production reports must be submitted on this well and failure to do so may require you to plug the well.

Theodore M. Streit
Chief

By: 

Title: _____

Operator's Well No: H.I. RIFFLE #3

Farm Name:

API Well Number : 47- 17-04026 N

Date Issued : 06/30/93