


6775'  
LATITUDE 39° 15' 00"

LONGITUDE 80° 35' 00"

0546

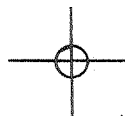

4208

1.79S = 7.5'  
1.28W  
1.79S = 15'  
1.28W

16943

NURRIH

(+) DENOTES LOCATION OF WELL ON UNITED STATES TOPOGRAPHIC MAPS

FILE NO. _____ DRAWING NO. _____ SCALE _____ MINIMUM DEGREE OF ACCURACY _____ PROVEN SOURCE OF ELEVATION _____ _____	I THE UNDERSIGNED, HEREBY CERTIFY THAT THIS PLAT IS CORRECT TO THE BEST OF MY KNOWLEDGE AND BELIEF AND SHOWS ALL THE INFORMATION REQUIRED BY LAW AND THE REGULATIONS ISSUED AND PRESCRIBED BY THE DEPARTMENT OF ENERGY. (SIGNED) _____ R.P.E. _____ L.L.S. _____	PLACE SEAL HERE
---	--	-----------------

STATE OF WEST VIRGINIA  
DEPARTMENT OF ENERGY  
OIL AND GAS DIVISION



DATE 2/17/93, 19\_\_\_\_  
OPERATOR'S WELL NO. 4208  
API WELL NO. \_\_\_\_\_

WELL TYPE: OIL  GAS \_\_\_\_\_ LIQUID INJECTION \_\_\_\_\_ WASTE DISPOSAL \_\_\_\_\_  
(IF "GAS,") PRODUCTION \_\_\_\_\_ STORAGE \_\_\_\_\_ DEEP \_\_\_\_\_ SHALLOW \_\_\_\_\_

LOCATION: ELEVATION \_\_\_\_\_ WATER SHED INDIAN FORK  
DISTRICT GREENBRIER COUNTY Dodderidge  
QUADRANGLE BIG ISSAC (25 VADIS (NC) 15'

SURFACE OWNER W. V. ROSS ACREAGE 13.2  
OIL & GAS ROYALTY OWNER \_\_\_\_\_ LEASE ACREAGE \_\_\_\_\_


PROPOSED WORK: DRILL \_\_\_\_\_ CONVERT \_\_\_\_\_ DRILL DEEPER \_\_\_\_\_ REDRILL \_\_\_\_\_ FRACTURE OR  
STIMULATE \_\_\_\_\_ PLUG OFF OLD FORMATION \_\_\_\_\_ PERFORATE NEW  
FORMATION \_\_\_\_\_ OTHER PHYSICAL CHANGE IN WELL (SPECIFY) \_\_\_\_\_

PLUG AND ABANDON \_\_\_\_\_ CLEAN OUT AND REPLUG \_\_\_\_\_  
TARGET FORMATION GORDON ESTIMATED DEPTH 2828  
WELL OPERATOR EQUITRANS INC. DESIGNATED AGENT JOHN G. KALAFAT  
ADDRESS 3508 PARK LANE ADDRESS \_\_\_\_\_  
Pittsburgh PA 15275

COUNTY NAME

PERMIT

16160

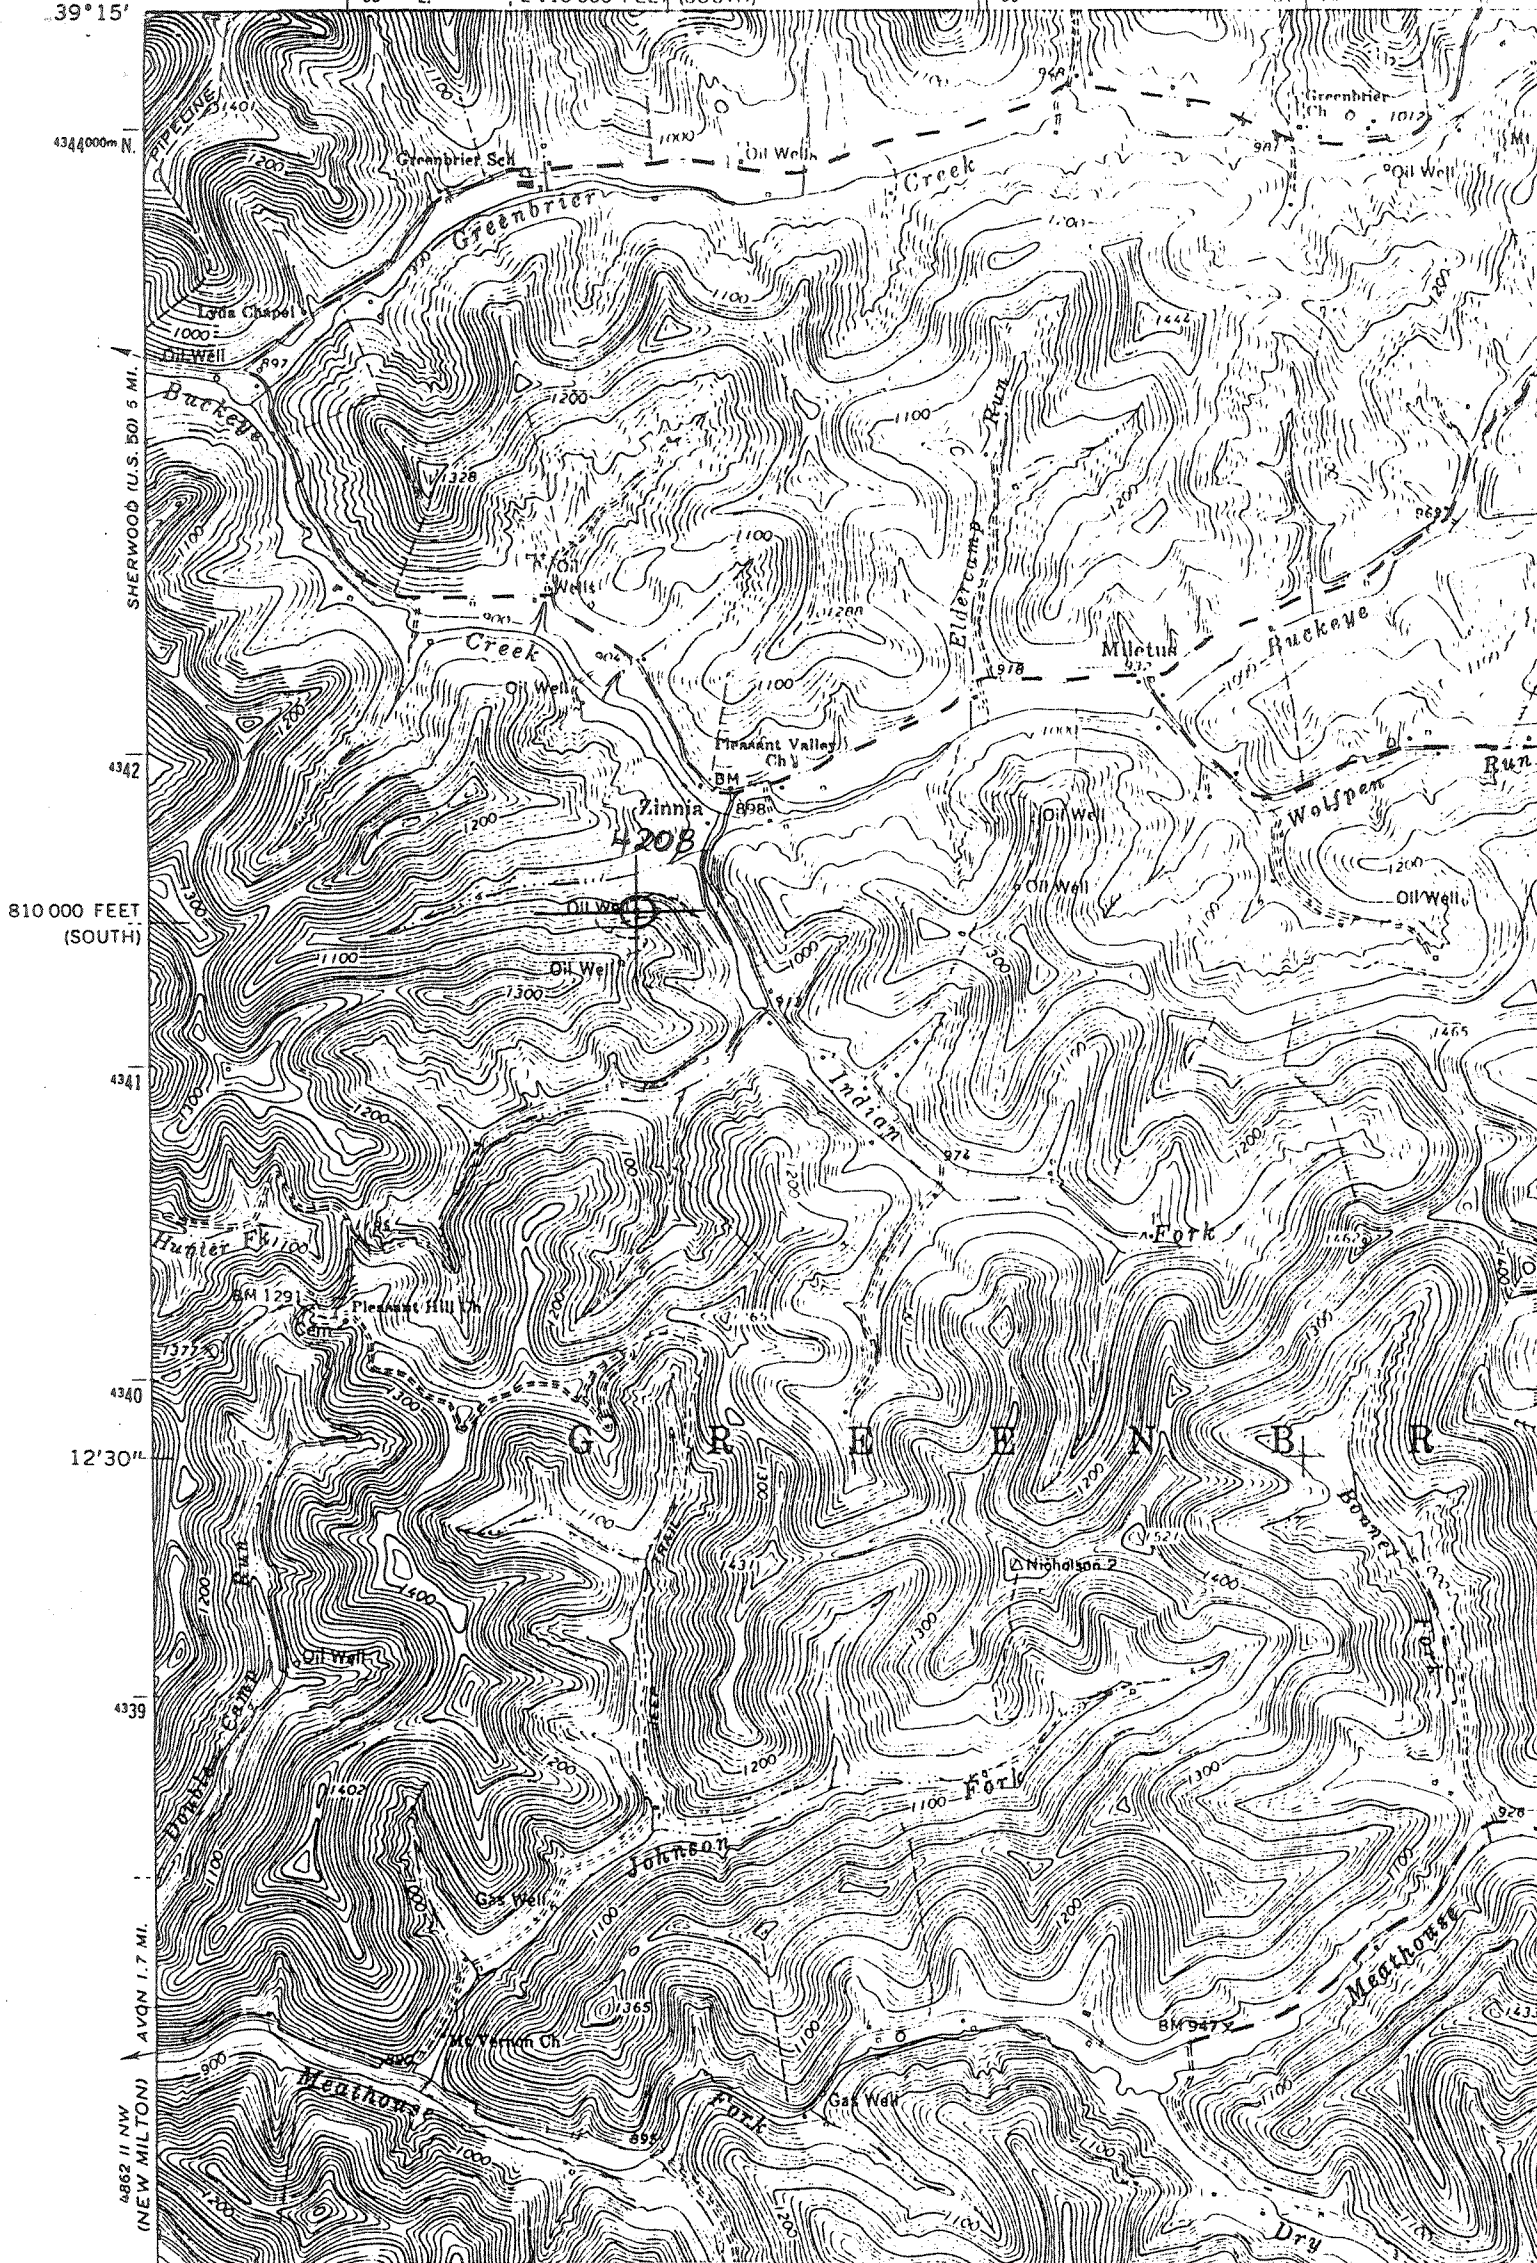

Big ISSAC 7.5  
Well #4208  
Equitrans Inc,  
017-4076-N



STATE OF WEST VIRGINIA  
DIVISION OF ENVIRONMENTAL PROTECTION  
SECTION OF OIL AND GAS

WELL REGISTER ASSIGNMENT

This API Number 47- 17-04076, issued to EQUITRANS, INC. is evidence of permission to operate the well that is referenced at the location described on the attached plat, subject to the provisions of Chapters 22 and 22B of the West Virginia Code of 1931, as amended, and all rules and regulations promulgated thereunder. The name and telephone number of the Oil and Gas Inspector for this well is MIKE UNDERWOOD - 304-782-1043.

Spills or emergency discharges must be reported to 1-800-654-3312.

Failure to abide by all statutory and regulatory provisions governing all duties and operations hereunder may result in suspension or revocation of your permits and in addition may result in civil and/or criminal penalties.

The enclosed WR-35 must be completed by you and returned to this office. In addition annual production reports must be submitted on this well and failure to do so may require you to plug the well.

Theodore M. Streit  
Chief

By: TLL r AB

Title: \_\_\_\_\_

Operator's Well No: 4208

Farm Name: ROSS, W. V.

API Well Number : 47- 17-04076 N

Date Issued : 12/07/93