

STATE OF WEST VIRGINIA  
DIVISION OF ENVIRONMENTAL PROTECTION  
SECTION OF OIL AND GAS

WELL REGISTER ASSIGNMENT

This API Number 47- 17-04089, issued to FLUHARTY ENTERPRISES, INC. is evidence of permission to operate the well that is referenced at the location described on the attached plat, subject to the provisions of Chapters 22 and 22B of the West Virginia Code of 1931, as amended, and all rules and regulations promulgated thereunder. The name and telephone number of the Oil and Gas Inspector for this well is MIKE UNDERWOOD - 304-782-1043.

Spills or emergency discharges must be reported to 1-800-654-3312.

Failure to abide by all statutory and regulatory provisions governing all duties and operations hereunder may result in suspension or revocation of your permits and in addition may result in civil and/or criminal penalties.

The enclosed WR-35 must be completed by you and returned to this office. In addition annual production reports must be submitted on this well and failure to do so may require you to plug the well.

Theodore M. Streit  
Chief

By: 


Title: \_\_\_\_\_

Operator's Well No: T. S. CHIPPS 1

Farm Name:

API Well Number : 47- 17-04089 N

Date Issued : 01/27/94

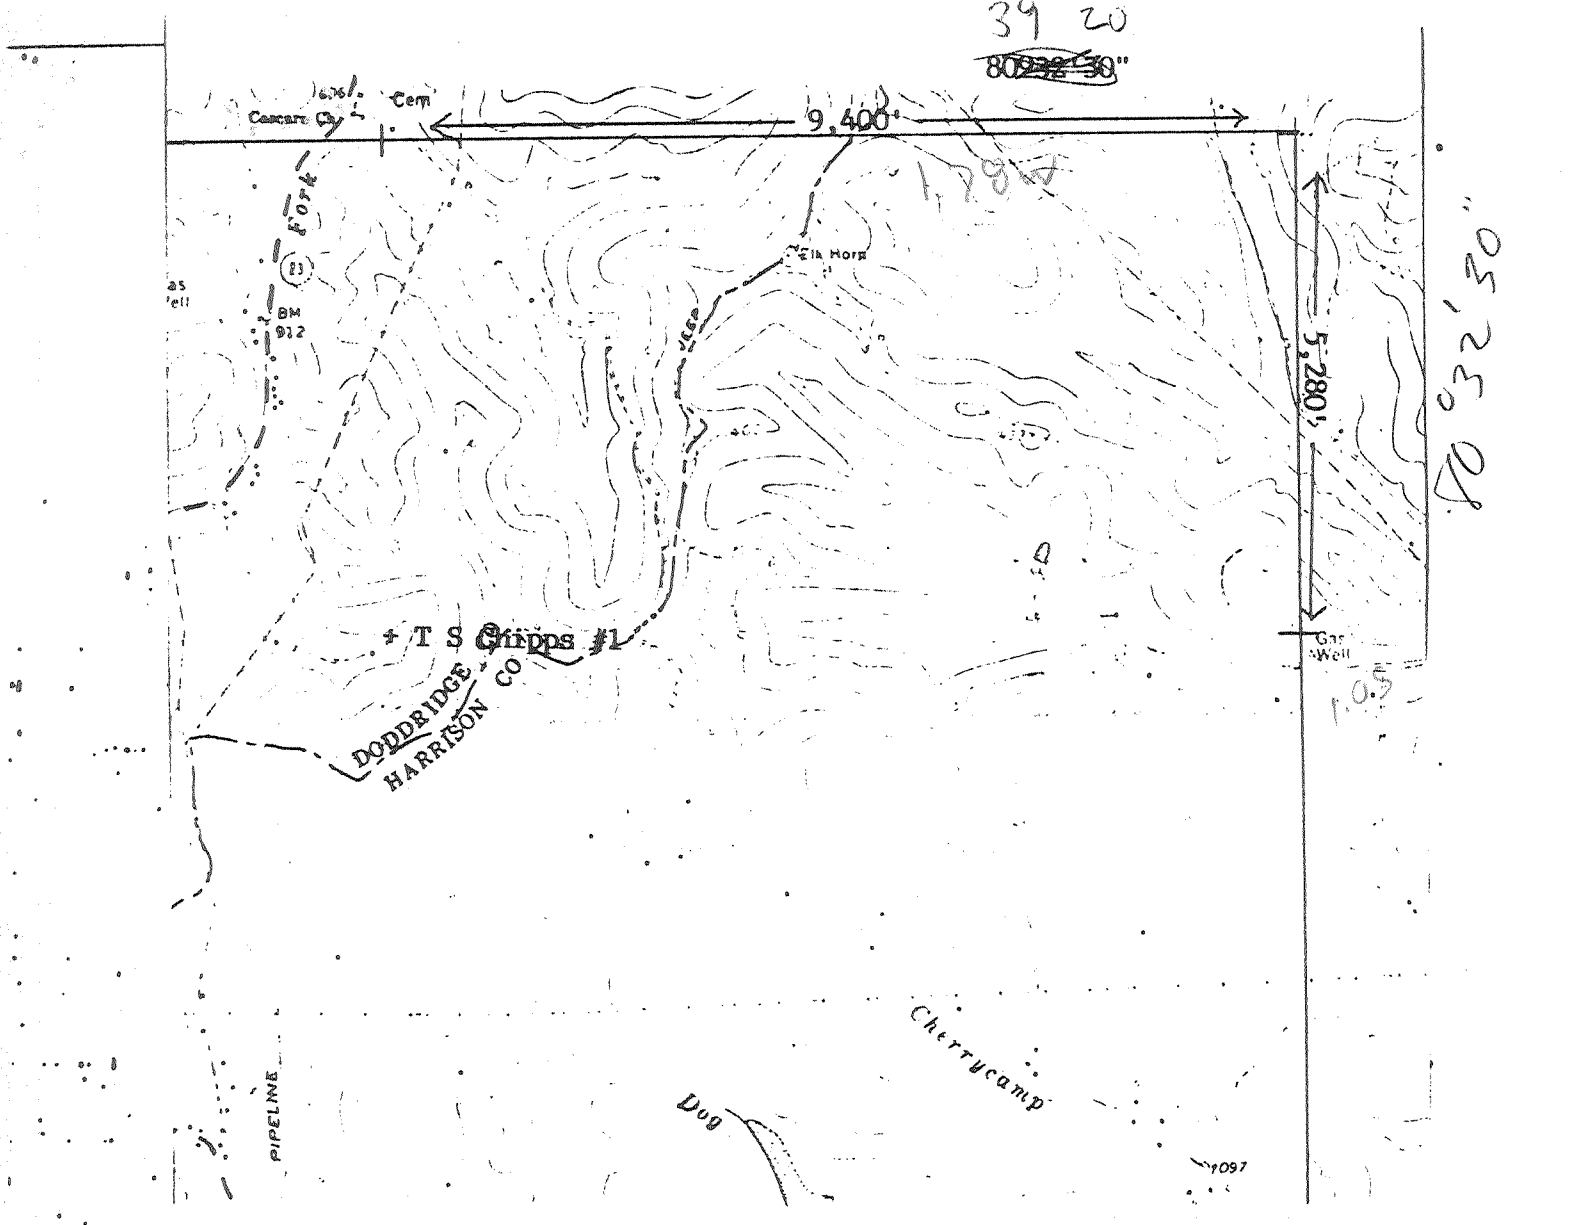

I, the undersigned, hereby certify that this plat is correct to the best of my knowledge and belief.

SIGNED Thomas J. Fluharty  
 TITLE President

**RECEIVED**

WV Division of Environmental Protection  
 JUN 29 1993  
 Permitting  
 Bureau of Oil & Gas

calc 15' loc  
 1.005  
 4.01W

DATE June 21, 1993  
 OPERATORS WELL NO. #1  
 API WELL NO. 017-4089-A

STATE OF WEST VIRGINIA  
 DEPARTMENT OF ENERGY  
 OIL AND GAS DIVISION

WELL TYPE: OIL  GAS  LIQUID INJECTION \_\_\_\_\_ WASTE DISPOSAL \_\_\_\_\_  
 IE "GAS" PRODUCTION  STORAGE \_\_\_\_\_ DEEP \_\_\_\_\_ SHALLOW

LOCATION: ELEVATION 1,060' WATER SHED Robinson Fork  
 DISTRICT McClelland COUNTY Doddridge  
 QUADRANGLE Salem 596 Centerpoint SE

SURFACE OWNER Unknown At This Time = UATT ACREAGE UATT

OIL & GAS ROYALTY OWNER T S Chippis LEASE ACREAGE UATT  
 LEASE NO. UATT

PRODUCING FORMATION Big Injun TOTAL DEPTH UATT

WELL OPERATOR Fluharty Enterprises, Inc. DESIGNATED AGENT Thomas J. Fluharty

ADDRESS P. O. Box 226 ADDRESS P. O. Box 226  
Salem, WV 26426 Salem, WV 26426

17507